
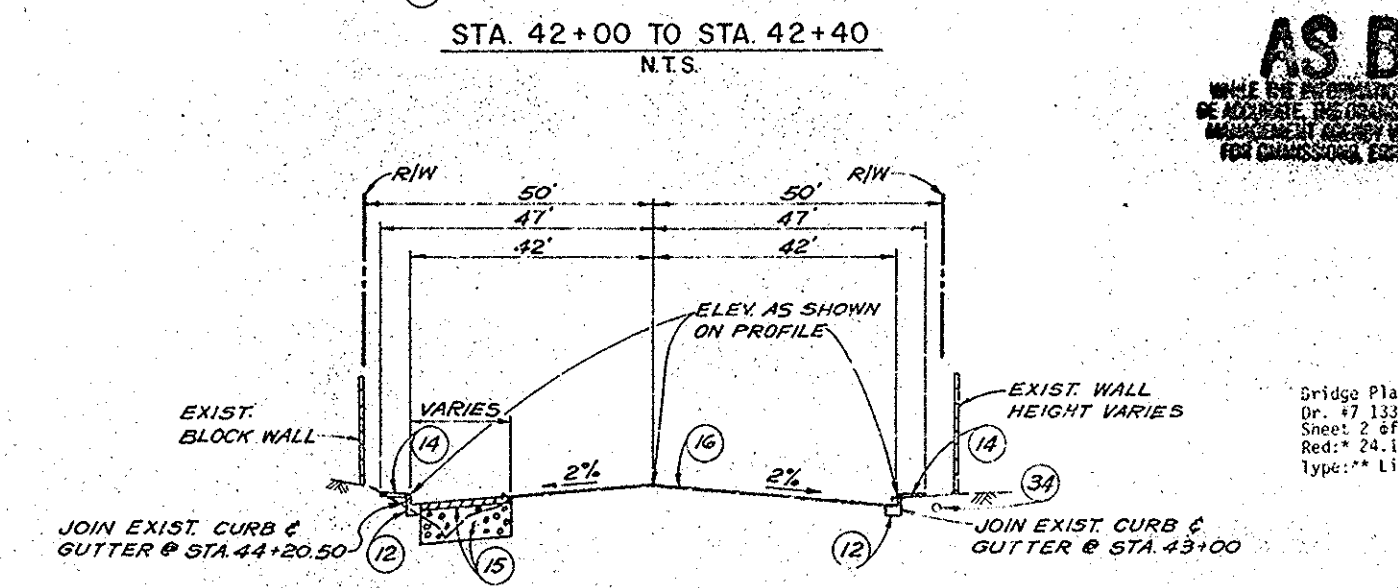
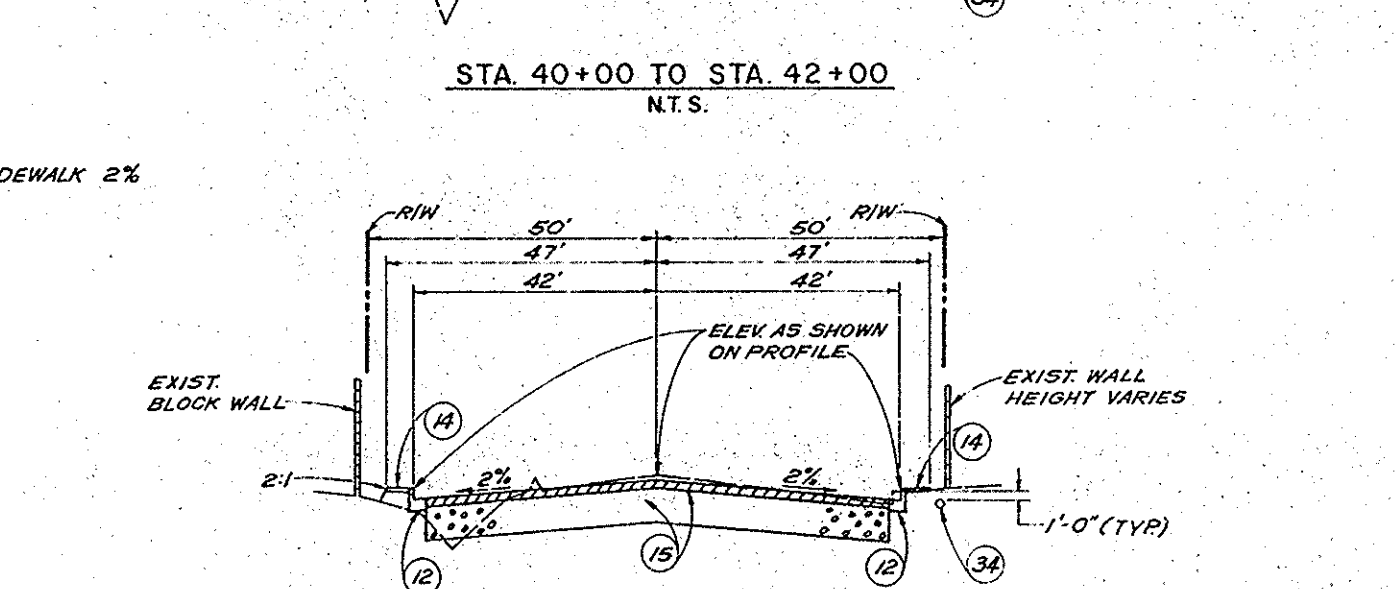
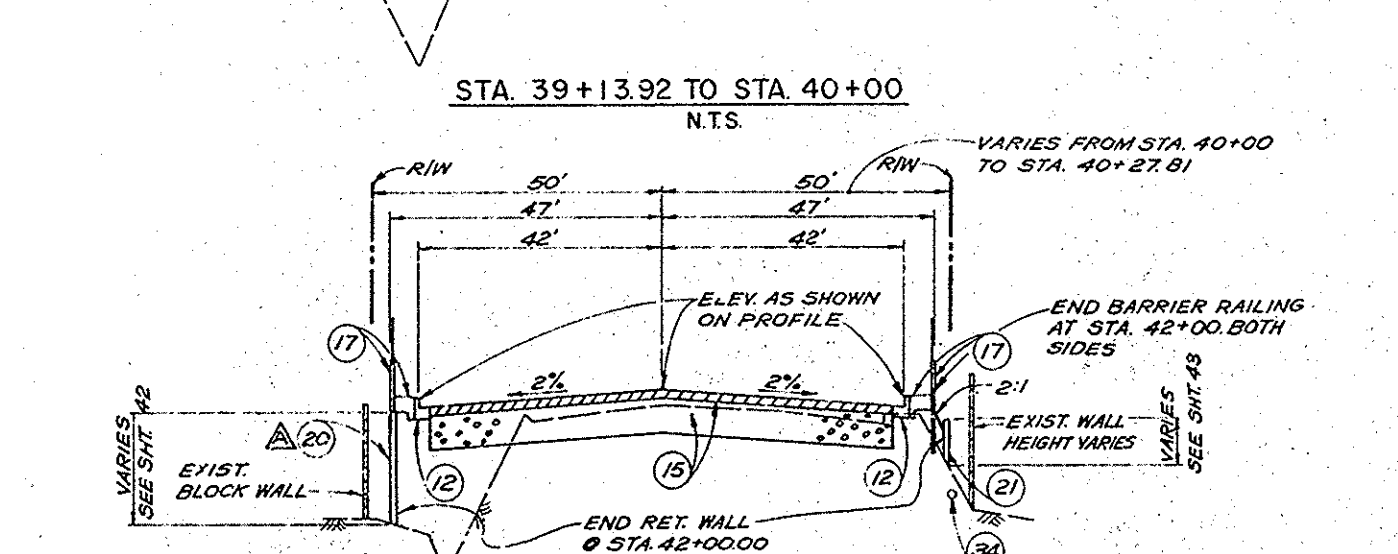
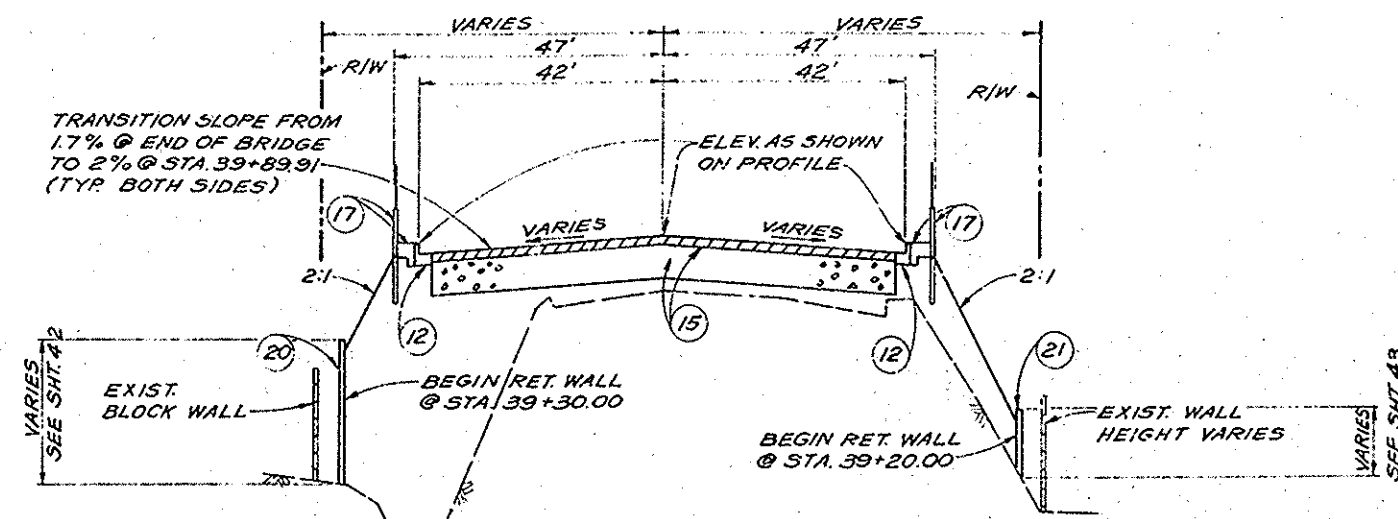
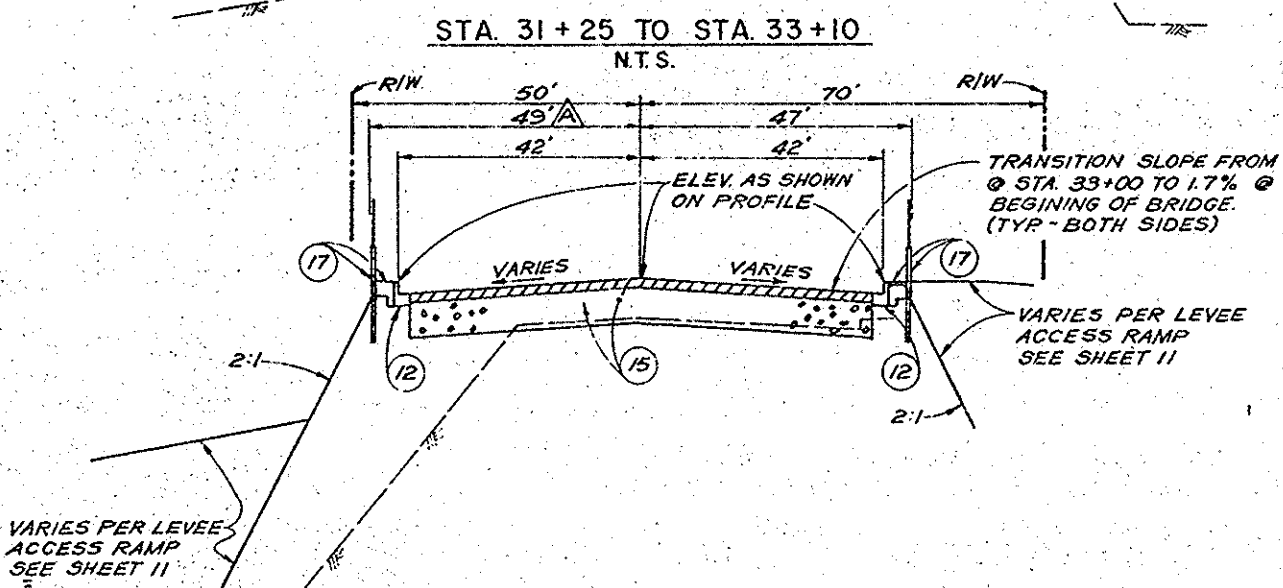
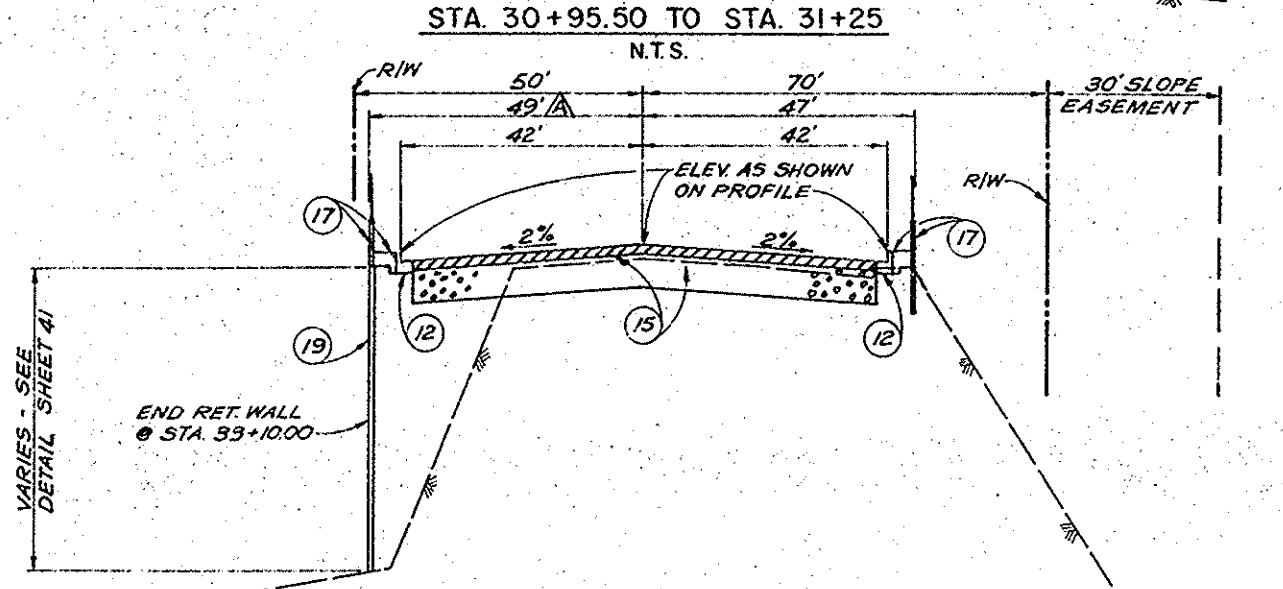
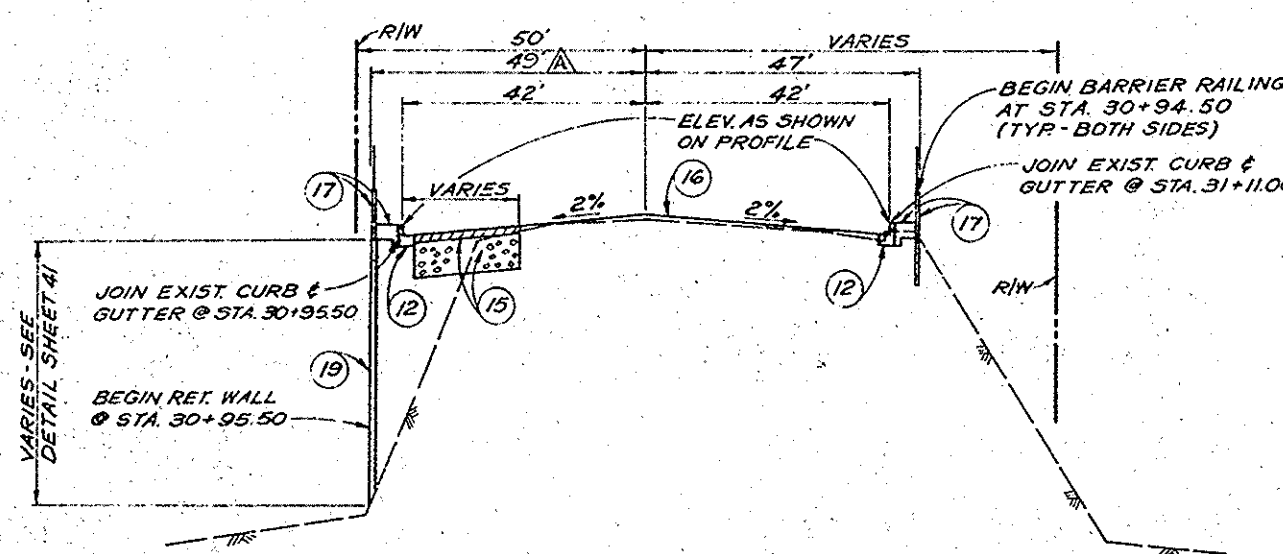


13329

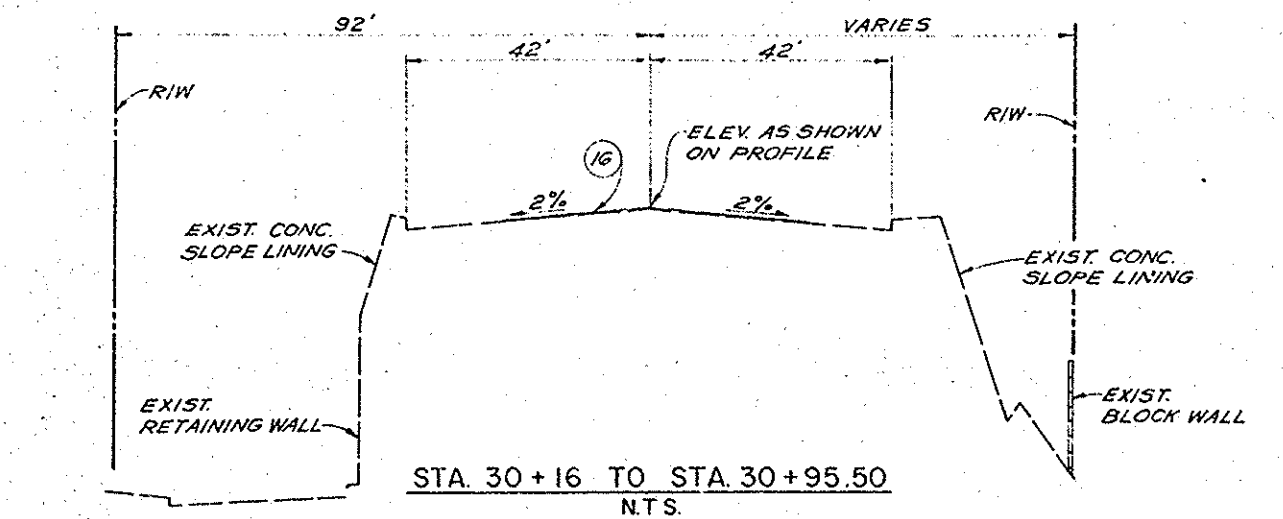

NOTE:
SLOPE SIDEWALK 2%

AS BUILT
WHILE THE CONTRACTOR IS BELIEVED TO BE ACCURATE, THE ENGINEER'S COUNTY ENVIRONMENTAL MANAGEMENT DIVISION WILL NOT BE RESPONSIBLE FOR OMISSIONS, ERRORS, OR INACCURACIES.

Bridge Plans
Dr. 47 13329
Sheet 2 of 53
Red: 24.1
Type: Linen

LEGEND:

- 3" G EXISTING GAS LINE (SIZE AS INDICATED)
- 8" S EXISTING SEWER PIPE (SIZE AS INDICATED)
- 48" SD EXISTING STORM DRAIN (SIZE AS INDICATED)
- C EXISTING COMMUNICATION CABLE
- 4" W EXISTING WATER LINE (SIZE AS INDICATED)
- MANHOLE VAULT EXISTING MANHOLE/VAULT
- VALVE EXISTING VALVE
- ANCHOR GUY WIRE EXISTING ANCHOR/GUY WIRE
- FENCE EXISTING FENCE (TYPE AS INDICATED)
- CURB & GUTTER EXISTING CURB & GUTTER
- BLOCK WALL EXISTING BLOCK WALL
- EDGE OF PAVEMENT
- RIGHT OF WAY/CITY BOUNDARY
- TRAFFIC SIGN-REFL. PADDLE (EXIST)
- LIGHT STANDARD (L.S.)-EXIST
- POWER POLE (EXIST)
- EXISTING TREE
- EXISTING SPRINKLER RISER
- ABANDONED
- ASPHALT CONCRETE
- CATCH BASIN
- CORRUGATED METAL PIPE
- CONCRETE
- DRIVEWAY
- ELEV. ELEVATION
- F.L. FLOW LINE
- F.M.S. FORCE MAIN SEWER
- FUT. FUTURE
- HDWL. HEADWALL
- INV. INVERT
- IRR. IRRIGATION WATER LINE
- M.H. MANHOLE
- PVMT. PAVEMENT
- R.C.B. REINFORCED CONCRETE BOX
- R.C.P. REINFORCED CONCRETE PIPE
- S. SLOPE IN FEET PER FOOT
- SPEC'S SPECIFICATIONS
- STA. STATION
- STD. STANDARD
- V.C.P. VITRIFIED CLAY PIPE
- VENOTES DETAIL NUMBER
- 2 DENOTES DETAIL NUMBER
- NTS. NOT TO SCALE
- EXISTING POWER POLE & STREET LIGHT
- NEW STREET LIGHT

CONSTRUCTION NOTES:

- 12 CONSTRUCT TYPE A-2 CURB PER STD. PLAN 202
- 14 CONSTRUCT 5' SIDEWALK PER STD. PLAN 205
- 15 CONSTRUCT 0.35' A.C. PAVEMENT OVER 1.5' A.B.
- 16 PLACE A.C. SURFACE COAT OVER EXISTING A.C. PAVEMENT
- 17 CONSTRUCT TYPE HA BARRIER RAILING AND MODIFIED SIDEWALK PER DETAILS ON SHEET 45 AND 46
- 19 CONSTRUCT REINFORCED CONCRETE RETAINING WALL PER DETAIL ON SHEET 41
- 20 CONSTRUCT REINFORCED CONCRETE RETAINING WALL PER DETAIL ON SHEET 42
- 21 CONSTRUCT REINFORCED CONCRETE RETAINING WALL PER DETAIL ON SHEET 43
- 34 CONSTRUCT 4" ABS DUCT FOR FUTURE CITY OF COSTA MESA SPRINKLERS SEE SHEET 43

1 1/2 0 1 2
3 inches on original drawing

ORANGE COUNTY ENVIRONMENTAL MANAGEMENT AGENCY	
ADAMS AVENUE WIDENING	
LEGEND & TYPICAL SECTIONS	
4-30 As Built	59
MARK DATE DESCRIPTION	PREPARED UNDER SUPERVISION OF <i>Carl J. Taylor</i>
REVISIONS	RCE 6654 DATE
DESIGNED: R.B.B.	SCALE DATE
DRAWN: A.C.B.	CHECKED: S.A.C. AS SHOWN APRIL 1977
SHEET 2 OF 53	

DR#7 13329