


13329

DATE	INITIAL
DESIGNED	
DRAWN	
CHECKED	
APPROVED	

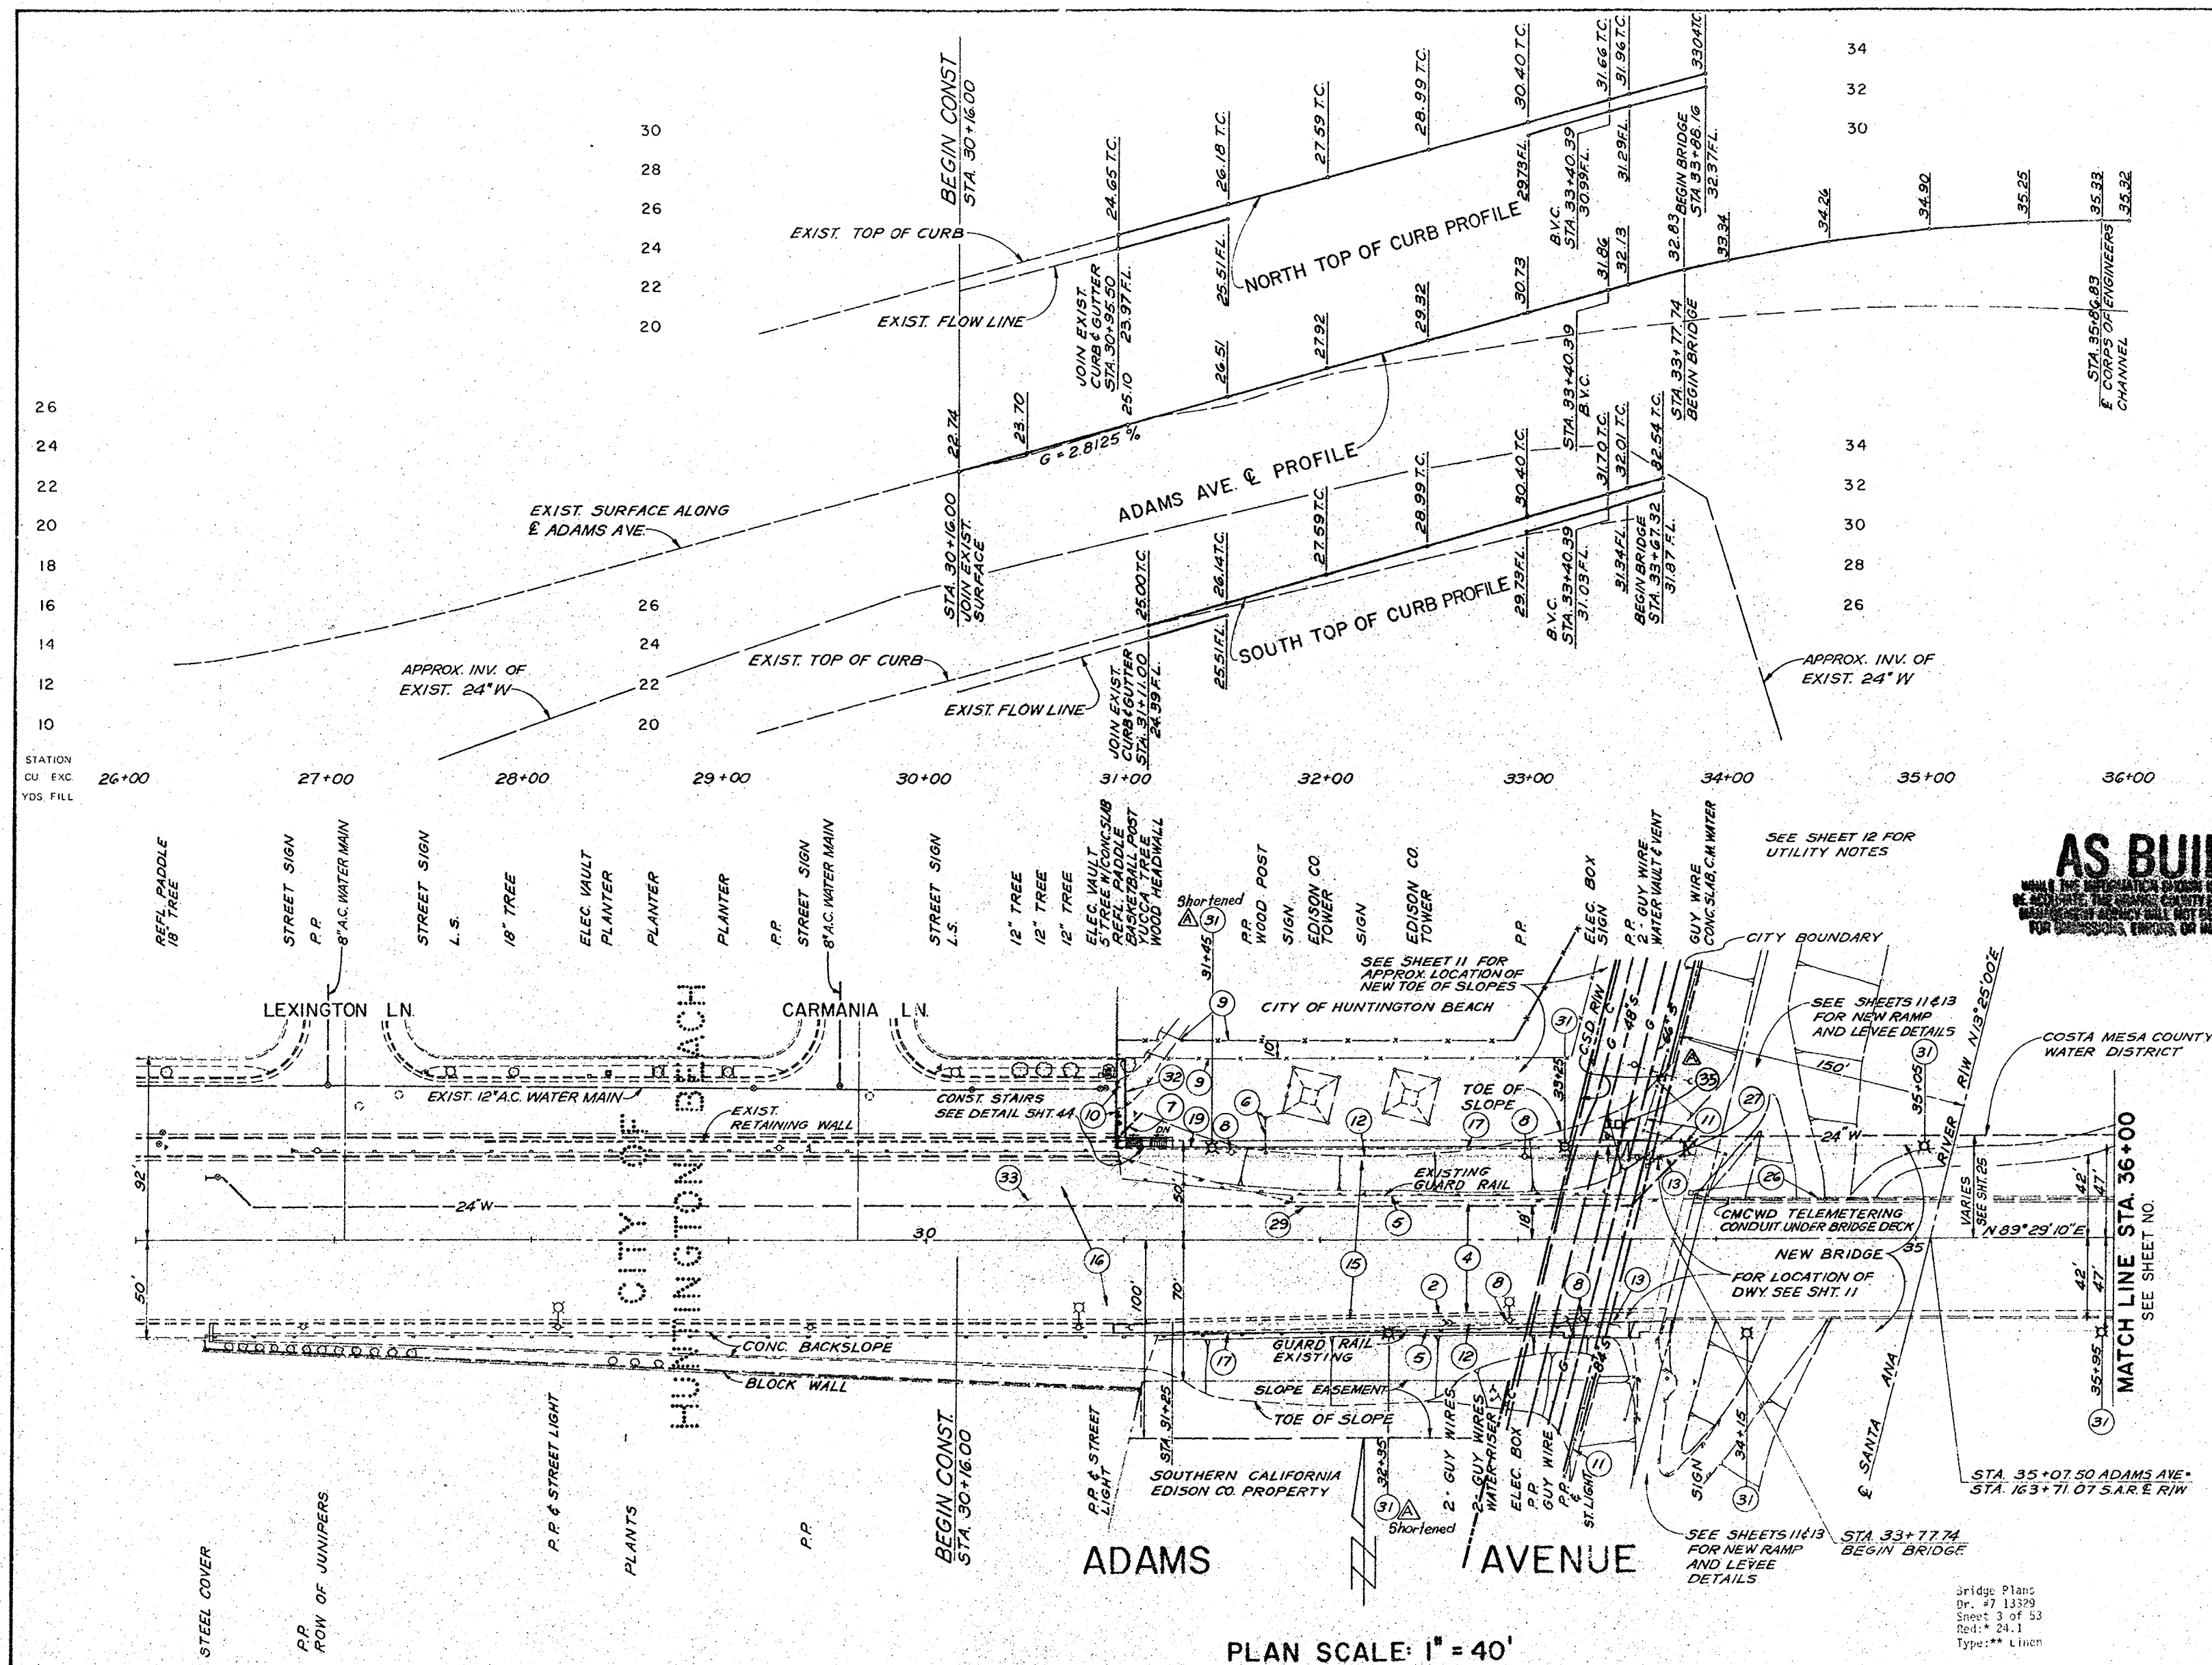

- CONSTRUCTION NOTES**
ADAMS AVENUE WIDENING
1. REMOVE 505± L.F. OF EXISTING A.C. BERM - EAST OF BRIDGE
 2. REMOVE 265± L.F. OF EXISTING CURB & GUTTER AND SIDEWALK WEST OF BRIDGE
 3. REMOVE 395± L.F. OF EXISTING CURB & GUTTER AND SIDEWALK EAST OF BRIDGE
 4. REMOVE EXISTING A.C. PAVING & BASE
 5. REMOVE EXISTING GUARD RAIL
 6. REMOVE EXISTING POST & CABLE BARRICADE
 7. REMOVE EXISTING WOOD RETAINING WALL
 8. EXISTING POWER POLE AND/OR GUY TO BE RE-LOCATED BY OTHERS
 9. RELOCATE EXISTING FENCE AND GATE 10' NORTH
 10. REMOVE EXISTING BARRICADE
 11. REMOVE EXISTING CHAIN LINK FENCE
 12. CONSTRUCT TYPE A-2 CURB PER STD. PLAN 202
 13. CONSTRUCT DEPRESSED CURB DRIVEWAY, W=28' PER STD. PLAN 209
 14. CONSTRUCT 5' SIDEWALK PER STD. PLAN 205
 15. CONSTRUCT 0.35' A.C. PAVEMENT OVER 1.5' A.B. PER TYPICAL SECTIONS, SHEET 2
 16. PLACE VARIABLE A.C. SURFACE COAT OVER EXISTING A.C. PAVEMENT
 17. CONSTRUCT TYPE 11A BARRIER RAILING AND MODIFIED SIDEWALK PER DETAILS ON SHEETS 45 & 46
 18. REMOVE 160± L.F. OF EXISTING CURB & GUTTER AND SIDEWALK BETWEEN EXIST. BRIDGES
 19. CONSTRUCT R.C. RETAINING WALL PER DETAIL ON SHEET 41
 20. CONSTRUCT R.C. RETAINING WALL PER DETAIL SHEET 42
 21. CONSTRUCT R.C. RETAINING WALL PER DETAIL SHEET 43
 22. EXTEND 48" DIA. SHAFT & ROTATE ECCENTRIC CONE TO PLACE STRAIGHT SIDE TO SOUTH
 23. TO BE RECONSTRUCTED BY COSTA MESA SANITARY DISTRICT
 24. TO BE MODIFIED BY COSTA MESA SANITARY DISTRICT
 25. ADJUST MANHOLE OR VALVE TO GRADE
 26. EXISTING CMWD TELEMETERING CONDUIT JUNCTION BOXES, ETC., TO BE ABANDONED AND REMOVED BY CONTRACTOR
 27. EXISTING CMWD AIR-VAC VALVE ASSEMBLY TO BE RELOCATED BY CMWD
 28. REMOVE EXISTING 36" CMP, SPILL PAD AND HEADWALL
 29. PROTECT IN PLACE
 30. REMOVE PLANTS & HEAVY BRUSH
 31. ELECTROLIER
 32. CONSTRUCT 4' WIDE 3" THICK A.C. WALK
 33. FEATHER EDGE
 34. CONSTRUCT 4" ABS DUCT FOR FUTURE CITY OF COSTA MESA SPRINKLERS. SEE SHEET 43
 35. NEW LOCATION OF CMWD AIR-VAC VALVE ASSEMBLY

1 1/2 0 1 2
3 inches on original drawing

ORANGE COUNTY ENVIRONMENTAL MANAGEMENT AGENCY			
ADAMS AVENUE WIDENING PLAN & PROFILE Sta. 30+15 to Sta. 36+00			
4-80 As Built	DATE	DESCRIPTION	REVISIONS
MARK	DATE	DESCRIPTION	REVISIONS
DESIGNED	DATE	DESCRIPTION	REVISIONS
DRAWN	DATE	DESCRIPTION	REVISIONS
CHECKED	DATE	DESCRIPTION	REVISIONS
APPROVED	DATE	DESCRIPTION	REVISIONS
SCALE: AS SHOWN			DATE: APRIL 1977
DWG. NO. S.A. 35-A			SHEET 3 OF 53

DR-7 13329