


12550
12550
12550

DATE	INITIAL
DESIGNED	
CHECKED	
APPROVED	

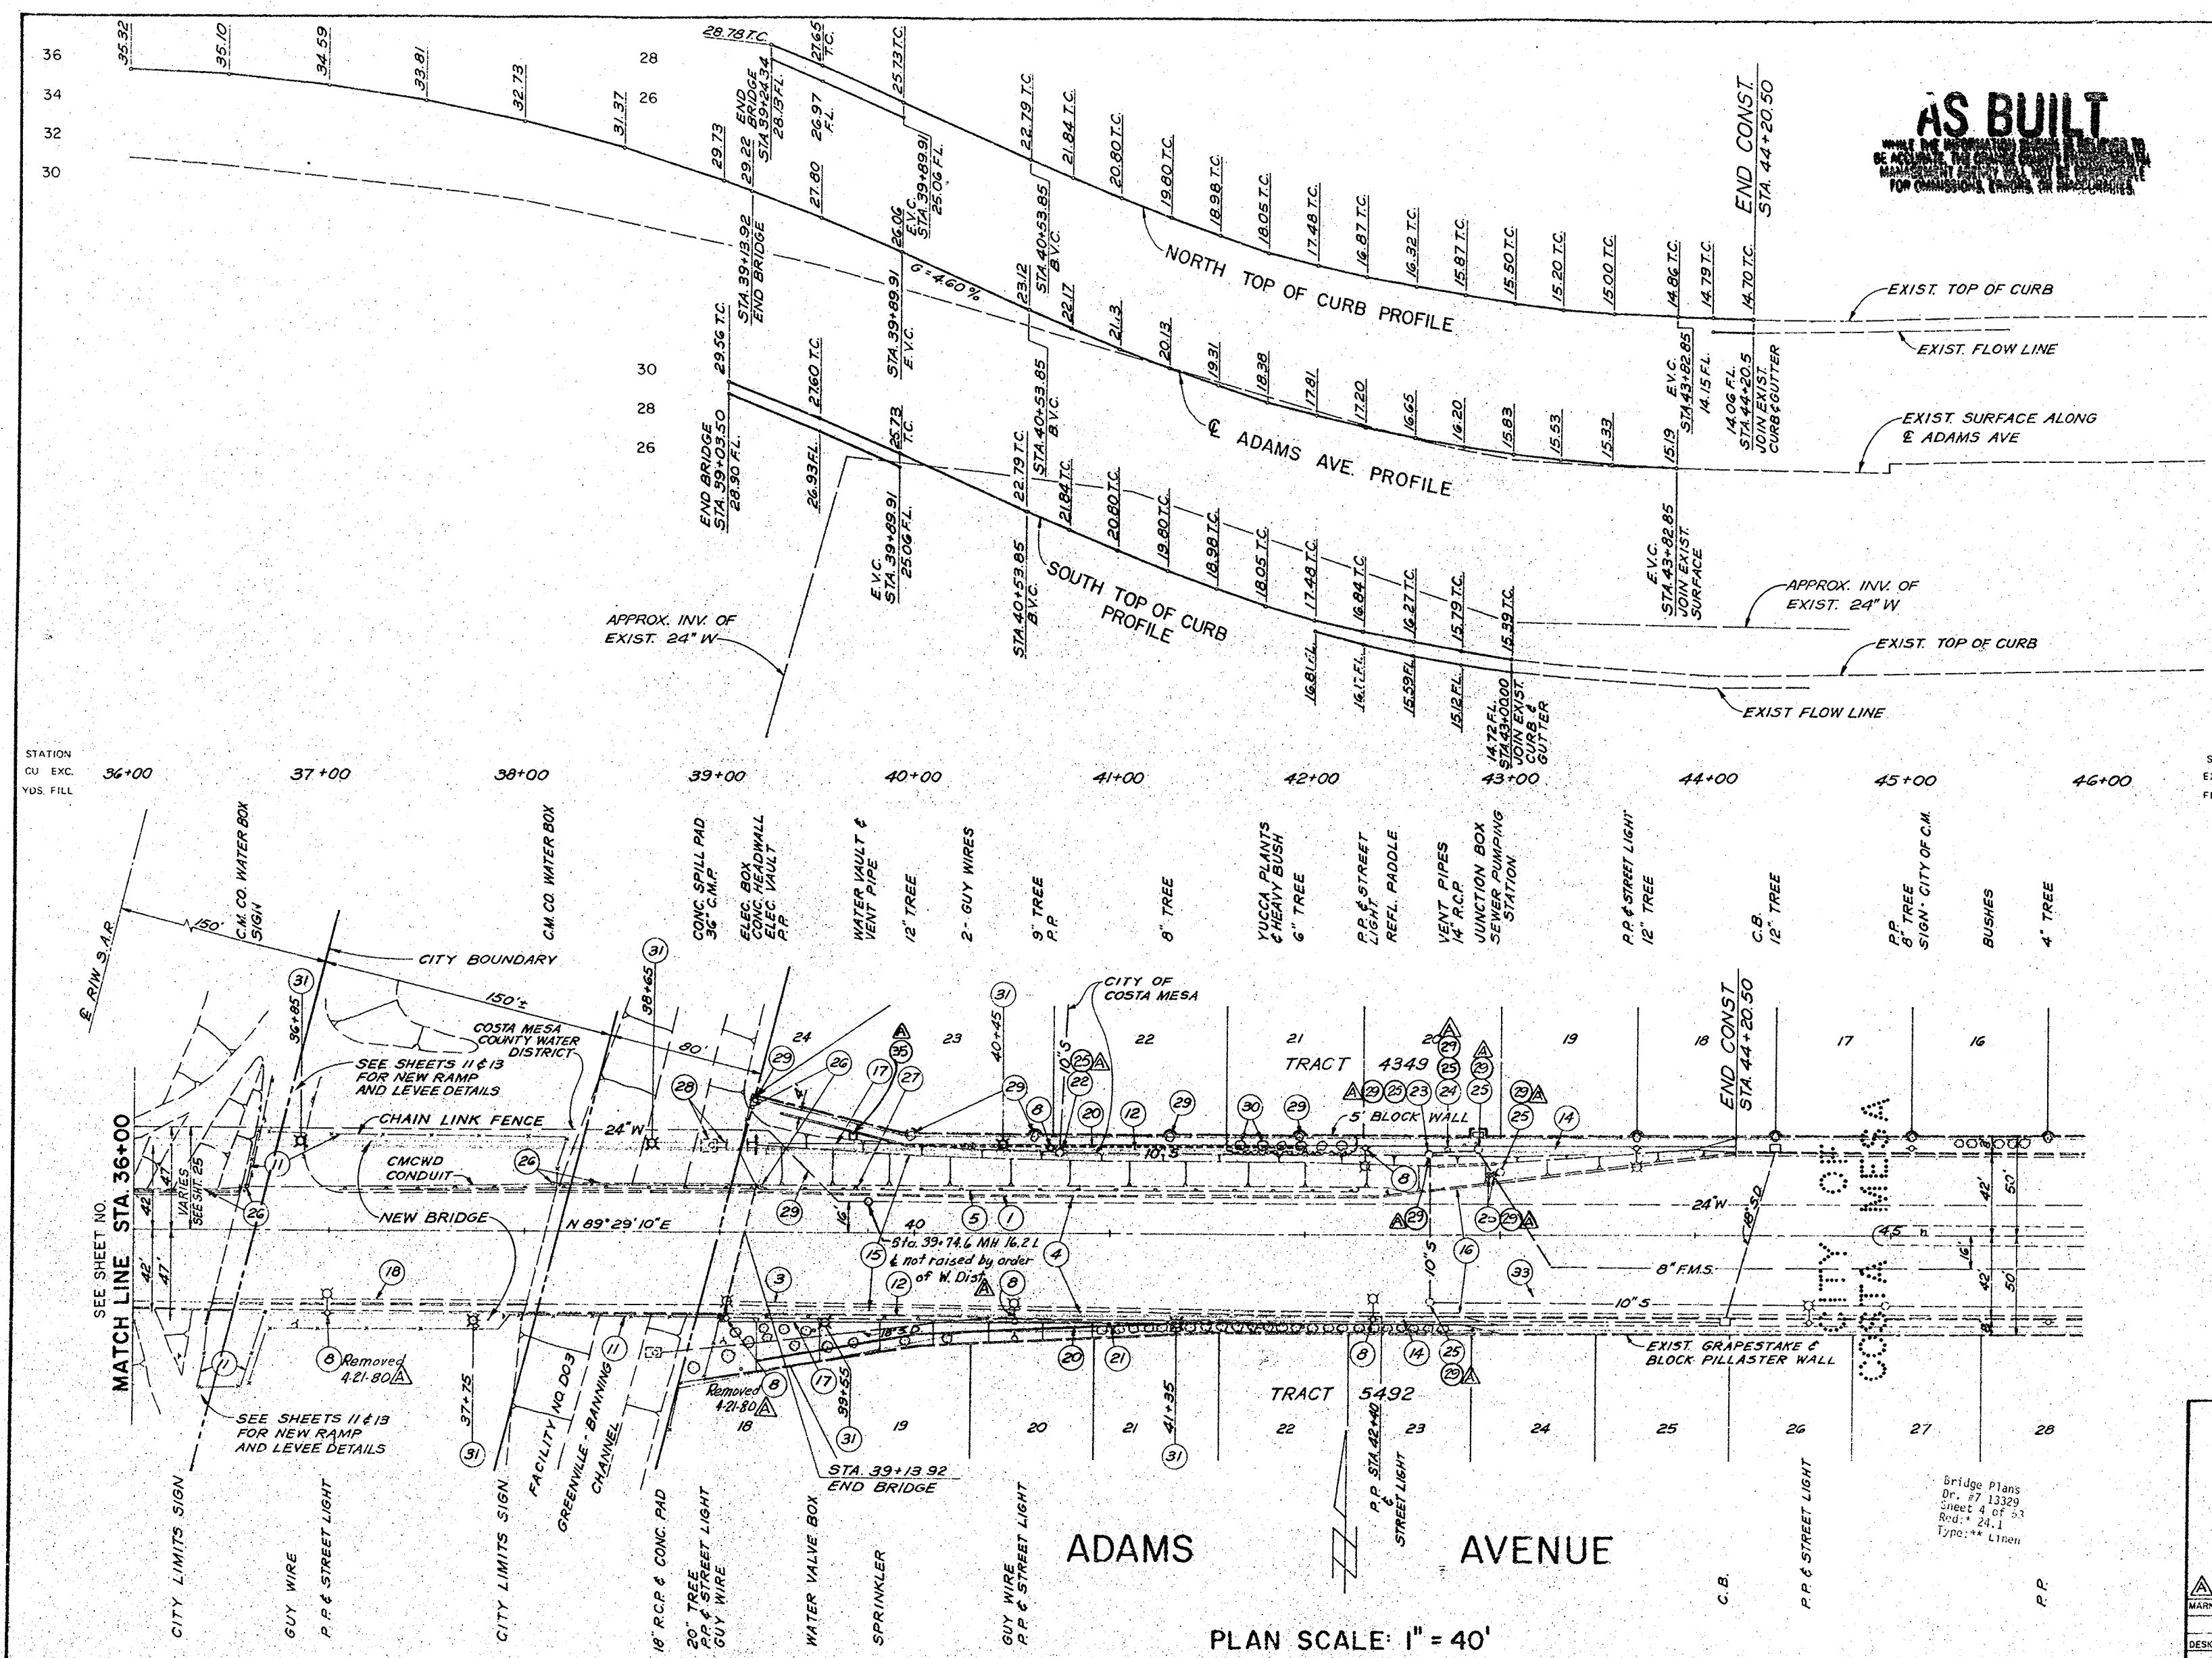

- CONSTRUCTION NOTES**
ADAMS AVENUE WIDENING
- 1 REMOVE 50± L.F. OF EXISTING A.C. BERM - EAST OF BRIDGE
 - 2 REMOVE 265± L.F. OF EXISTING CURB & GUTTER AND SIDEWALK - WEST OF BRIDGE
 - 3 REMOVE 395± L.F. OF EXISTING CURB & GUTTER AND SIDEWALK - EAST OF BRIDGE
 - 4 REMOVE EXISTING A.C. PAVING & BASE
 - 5 REMOVE EXISTING GUARD RAIL
 - 6 REMOVE EXISTING POST & CABLE BARRICADE
 - 7 REMOVE EXISTING WOOD RETAINING WALL
 - 8 EXISTING POWER POLE AND/OR GUY TO BE RE-LOCATED BY OTHERS
 - 9 RELOCATE EXISTING FENCE AND GATE 10' NORTH
 - 10 REMOVE EXISTING BARRICADE
 - 11 REMOVE EXISTING CHAIN LINK FENCE
 - 12 CONSTRUCT TYPE A-2 CURB PER STD. PLAN 202
 - 13 CONSTRUCT DEPRESSED CURB DRIVEWAY, W=28' PER STD. PLAN 209
 - 14 CONSTRUCT 5' SIDEWALK PER STD. PLAN 205
 - 15 CONSTRUCT 0.35' A.C. PAVEMENT OVER 1.5' A.B. PER TYPICAL SECTIONS, SHEET 2
 - 16 PLACE VARIABLE A.C. SURFACE COAT OVER EXISTING A.C. PAVEMENT
 - 17 CONSTRUCT TYPE 11A BARRIER RAILING AND MODIFIED SIDEWALK PER DETAILS ON SHEETS 45 & 46
 - 18 REMOVE 160± L.F. OF EXISTING CURB & GUTTER AND SIDEWALK BETWEEN EXIST. BRIDGES
 - 19 CONSTRUCT R.C. RETAINING WALL PER DETAIL ON SHEET 41
 - 20 CONSTRUCT R.C. RETAINING WALL PER DETAIL SHEET 42
 - 21 CONSTRUCT R.C. RETAINING WALL PER DETAIL SHEET 43
 - 22 EXTEND 48" DIA. SHAFT & ROTATE ECCENTRIC CONE TO PLACE STRAIGHT SIDE TO SOUTH
 - 23 TO BE RECONSTRUCTED BY COSTA MESA SANITARY DISTRICT
 - 24 TO BE MODIFIED BY COSTA MESA SANITARY DISTRICT
 - 25 ADJUST MANHOLE OR VALVE TO GRADE
 - 26 EXISTING CMCWD TELEMETERING CONDUIT, JUNCTION BOXES, ETC., TO BE ABANDONED AND REMOVED BY CONTRACTOR
 - 27 EXISTING CMCWD AIR-VAC VALVE ASSEMBLY TO BE RELOCATED BY CMCWD
 - 28 REMOVE EXISTING 36" CMP, SPILL PAD AND HEADWALL
 - 29 PROTECT IN PLACE
 - 30 REMOVE PLANTS & HEAVY BRUSH
 - 31 ELECTROLIER
 - 32 CONSTRUCT 4' WIDE 3" THICK A.C. WALK
 - 33 FEATHER EDGE
 - 34 CONSTRUCT 4" ABS DUCT FOR FUTURE CITY OF COSTA MESA SPRINKLERS. SEE SHEET 43
 - 35 NEW LOCATION OF CMCWD AIR-VAC VALVE ASSEMBLY

1 1/2 0 1 2
3 inches on original drawing

ORANGE COUNTY ENVIRONMENTAL MANAGEMENT AGENCY	
ADAMS AVENUE WIDENING PLAN & PROFILE Sta. 36+00 to Sta. 44+20	
4-80 As-Built 59	PREPARED UNDER SUPERVISION OF <i>Carl J. [Signature]</i>
REVISIONS	SCALE DATE DWG. NO. 4
DESIGNED: R.B.B.	AS SHOWN: APRIL 1971
DRAWN: A.S.B.	CHECKED: C.A.C.

DR 12550