
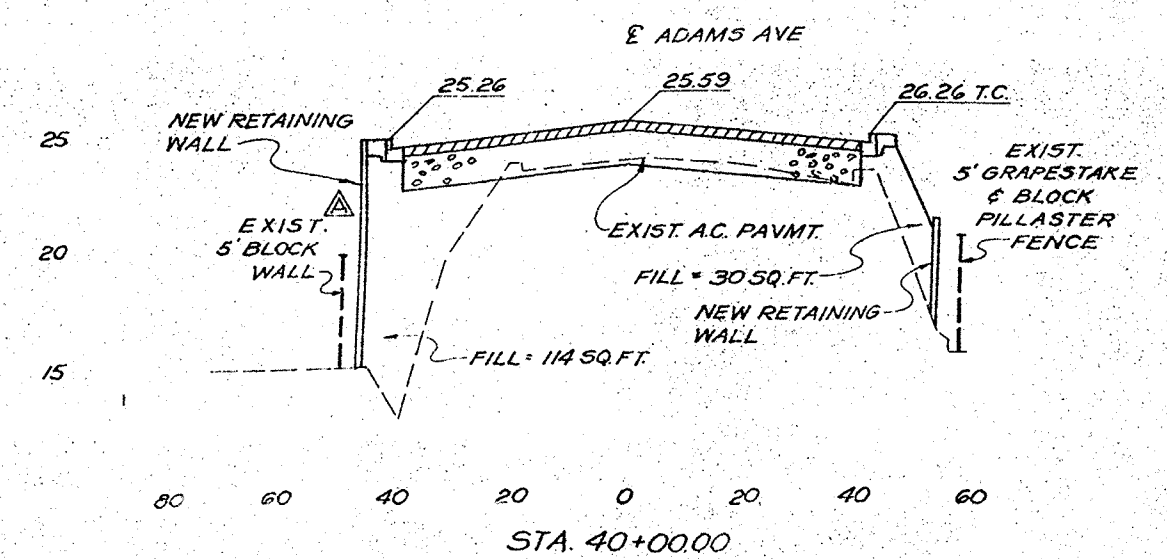
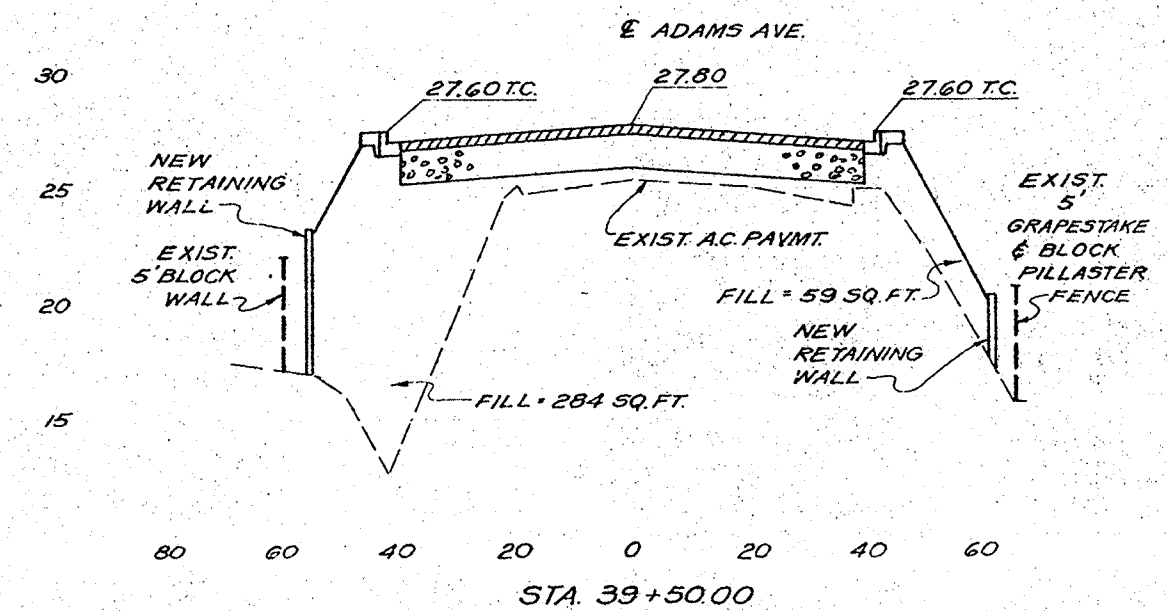
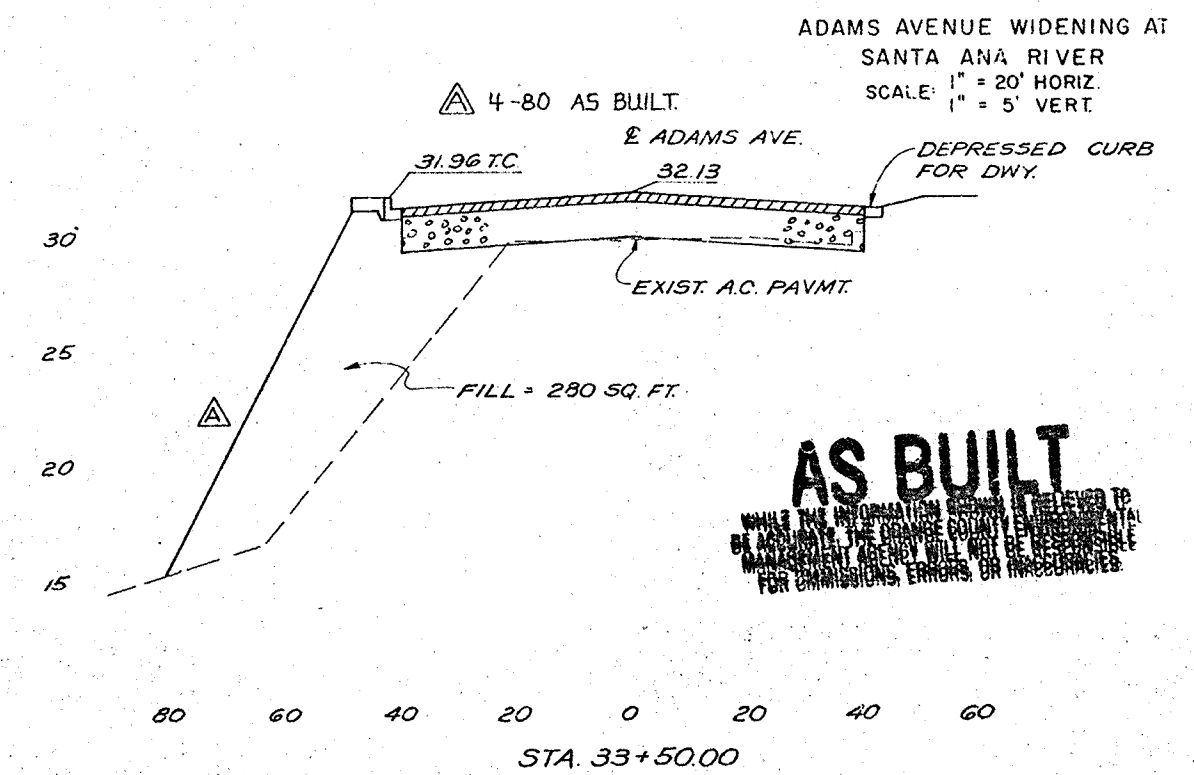
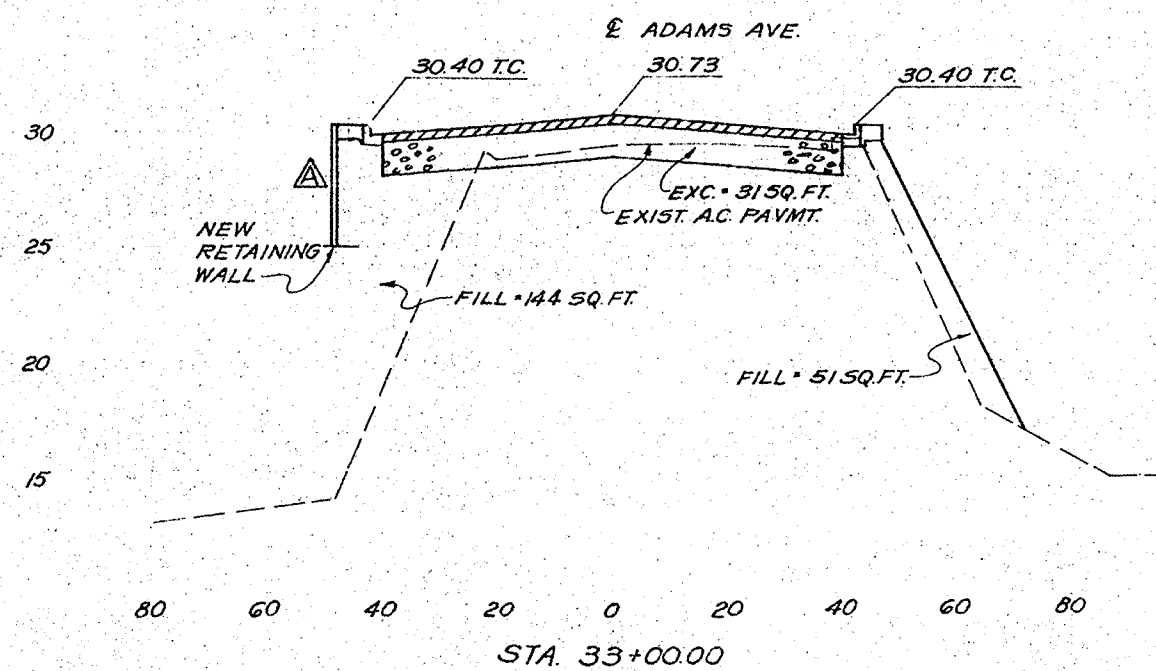
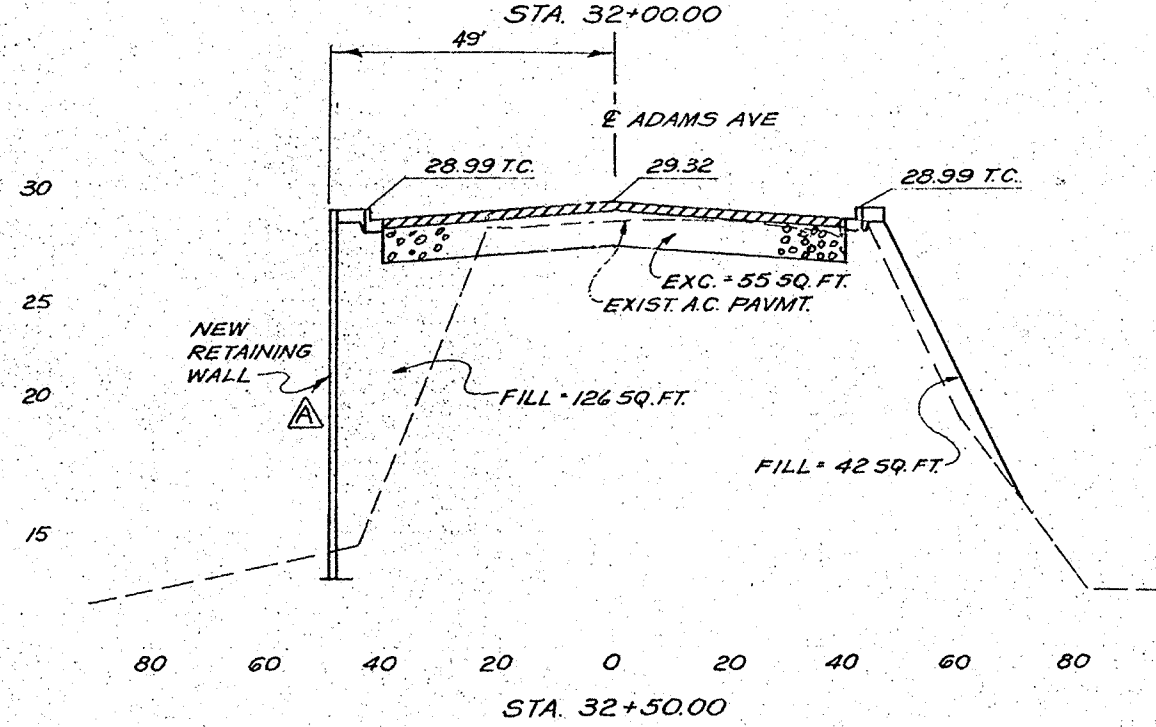
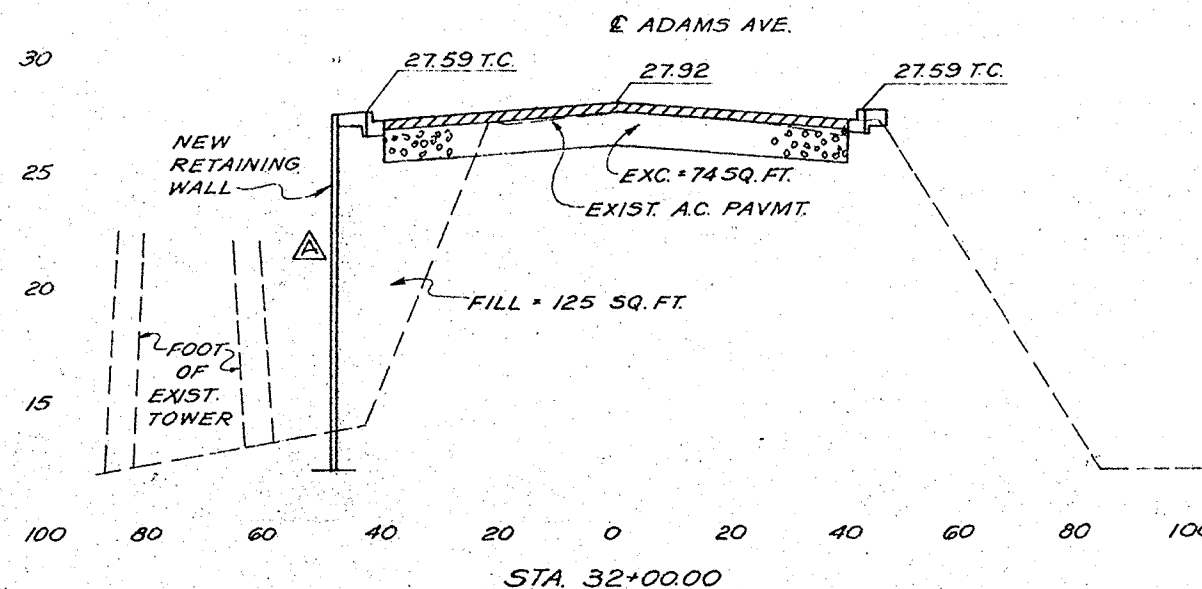
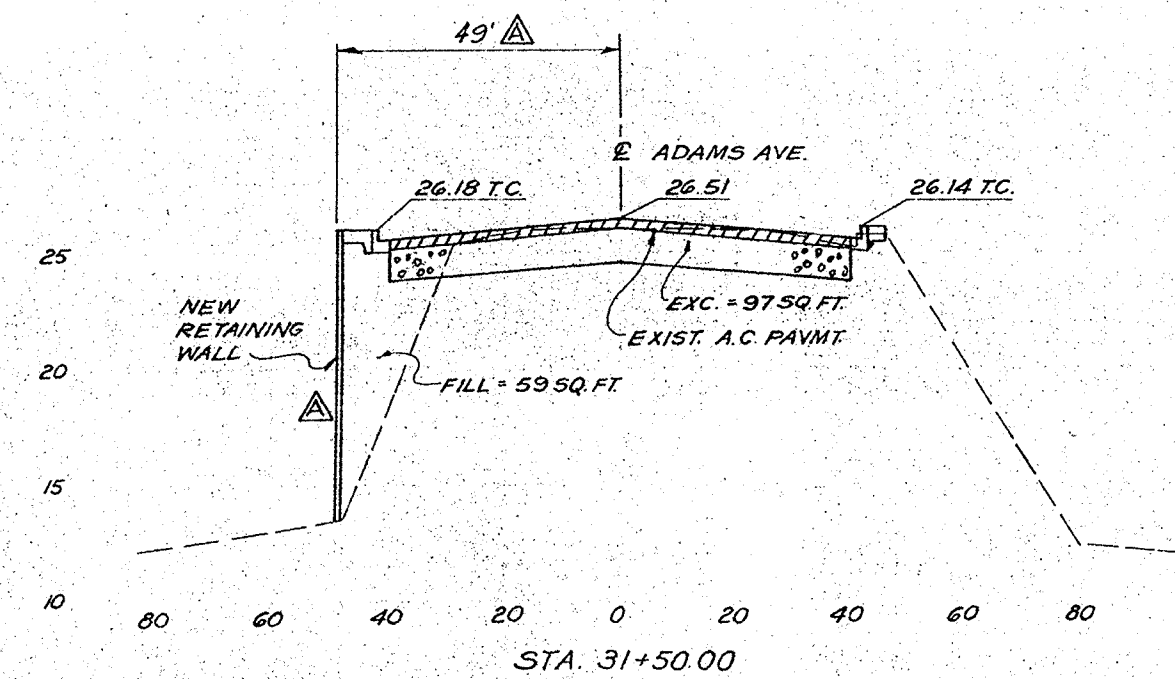
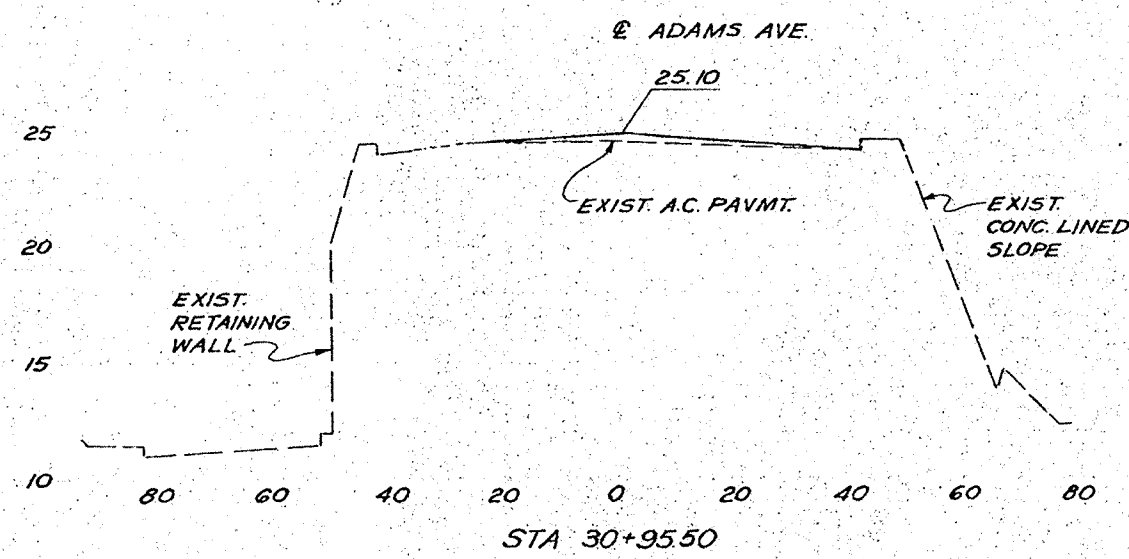


Bridge 13329

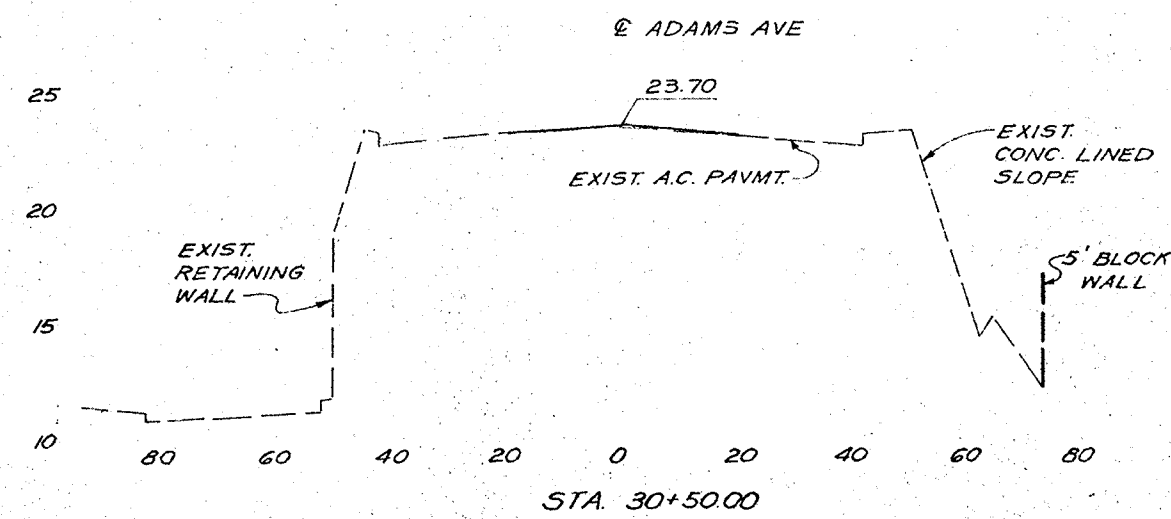

ADAMS AVENUE WIDENING AT
SANTA ANA RIVER
SCALE: 1" = 20' HORIZ
1" = 5' VERT

AS BUILT

Bridge Plans
Dr. #7 13329
Sheet 5 of 53
Red: 24.1
Type: ** Linen

DR#7 13329 SHEET 5 OF 53 SA 35