
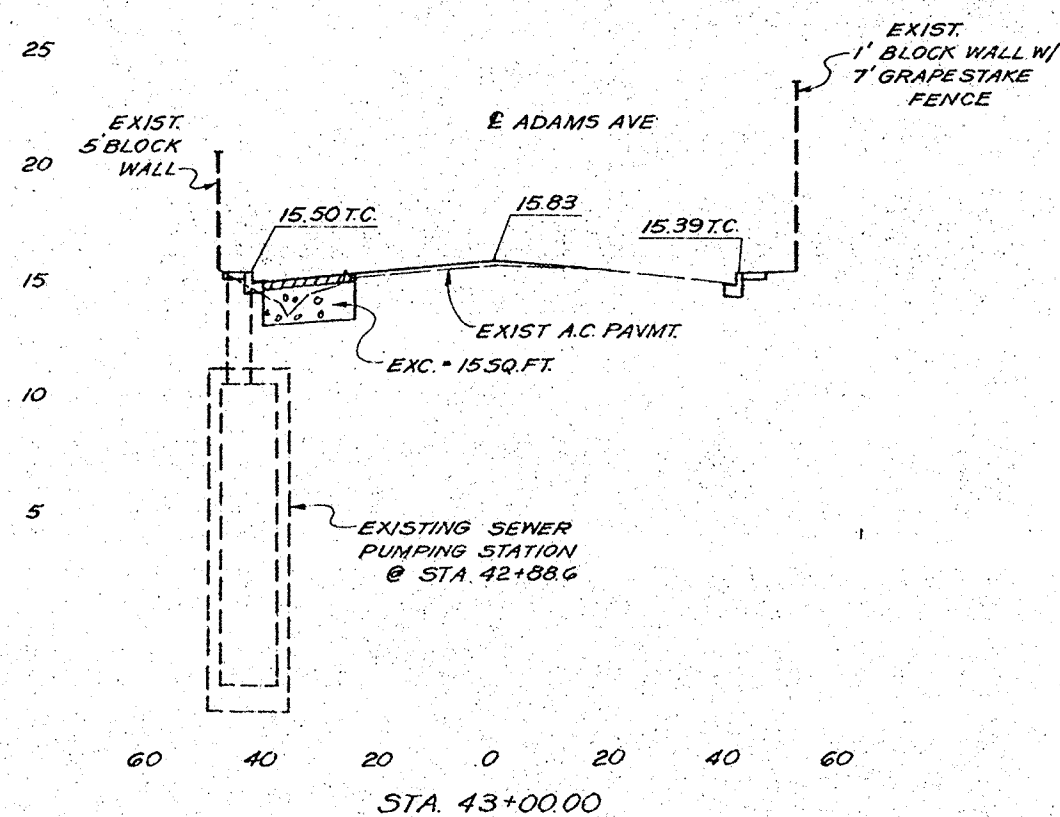
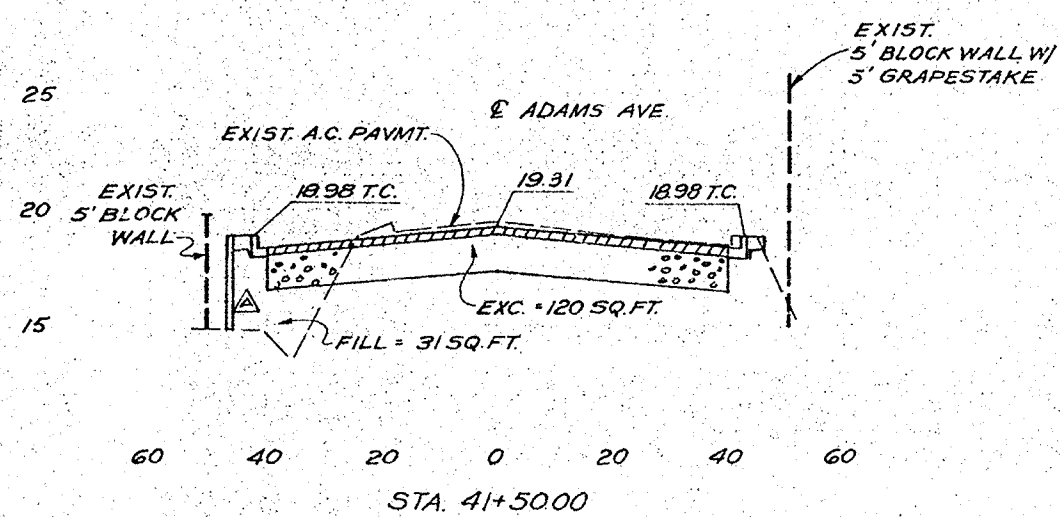
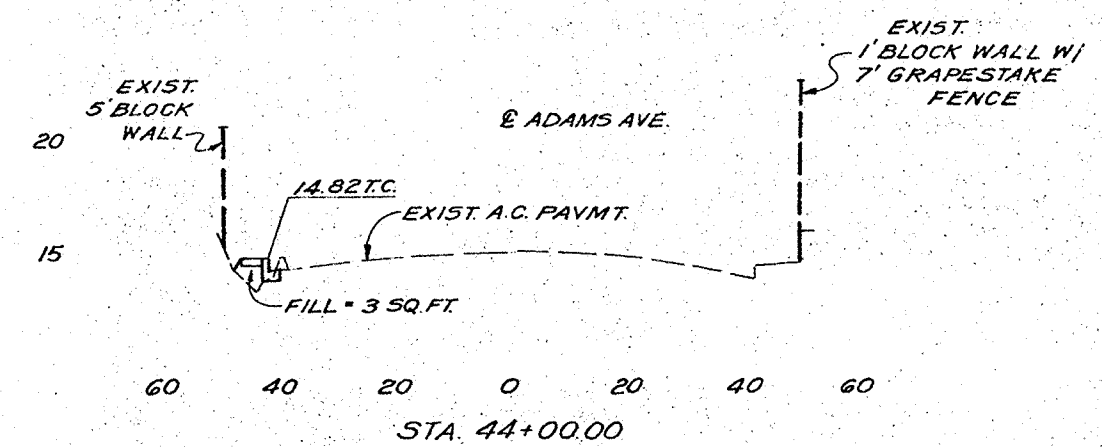
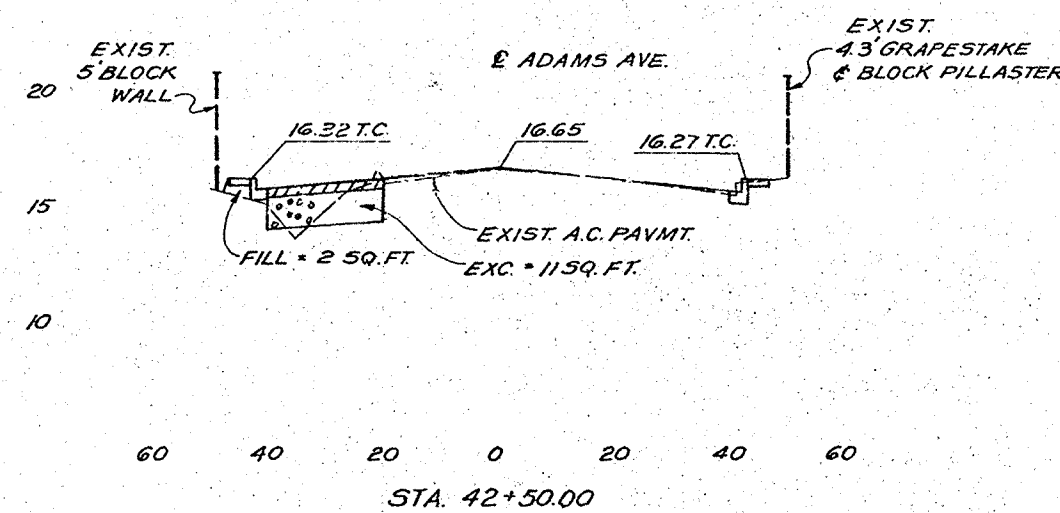
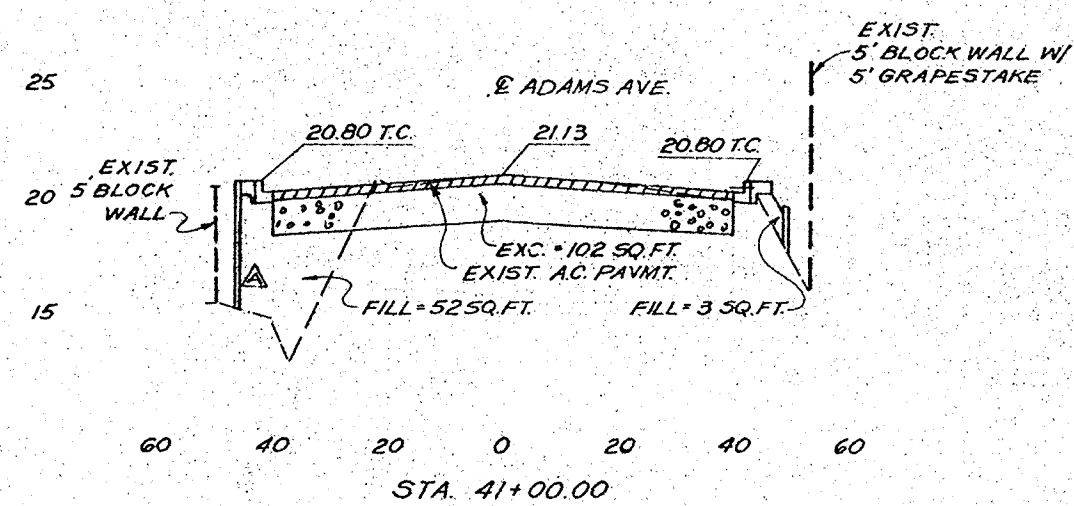
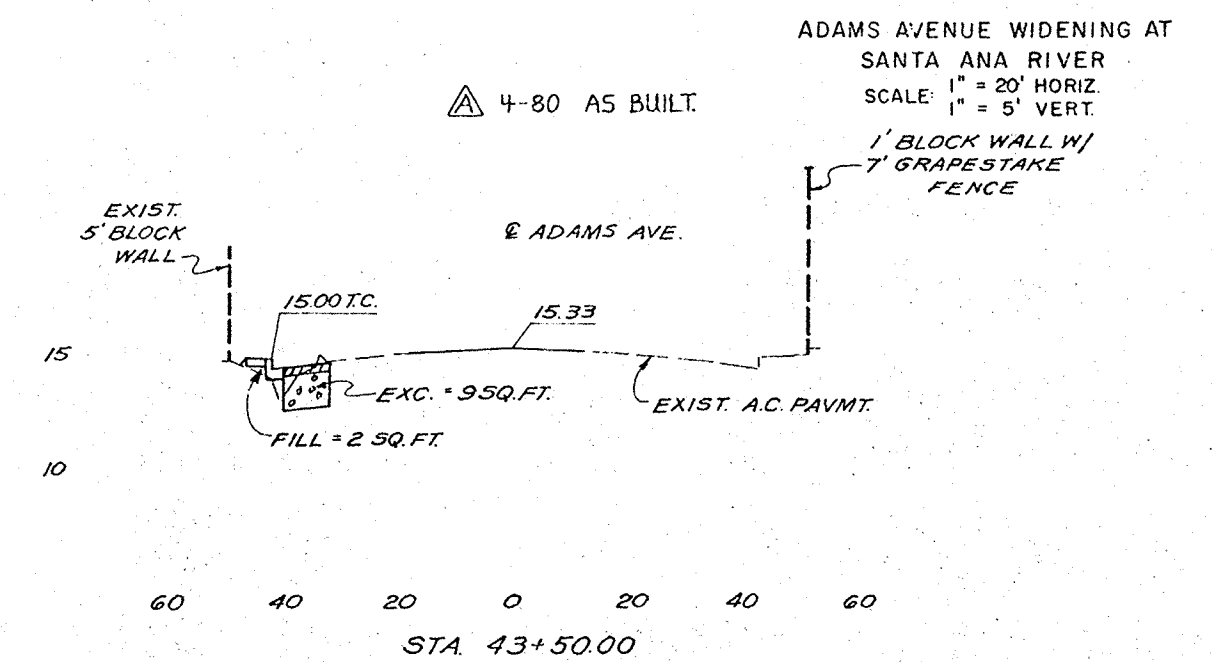
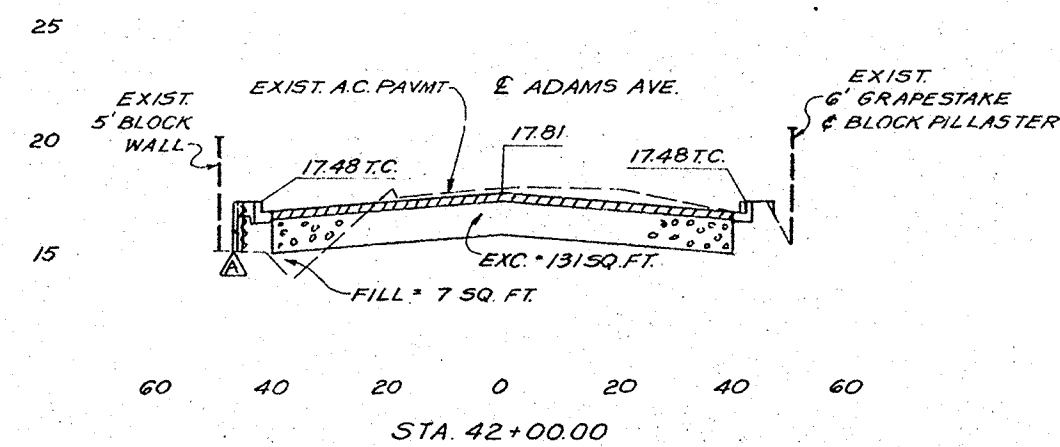


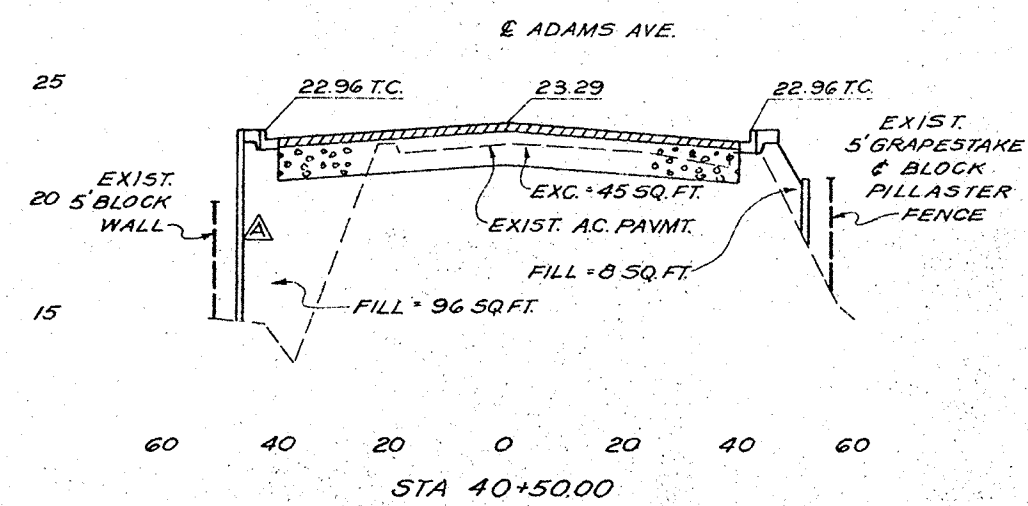

AS BUILT
WHILE THE INFORMATION SHOWN IS BELIEVED TO
BE ACCURATE, THE ORANGE COUNTY ENVIRONMENTAL
MANAGEMENT AGENCY WILL NOT BE RESPONSIBLE
FOR OMISSIONS, ERRORS, OR INACCURACIES.

Bridge Plans
Dr. #7 13329
Sheet 6 of 53
Red:* 24.1
Type:** Linen

DR#7 13329 SHEET 6 OF 53 SA 35-A