


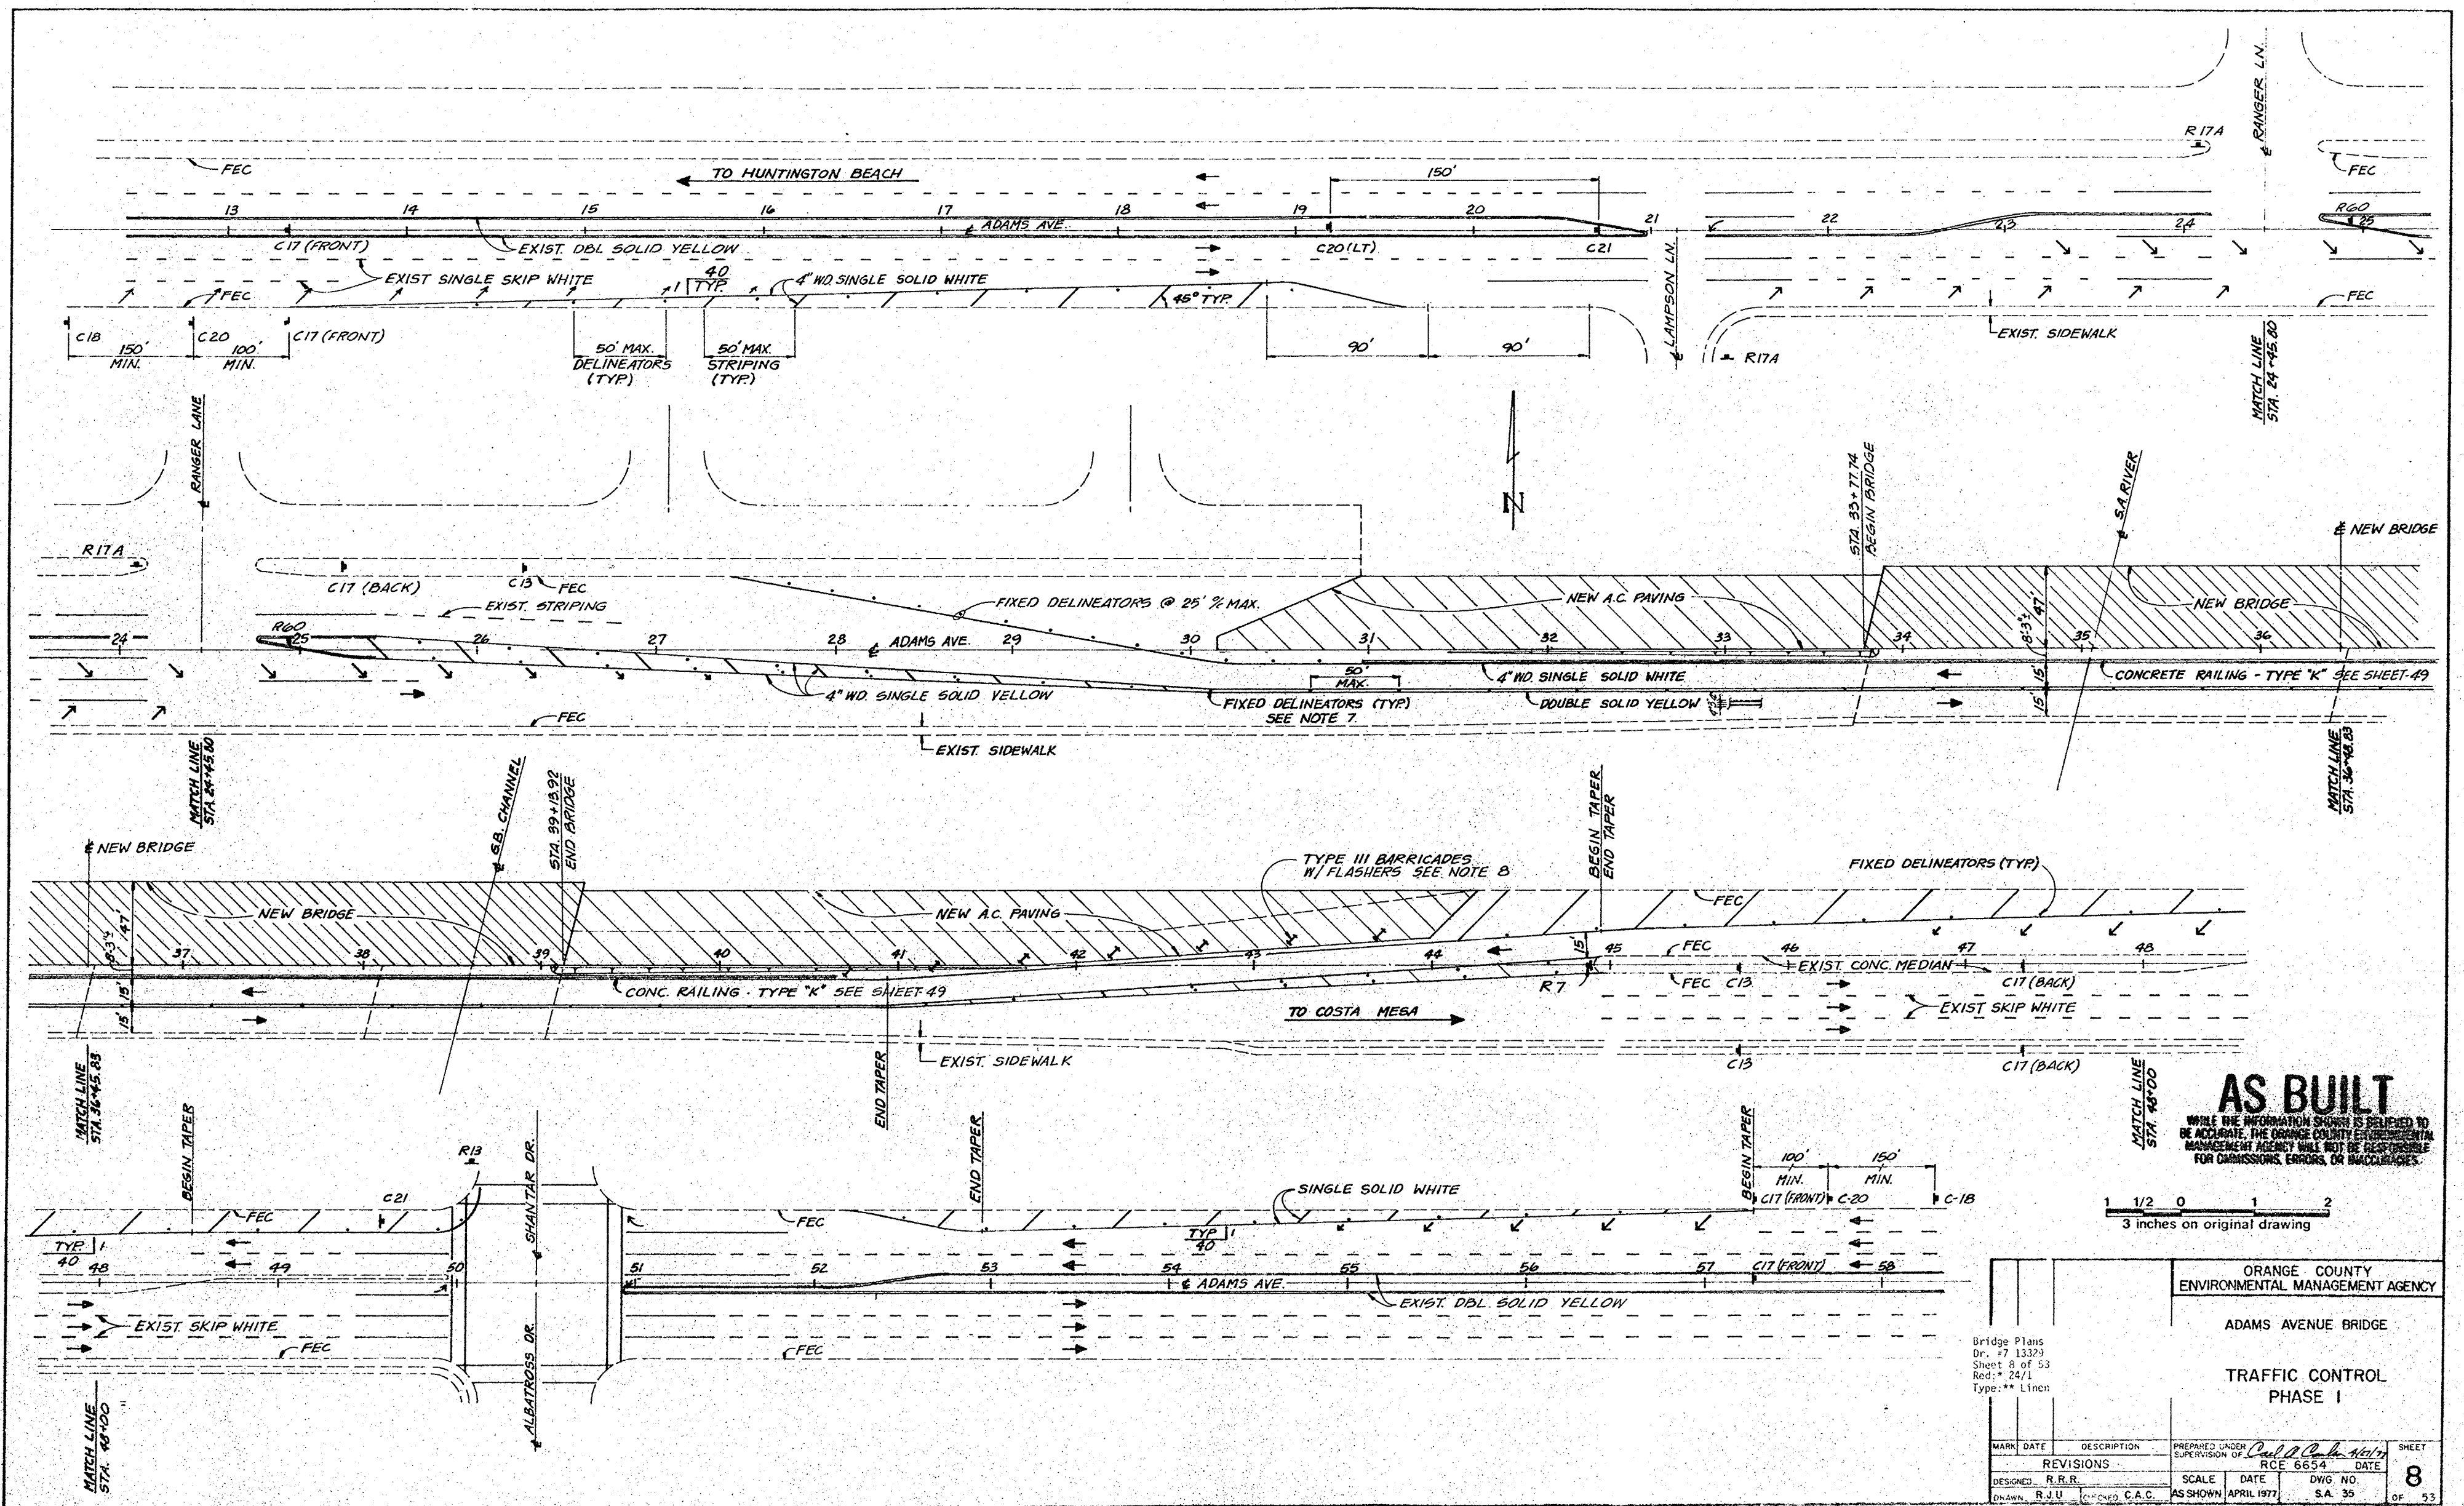

DR#7 13329