



CROSS - SECTION AT STA. 167+00.00
1" = 10' HORIZ. & VERT.

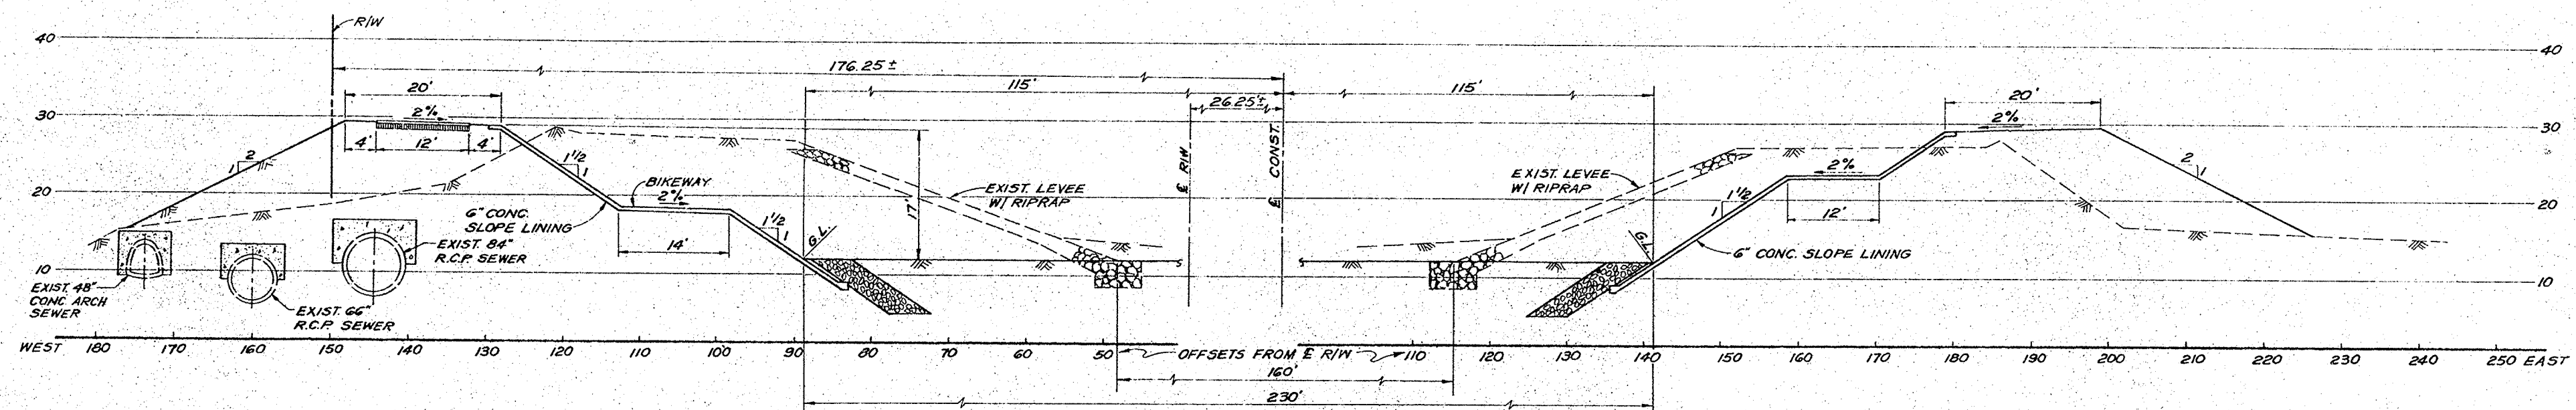

CROSS - SECTION AT STA. 161+00.00
1" = 10' HORIZ. & VERT.

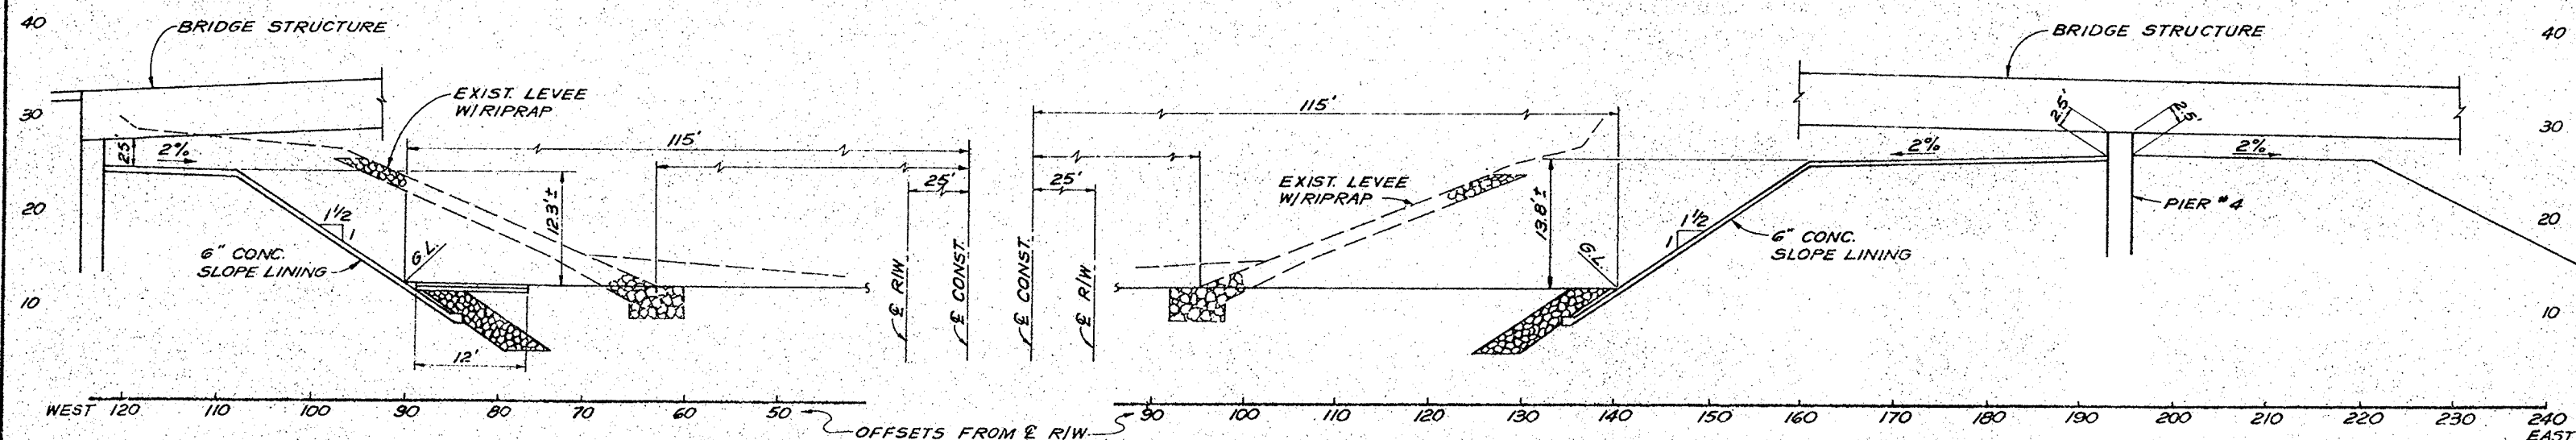

CROSS - SECTION AT STA. 163+65.00
1" = 10' HORIZ. & VERT.

CROSS - SECTION AT STA. 164+25.00
1" = 10' HORIZ. & VERT.

AS BUILT
WHILE THE INFORMATION SHOWN IS BELIEVED TO BE ACCURATE, THE ORANGE COUNTY ENVIRONMENTAL MANAGEMENT AGENCY WILL NOT BE RESPONSIBLE FOR OMISSIONS, ERRORS, OR INACCURACIES.

1 1/2 0 1 2
3 inches on original drawing

Bridge Plans
Dr. #7 13329
Sheet 14 of 33
Red. # 24.1
Type: Linen

MARK	DATE	DESCRIPTION	PREPARED UNDER	SUPERVISION OF	DATE	SHEET
DESIGNED	BY	REVISIONS	SCALE	DATE	DWG. NO.	14
DRAWN	BY	CHECKED	AS SHOWN	APRIL 1977	S.A. 35	of 53

ORANGE COUNTY
ENVIRONMENTAL MANAGEMENT AGENCY

SANTA ANA RIVER CHANNEL

CHANNEL CROSS SECTIONS

DR-7 13329