
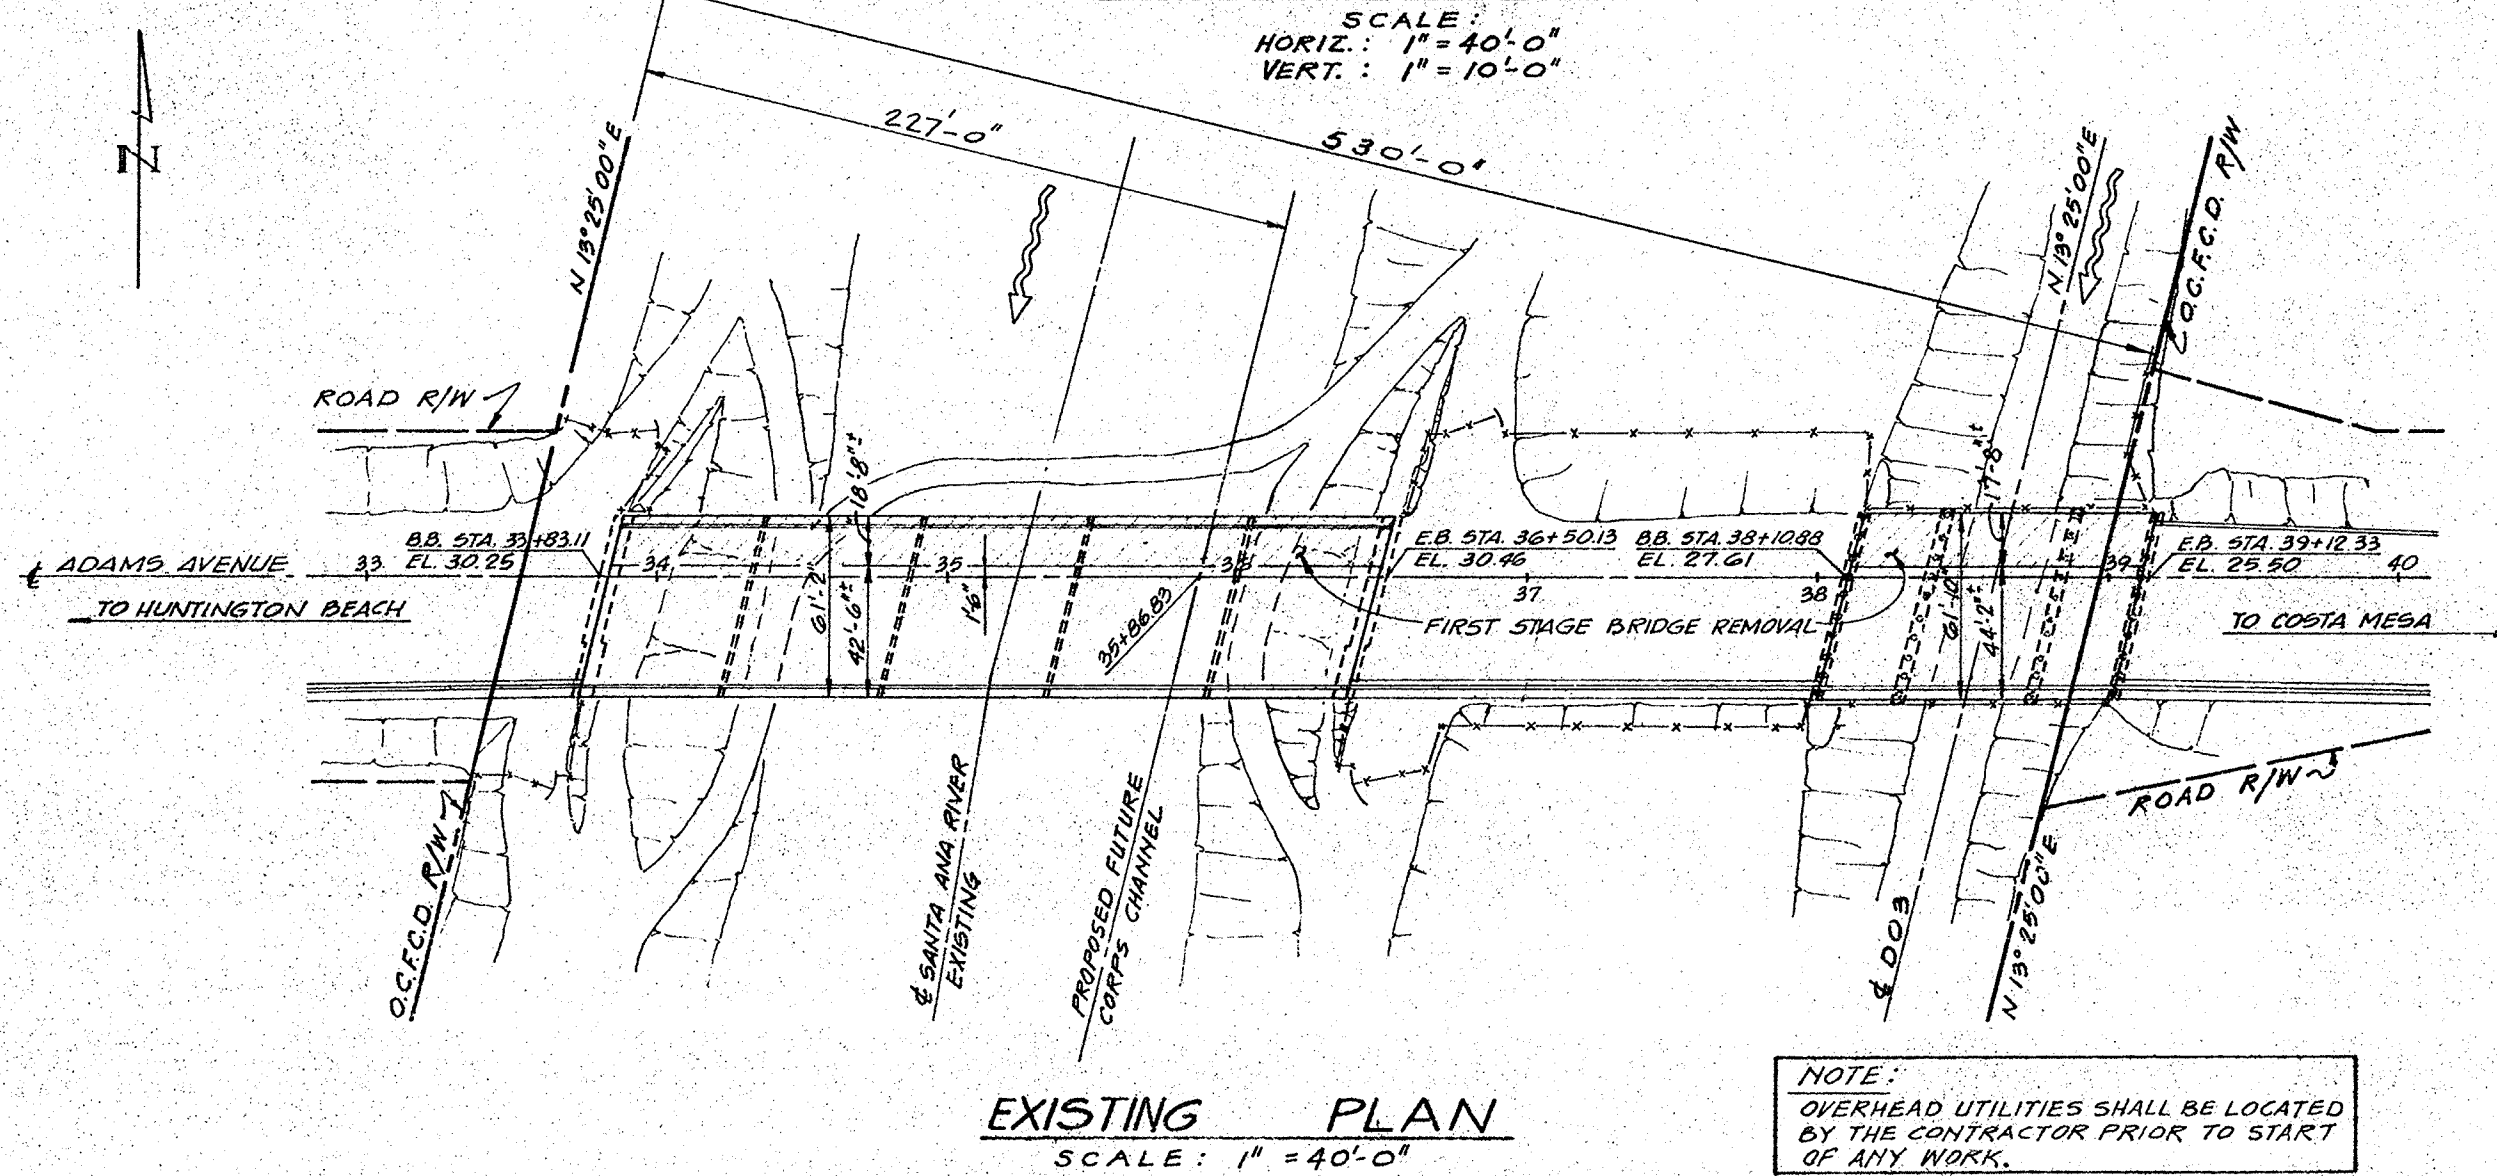


# DEMOLITION GENERAL NOTES

1. STATIONS, ELEVATIONS & CONTOURS ARE APPROXIMATE.
2. ELEVATION OF ELECTRICAL TRANSMISSION LINES OVER ADAMS AVENUE SHALL BE VERIFIED PRIOR TO CONSTRUCTION.
3. SEE SPECIFICATIONS FOR EXCAVATION & FALSEWORK REQUIREMENTS WITHIN O.C.F.C.D. R/W.
4. ALL UTILITIES ABOVE & BELOW GRADE SHALL BE LOCATED & IDENTIFIED PRIOR TO COMMENCING EARTHWORK.
5. ALL DETOUR BARRICADES AND TRAFFIC STRIPING SHALL BE COMPLETED PRIOR TO ANY DEMOLITION WORK.
6. EXISTING PILES TO BE CUT OFF OR REMOVED; SEE FDN. PLAN FOR REMOVAL NOTES & ELEVATIONS.
7. SEE SHEETS 8, 9 & 10 FOR TRAFFIC CONTROL.
8. ALL SHORING AND REQUIRED TEMPORARY SUPPORTS SHALL BE COORDINATED WITH OR IN PLACE PRIOR TO DEMOLITION AND/OR EXCAVATION WORK.
9. EXISTING PILE TIP ELEVATIONS SHOWN ARE APPROXIMATE ONLY.
10. SEE ADDITIONAL DEMOLITION SHEETS FOR BRIDGE DETAILS AND NOTES.

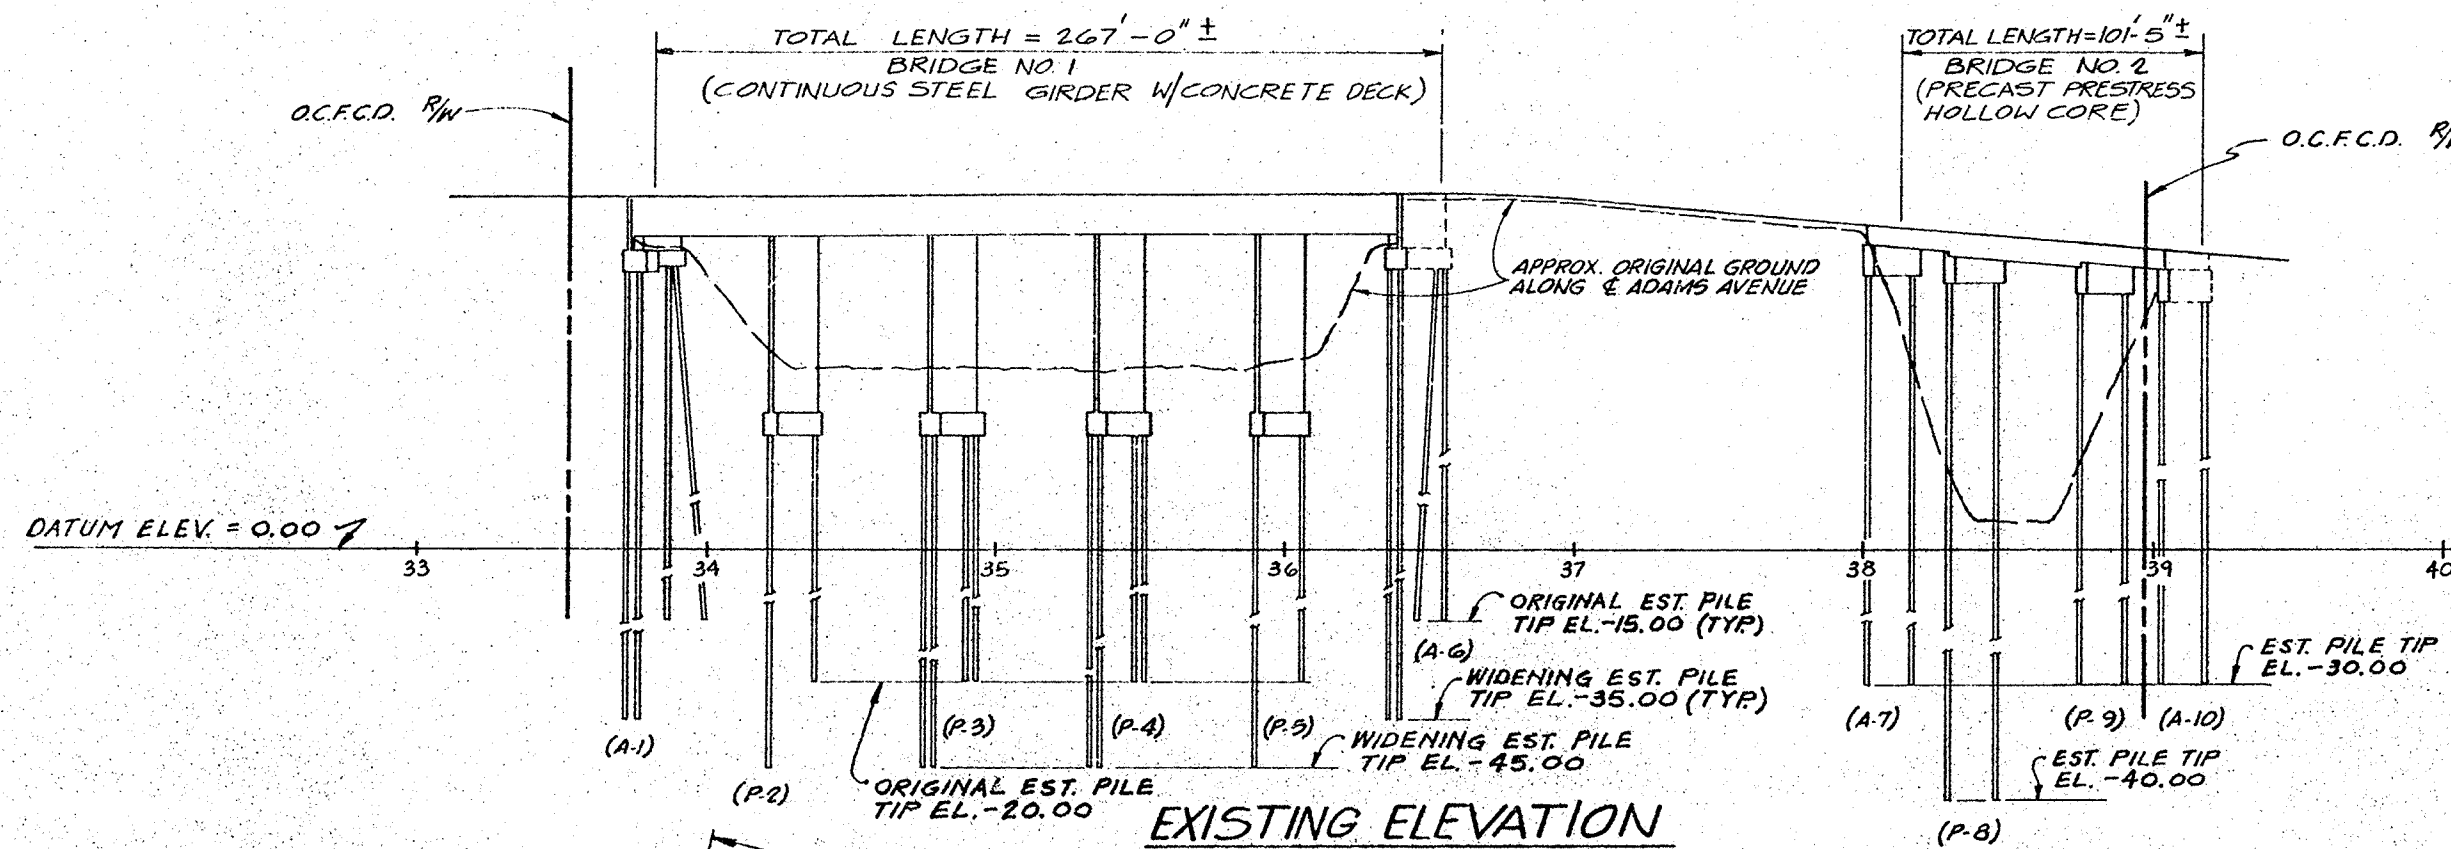

**AS BUILT**

FOR DIMENSIONS, ERRORS, OR INACCURACIES

1 1/2 0 1 2  
3 inches on original drawing

Bridge Plans  
Dr. 7 13329  
Sheet 20 of 53  
Red: 74.1  
Type: \*\* Linen

| ORANGE COUNTY<br>ENVIRONMENTAL MANAGEMENT AGENCY |             |                                  |       |
|--------------------------------------------------|-------------|----------------------------------|-------|
| ADAMS AVENUE BRIDGE<br>OVER<br>SANTA ANA RIVER   |             |                                  |       |
| DEMOLITION<br>GENERAL PLAN                       |             |                                  |       |
| MARK DATE                                        | DESCRIPTION | PREPARED UNDER<br>SUPERVISION OF | SHEET |
| DESIGNED                                         | W.A.C.      | SCALE DATE                       | 20    |
| DRAWN                                            | W.A.C.      | AS SHOWN APRIL 1977              | OF 53 |

DR 7 13329