


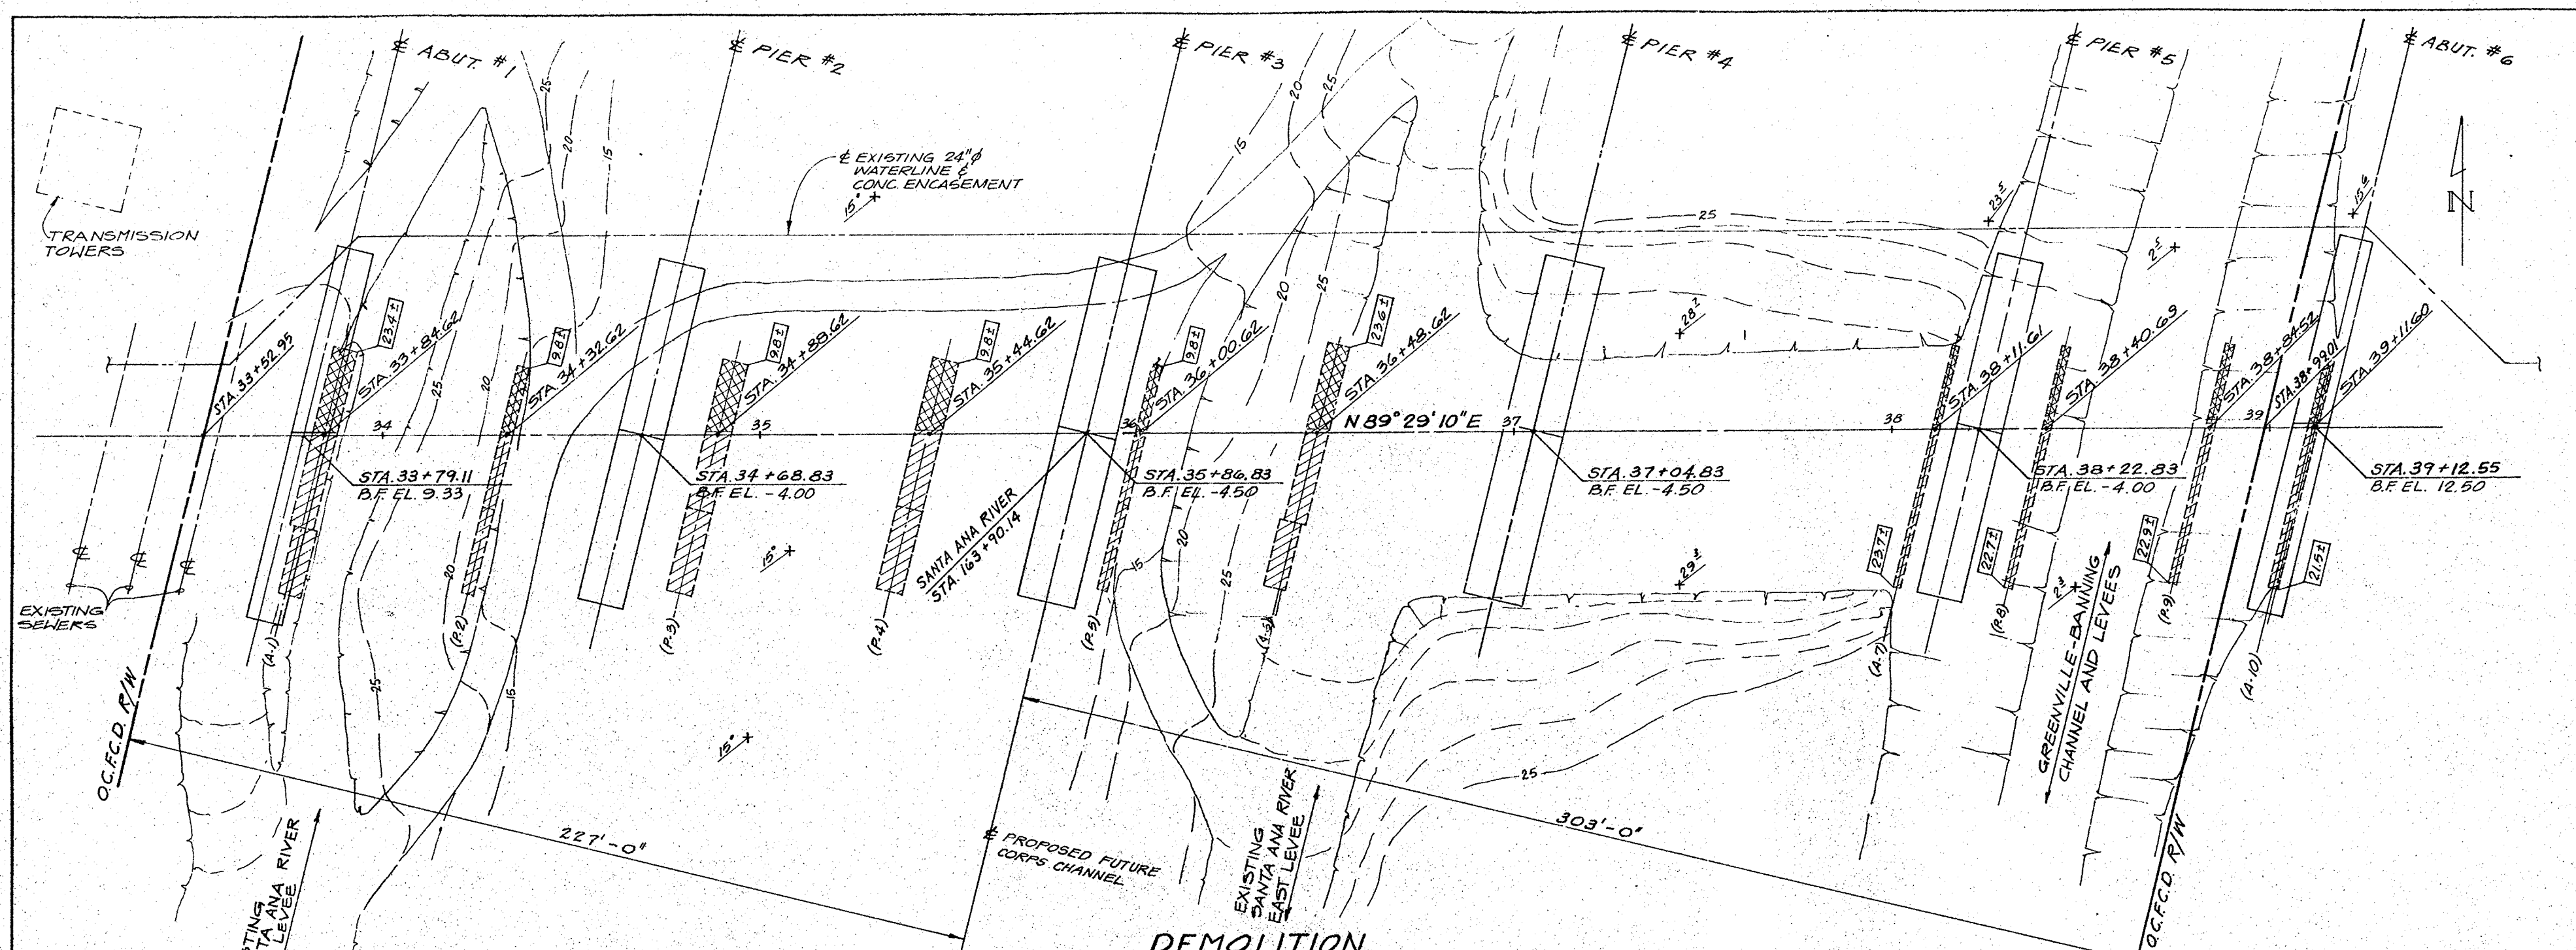

**DEMOLITION
FOUNDATION PLAN**
SCALE: 1" = 20'-0"


LOCATION	STATION	EXISTING PILE CUT OFF ELEVATION	NO. PILES
(A-1)	33+84.62	+9.00	16
(P-2)	34+32.62	-2.00	16
(P-3)	34+88.62	-2.00	20
(P-4)	35+44.62	-2.00	20
(P-5)	36+00.62	-2.00	16
(A-6)	36+48.62	-2.00	16
(A-7)	38+11.61	-3.50	10
(P-8)	38+40.63	-3.50	11
(P-9)	38+84.52	-3.50	11
(A-10)	39+11.60	+12.00	10

- LEGEND**
- EXISTING PIER OR ABUTMENT
 - EXISTING APPROX. BOTT. FOOTING ELEVATION
 - EXISTING CONTOURS
 - NEW FOOTING STATIONS
 - EXISTING FOOTING STATIONS
 - SPOT ELEVATIONS
 - FIRST STAGE DEMOLITION

- NOTES:**
- EXISTING PILES @ NEW ABUTMENTS #1 & #6 SHALL BE FIELD LOCATED PRIOR TO DRIVING PILES.
 - EXISTING PILES WHICH INTERFERE WITH NEW PILES SHALL BE REMOVED WITH HOLES FILLED WITH CLEAN CHANNEL BOTTOM MATERIAL. ALL AT THE ORDER OF THE ENGINEER.
 - SEE SHEETS 22, 23 & 24 FOR DETAILS & NOTES.

REFER TO SPECIFICATIONS FOR
DATE OF COMPLETION OF ALL
EXISTING BRIDGE DEMOLITION.

AS BUILT
ALL DIMENSIONS SHOWN
ON THIS PLAN ARE BASED ON
FIELD SURVEY DATA
AND SHALL BE USED FOR
CONSTRUCTION OF THE
BRIDGE.

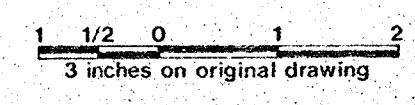

Bridge Plans
Dr. #7 13329
Sheet 21 of 53
Rev. # 24.1
Type: ** Linen

ORANGE COUNTY ENVIRONMENTAL MANAGEMENT AGENCY	
ADAMS AVENUE BRIDGE OVER SANTA ANA RIVER	
DEMOLITION FOUNDATION PLAN	
MARK DATE	DESCRIPTION
REVISIONS	
DESIGNED	W.A.C.
DRAWN	R.R.R.
CHECKED	D.S.
PREPARED UNDER SUPERVISION OF	RCE 6554
DATE	DATE
SCALE	DATE
AS SHOWN	APRIL 1977
DWG. NO.	S.A. 35
SHEET	21
OF 53	

13329