



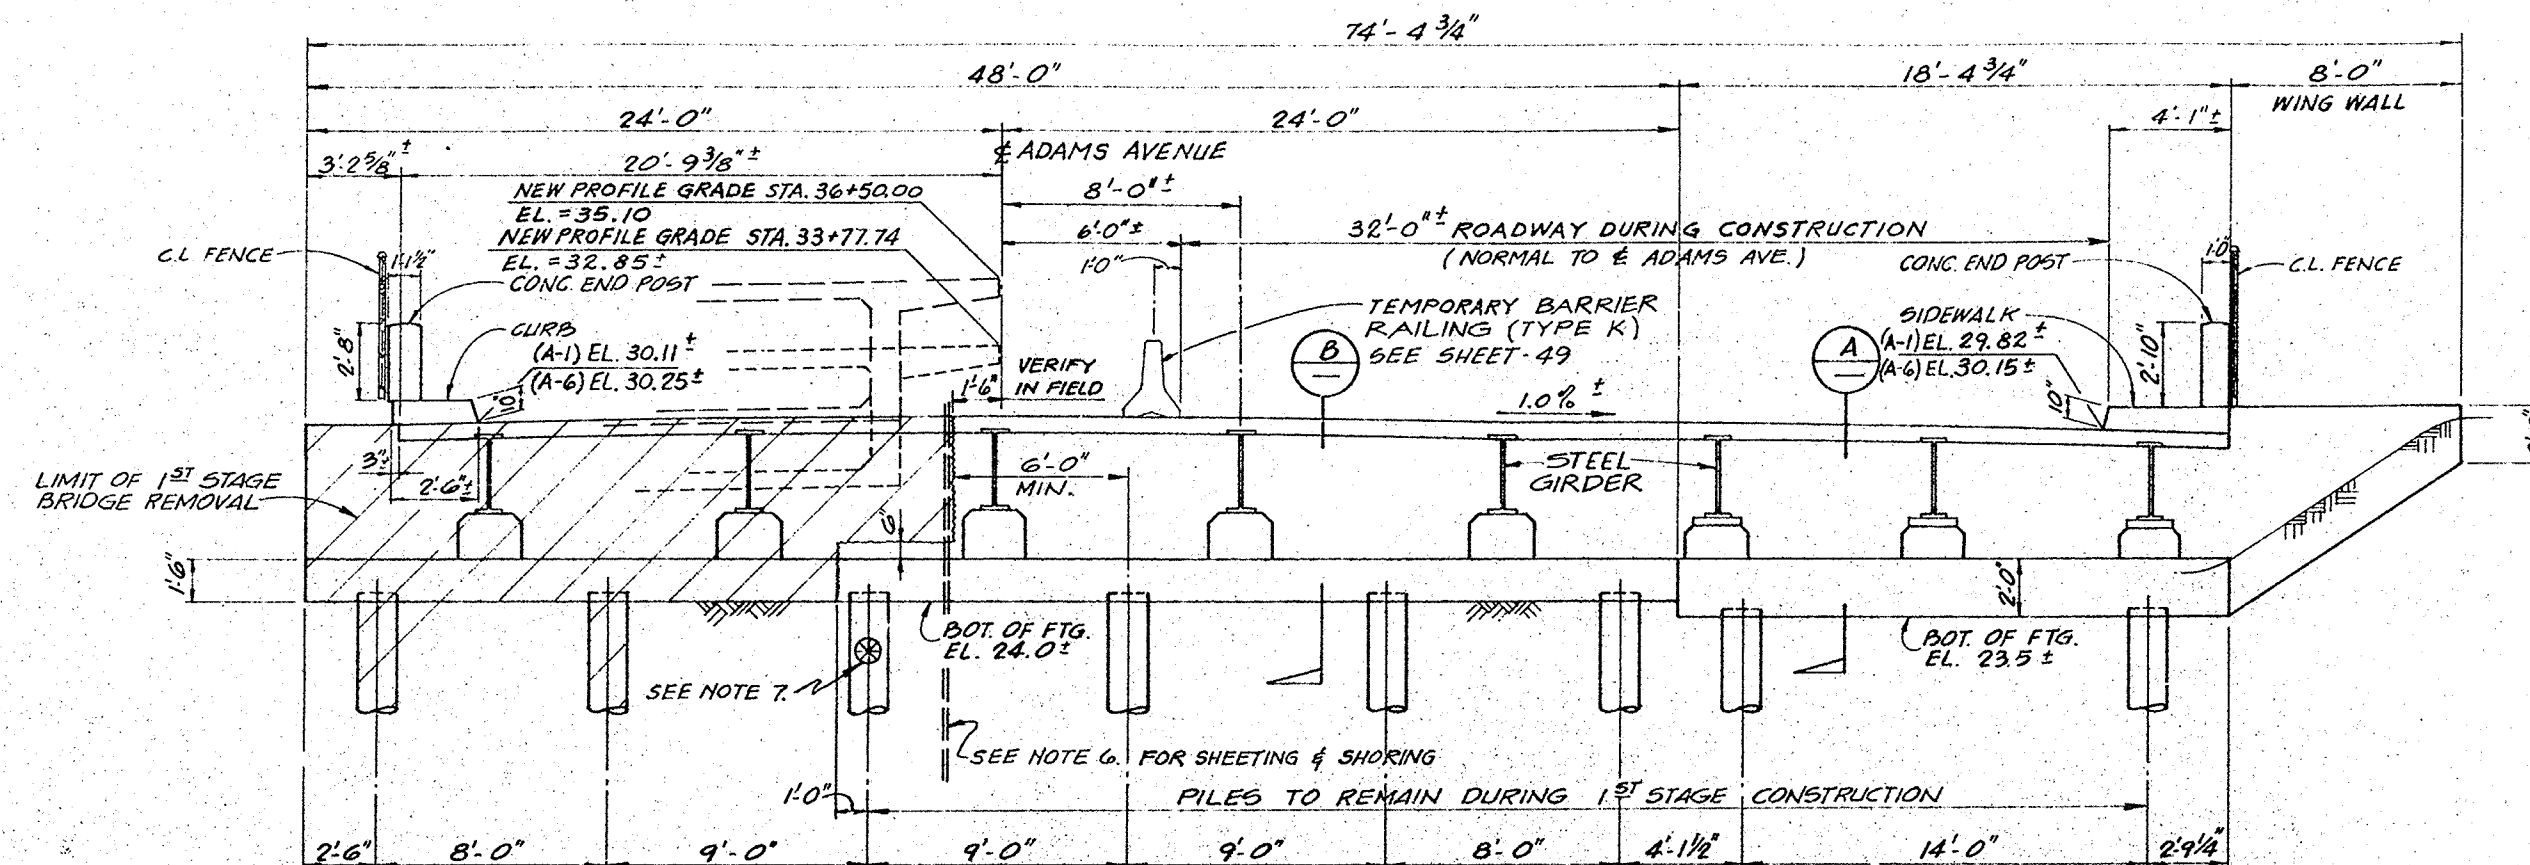


NOTE:
24\"/>

EXISTING ABUTMENT #6 SHOWN (ABUTMENT #1 SIMILAR)
1/4\"/>

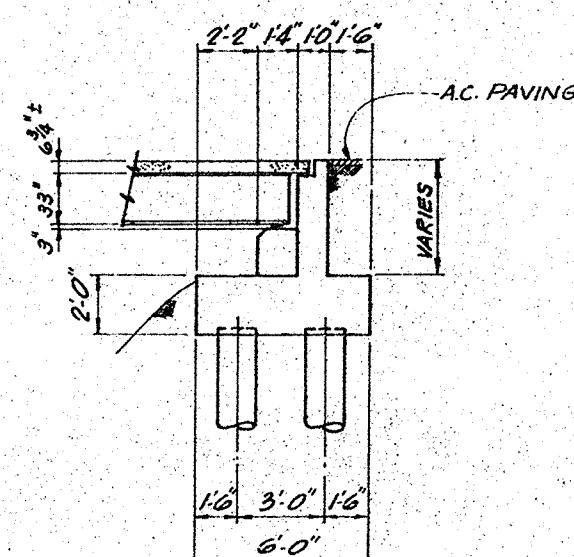

SECTION A

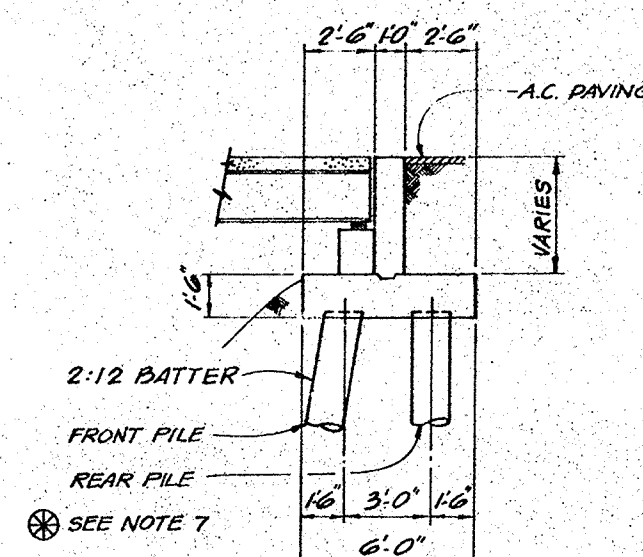

SECTION B

NOTES:

- EXISTING BRIDGE DRAWINGS ARE AVAILABLE FOR REVIEW AND ARE ON FILE IN THE OFFICE OF O.C.E.M.A..
- EXISTING BRIDGE DECK SHALL BE COMPLETELY SAW CUT FOR 1ST STAGE BRIDGE REMOVAL. NO IMPACT METHODS OF CONCRETE REMOVAL SHALL BE USED.
- ABUTMENT, PIER WALLS AND FOOTING SHALL BE REMOVED BY EITHER SAW CUTTING, ABRASIVE BLAST CUTTING, IMPACT TOOL CUTTING OR OTHER MEANS AS APPROVED BY THE ENGINEER. NO REMOVAL METHOD SHALL BE USED WHICH WILL DAMAGE THE REMAINING EXISTING BRIDGE STRUCTURES.
- ALL DIMENSIONS AND SECTIONS INDICATED FOR THE EXISTING BRIDGES ARE APPROXIMATE AND SHALL BE VERIFIED BY THE CONTRACTOR.
- EXISTING STEEL CONNECTIONS, BRACING AND MISC. BRACING ARE NOT INDICATED.
- CONTRACTOR TO PROVIDE CONTINUOUS SHORING AND SHEETING SUPPORT OF EXISTING FACILITIES AND SOIL STABILIZATION. SHORING METHODS AND DRAWINGS SHALL BE SUBMITTED TO THE ENGINEER FOR REVIEW PRIOR TO ANY EXCAVATION OR BRIDGE REMOVAL.
- FRONT AND REAR PILES MARKED ⊗ SHALL BE LEFT IN PLACE FOR THE SUPPORT OF ABUTMENTS DURING STAGE-I CONSTRUCTION. NEW FOOTING MAY BE CAST AROUND PILES MARKED ⊗ AS DIRECTED BY THE ENGINEER. NEW PILES MAY BE LOCATED TO AVOID INTERFERENCE WITH EXISTING PILES AT THE DIRECTION OF THE ENGINEER.
- THE CONTRACTOR SHALL LOCATE ALL EXISTING PILES, PROVIDE LAYOUT SHEETS INDICATING NEW AND EXISTING PILES, AND SHALL SUBMIT TO THE ENGINEER METHODS OF PILE DRIVING PRIOR TO DRIVING AND DRILLING OPERATIONS.
- SEE SHEET 21 FOR EXISTING PILE CUT-OFF ELEVATIONS.

AS BUILT

WHILE THE INFORMATION SHOWN IS BELIEVED TO BE ACCURATE, THE ORANGE COUNTY ENVIRONMENTAL MANAGEMENT AGENCY WILL NOT BE RESPONSIBLE FOR OMISSIONS, ERRORS, OR INACCURACIES.

1 1/2 0 1 2
3 inches on original drawing

Bridge Plans
Dr. # 13329
Sheet 22 of 53
Red: # 24.1
Type: ** Lines

ORANGE COUNTY ENVIRONMENTAL MANAGEMENT AGENCY			
ADAMS AVENUE BRIDGE OVER SANTA ANA RIVER			
DEMOLITION DETAILS - I			
MARK DATE	DESCRIPTION	PREPARED UNDER SUPERVISION OF	SHEET
DESIGNED	W.A.C.	SCALE DATE	DWG. NO. DATE
DRAWN	P.E.D.	AS SHOWN APRIL 1977	S.A. 35 6F53

DR 7 13329