



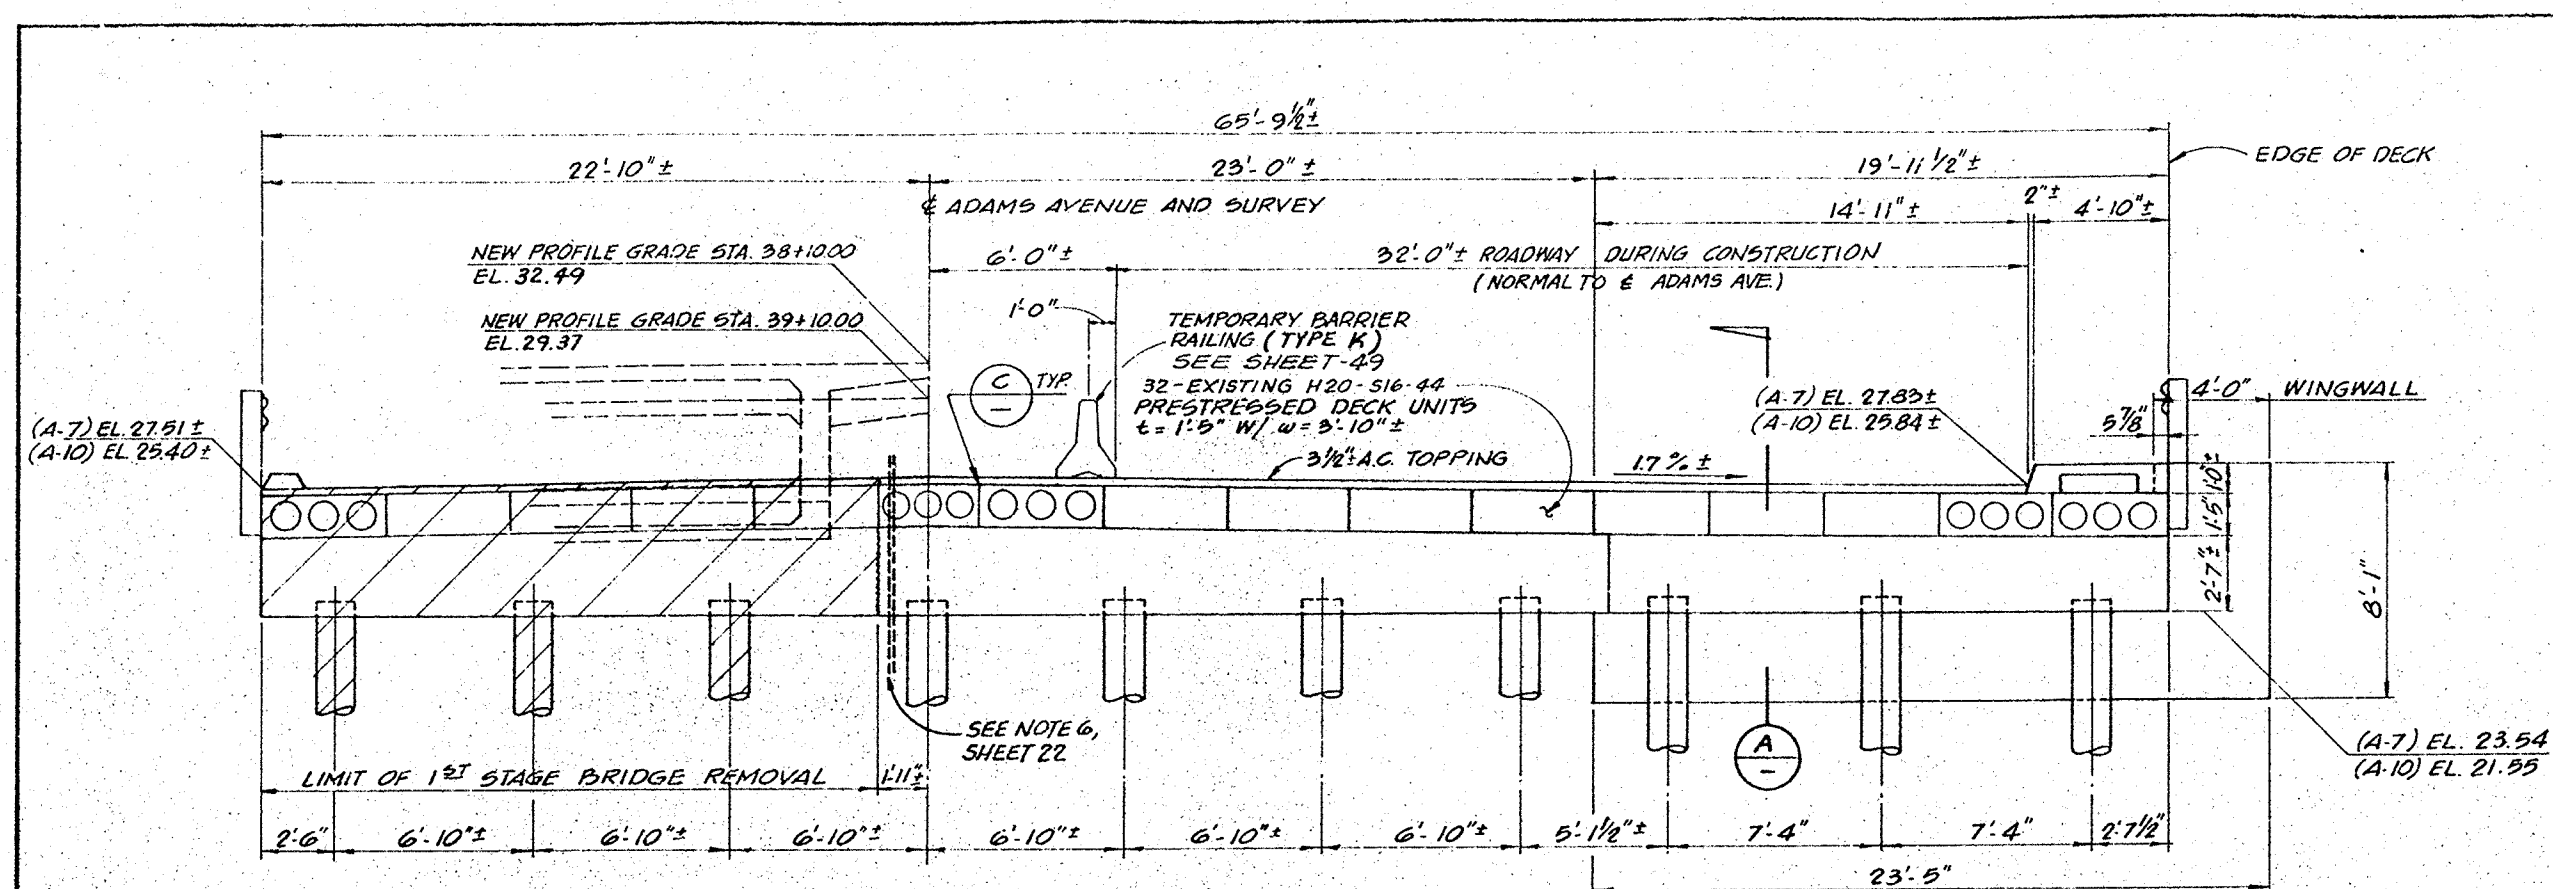


NOTE: 24" Ø CONCRETE
ENCASED WATERLINE
NOT SHOWN

EXISTING ABUTMENT #10 SHOWN
SCALE: 1/4" = 1'-0"


REFER TO SHEETS 20, 21 & 22 FOR NOTES

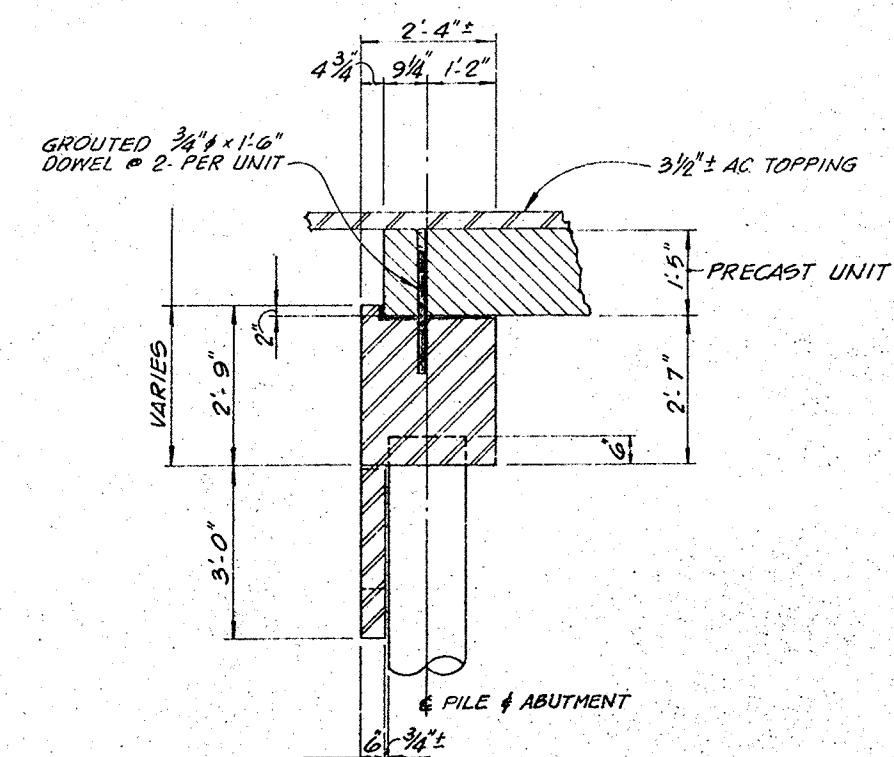


SECTION A
SCALE: 1/2" = 1'-0"

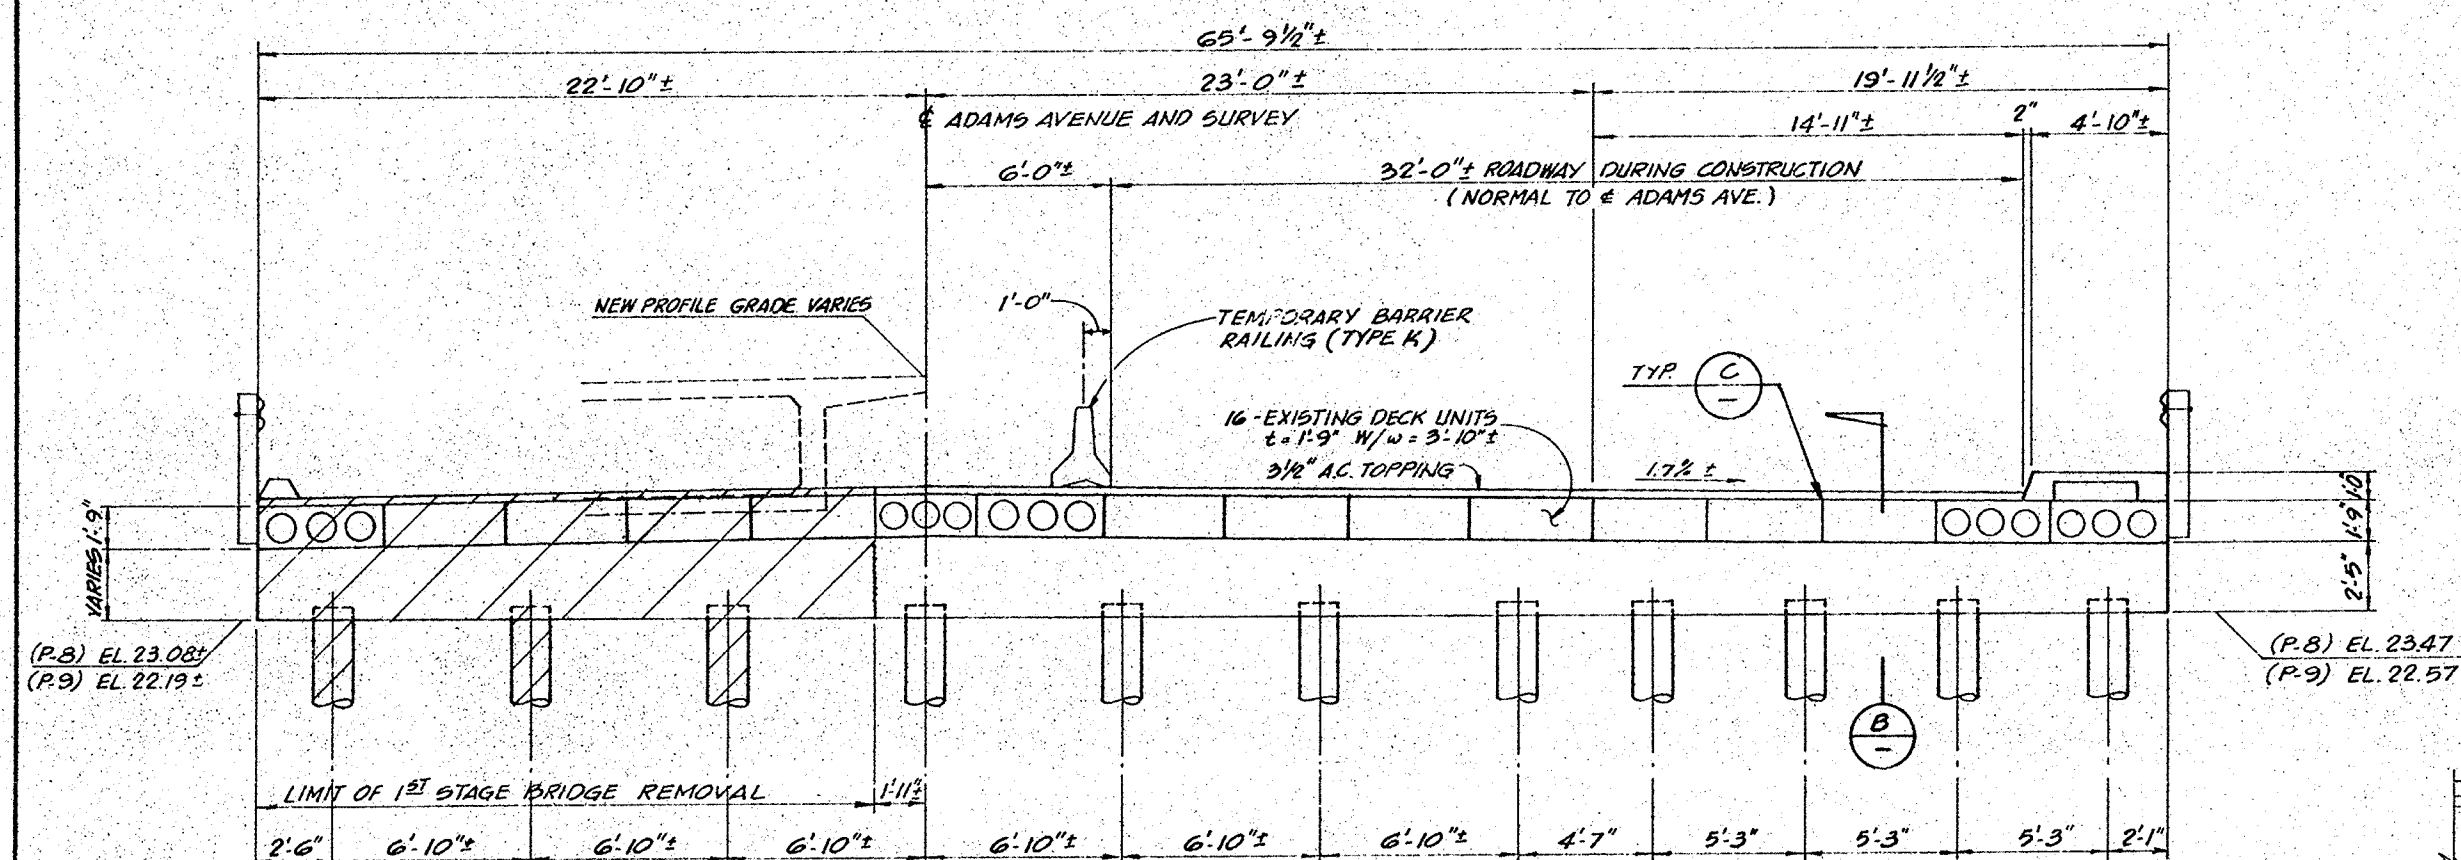

EXISTING PIER #8 SHOWN
SCALE: 1/4" = 1'-0"

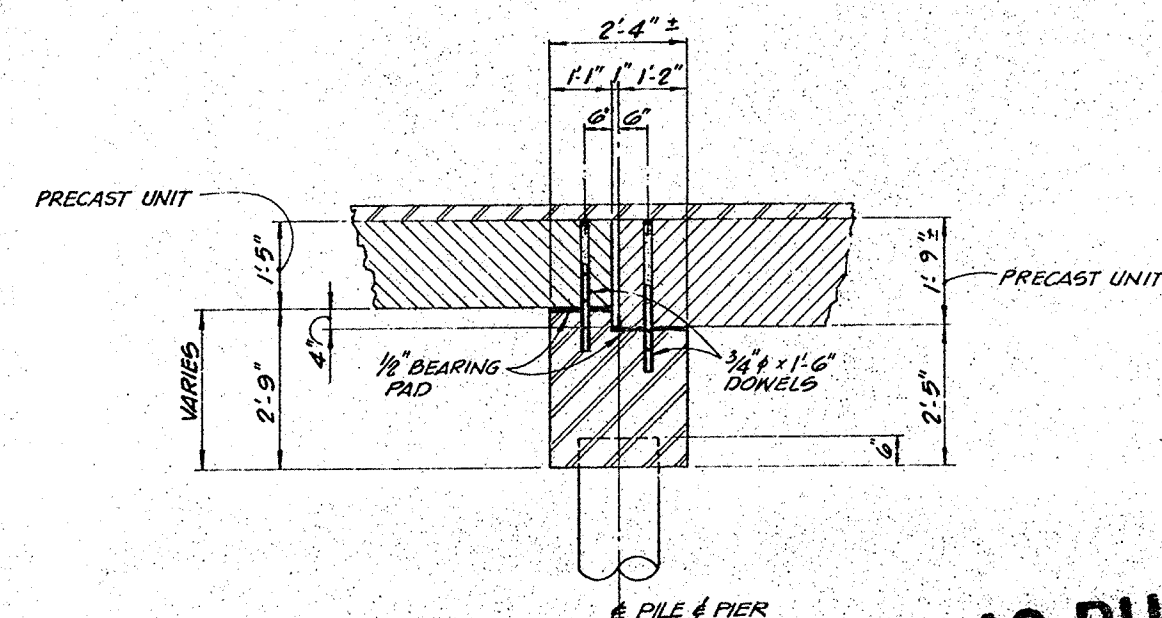

SECTION B
SCALE: 1/2" = 1'-0"

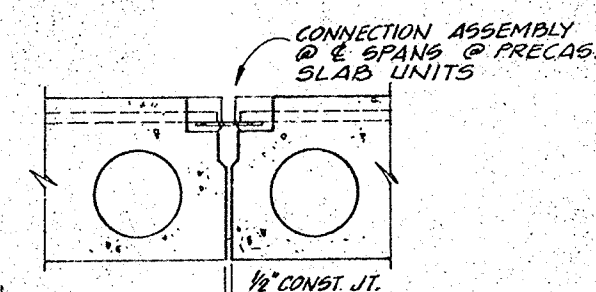

SLAB UNIT CONNECTION C
N.T.S.

AS BUILT
WHILE THE INFORMATION SHOWN IS BELIEVED TO
BE ACCURATE, THE ORANGE COUNTY ENVIRONMENTAL
MANAGEMENT AGENCY WILL NOT BE RESPONSIBLE
FOR OMISSIONS, ERRORS, OR INADEQUACIES

1 1/2 0 1 2
3 inches on original drawing

Bridge Plans
Dr. # 13329
Sheet 24 of 53
Rev. # 24.1
Type: ** Linen

				ORANGE COUNTY ENVIRONMENTAL MANAGEMENT AGENCY	
				ADAMS AVENUE BRIDGE OVER SANTA ANA RIVER	
				DEMOLITION DETAILS-3	
Plans 3329 of 53 -1 Linen					