



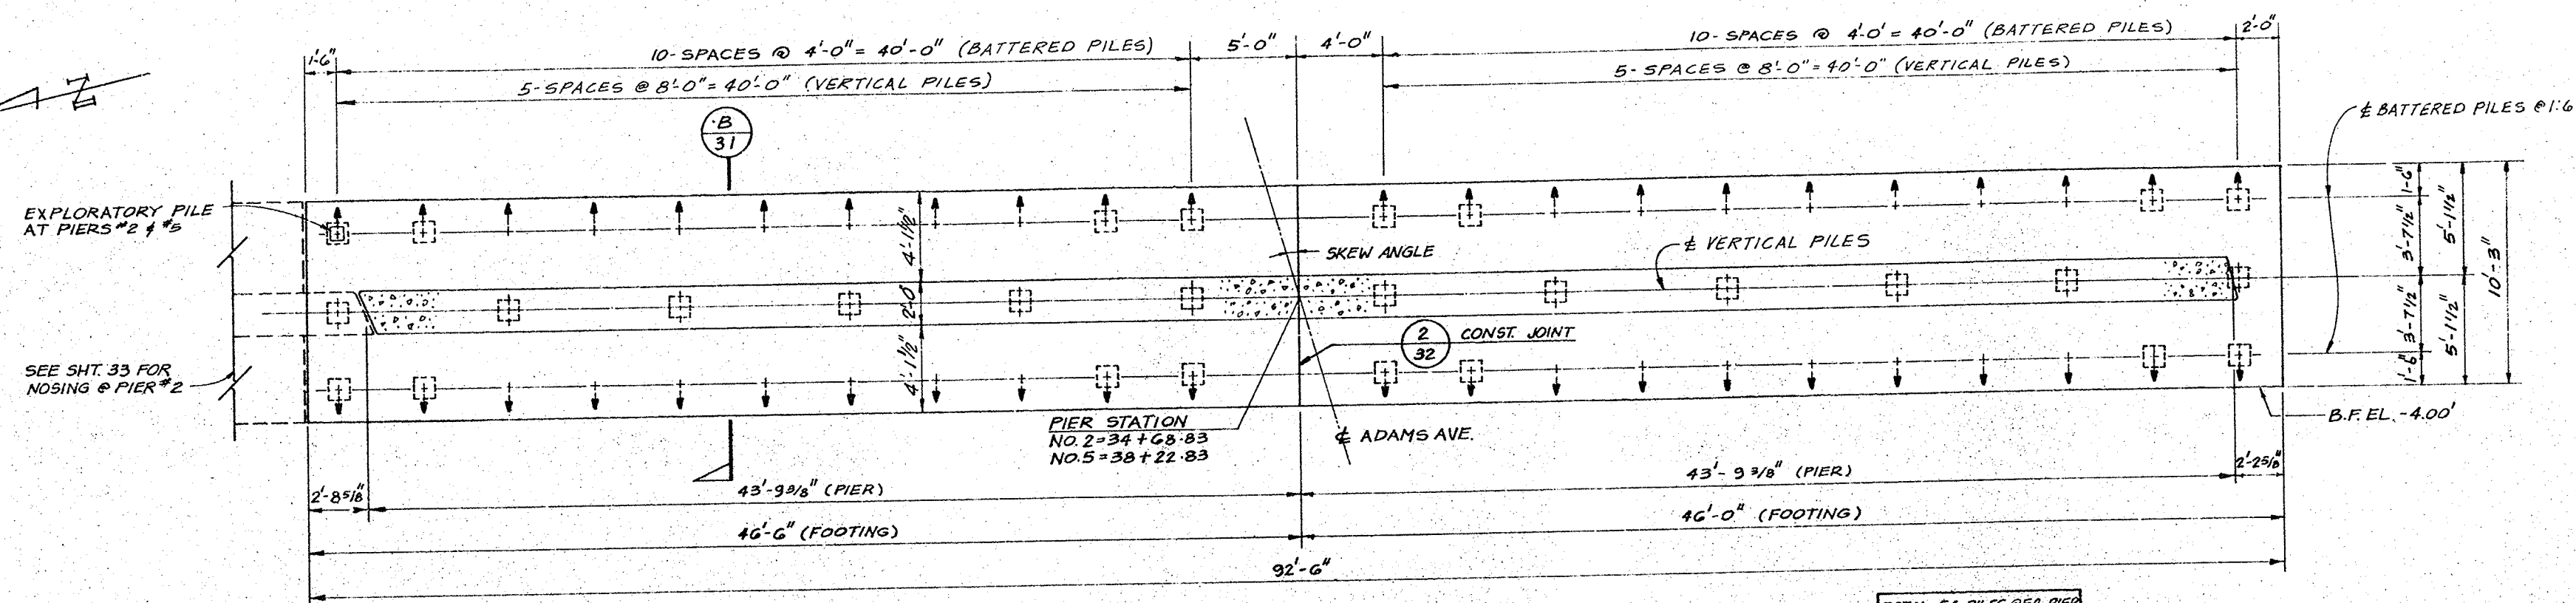

PIER NO. 2 & 5
PIER FOOTING & PILE LAYOUT-PLAN (A)
SCALE: 1/4" = 1'-0"

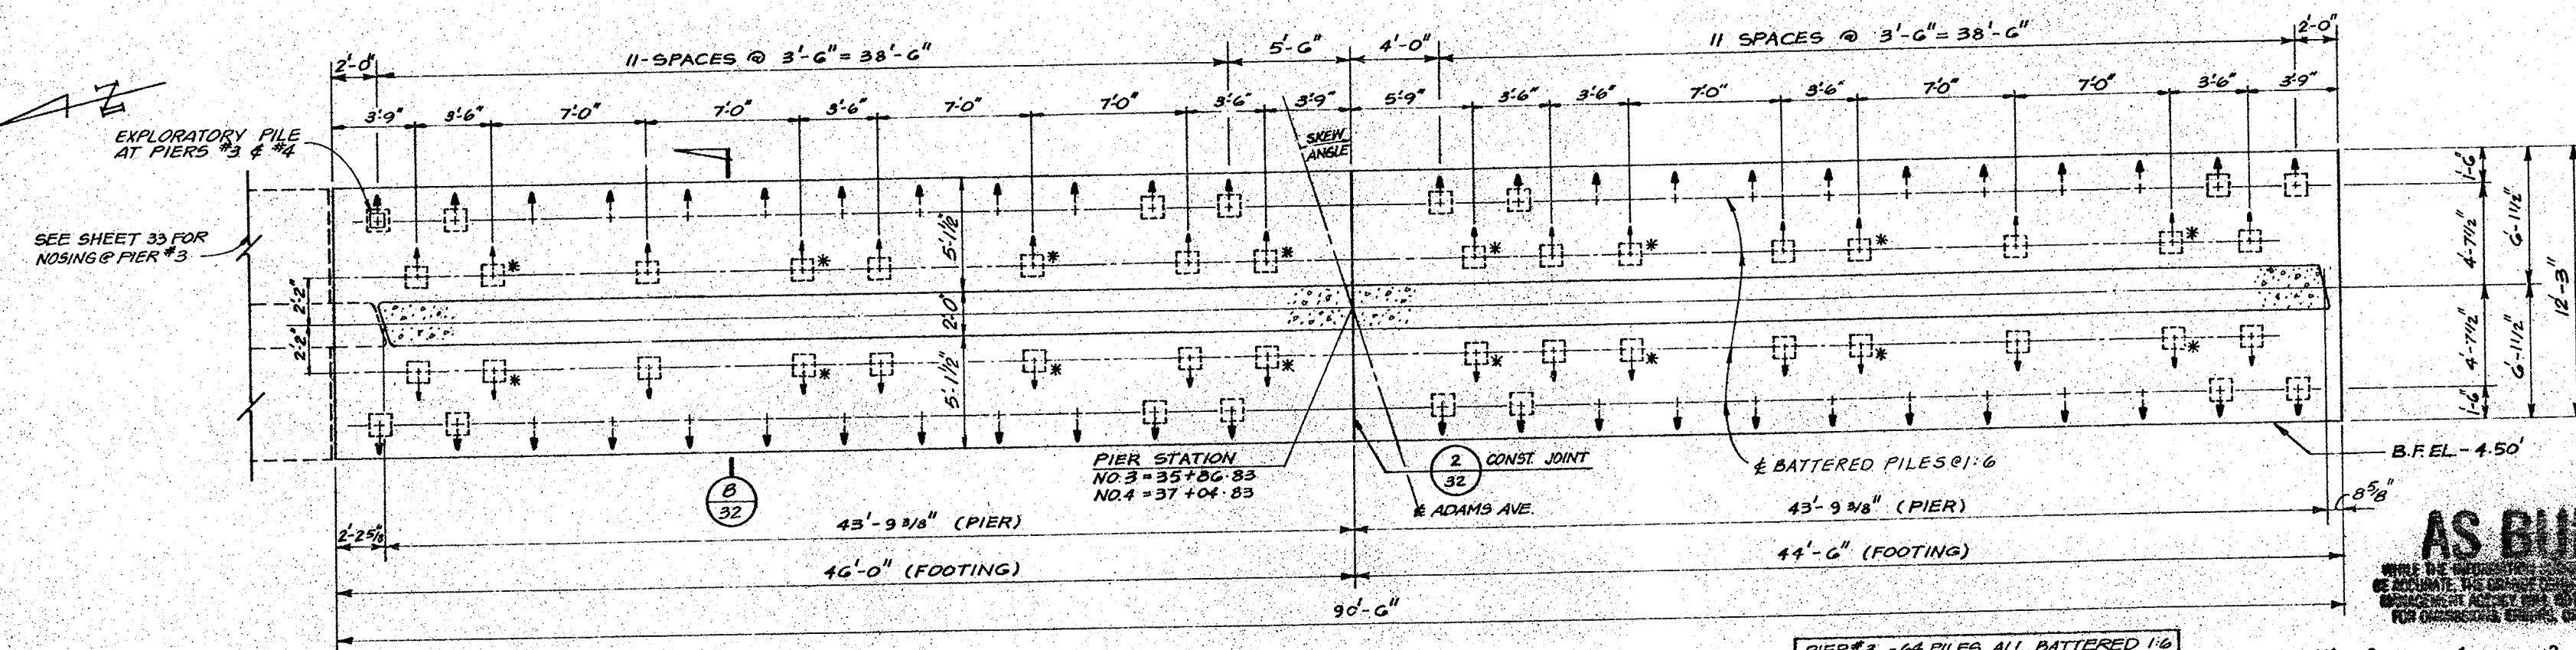

PIER NO. 3 & 4
PIER FOOTING & PILE LAYOUT-PLAN (B)
SCALE: 1/4" = 1'-0"

PIER #3 - 64 PILES ALL BATTERED 1:6
PIER #4 - 80 PILES ALL BATTERED 1:6
* OMIT PILE @ PIER #3

1 1/2 0 1 2
3 inches on original drawing

Bridge Plans
Dr. #7 13329
Sheet 26 of 53
Rev. # 24.1
Type: ** Linen

AS BUILT
WHILE THE ENGINEER'S SIGNATURE IS A GUARANTEE OF THE ACCURACY OF THE DRAWING, THE ENGINEER DOES NOT GUARANTEE THE ACCURACY OF THE FIELD DATA OR THE FIELD SURVEYING, OR THE WORKMANSHIP OF THE CONSTRUCTION.

ORANGE COUNTY
ENVIRONMENTAL MANAGEMENT AGENCY

ADAMS AVENUE BRIDGE
OVER
SANTA ANA RIVER

PIER FOOTING &
PILE LAYOUT PLANS

MARK	DATE	DESCRIPTION	PREPARED UNDER SUPERVISION OF	DATE	SHEET
DESIGNED	W.B.		RCE 6654	4/11/77	26
DRAWN	Z.S.	CHECKED	D.J.S.	APRIL 1977	OF 53