




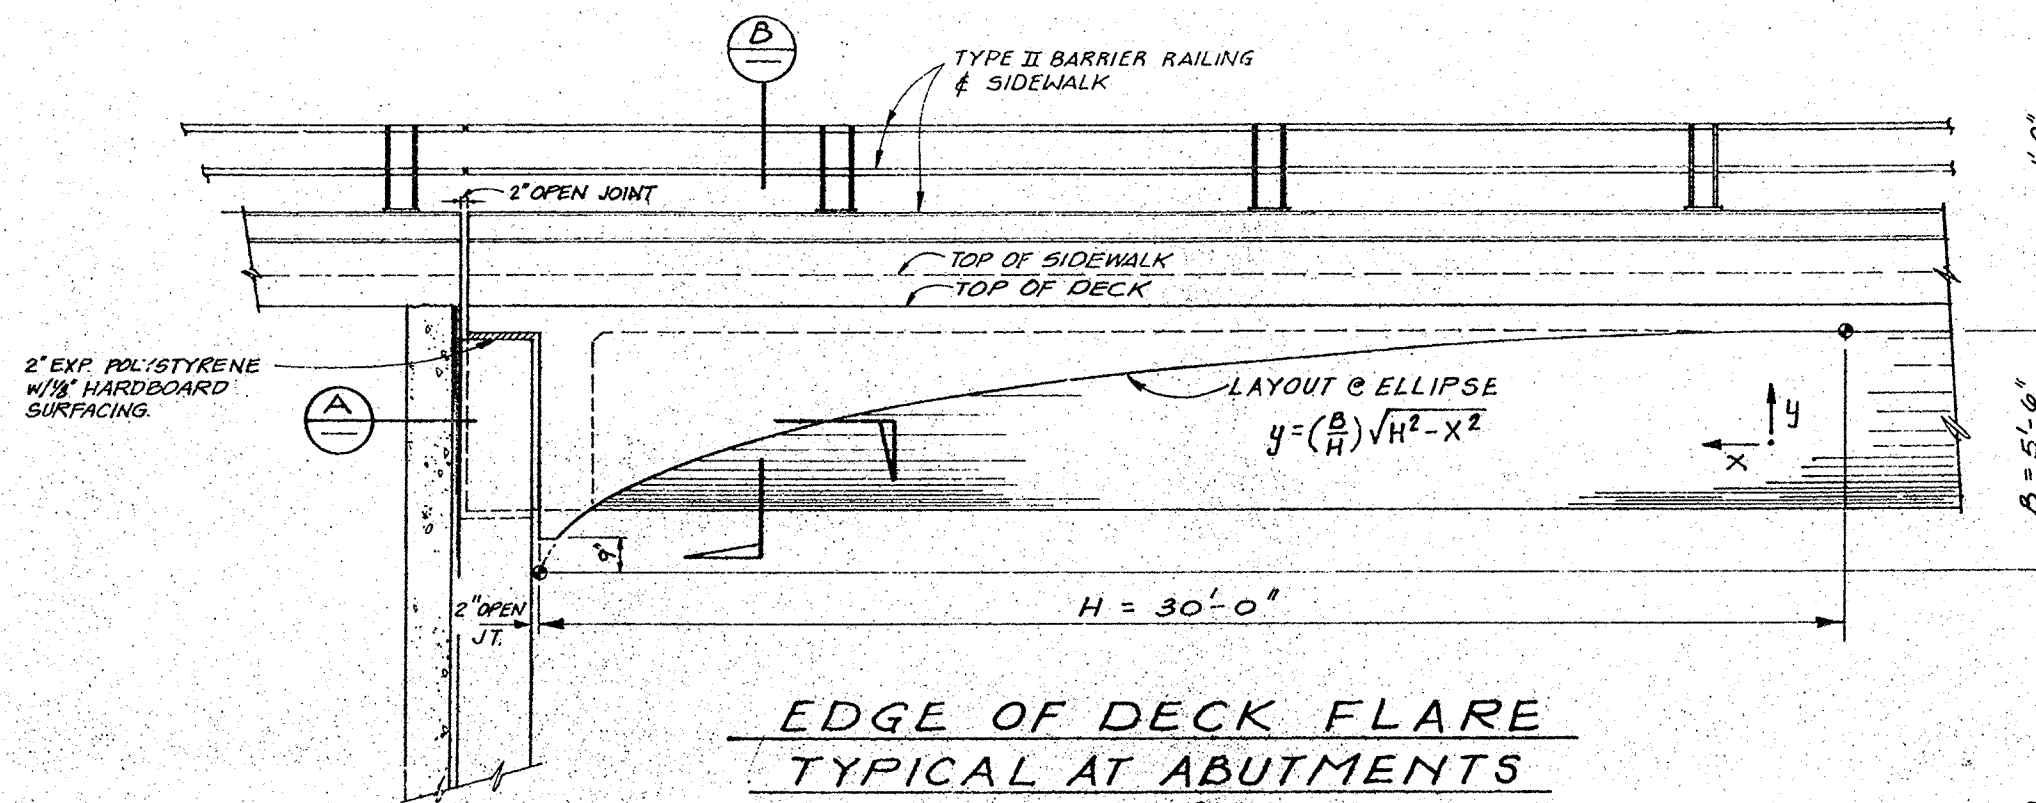


**EDGE OF DECK FLARE
TYPICAL AT ABUTMENTS**
SCALE: $\frac{3}{8}'' = 1'-0''$

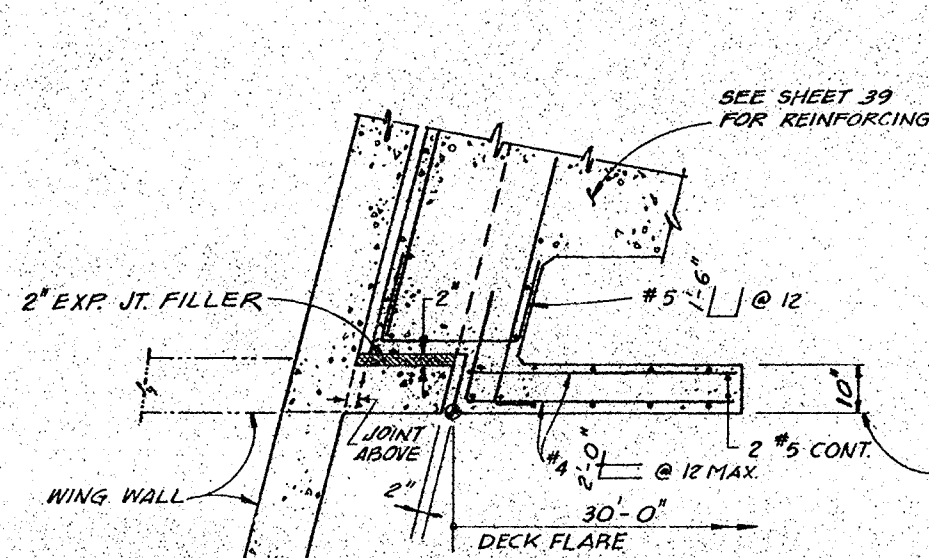


**PLAN
SECTION A**
SCALE: $\frac{1}{2}'' = 1'-0''$

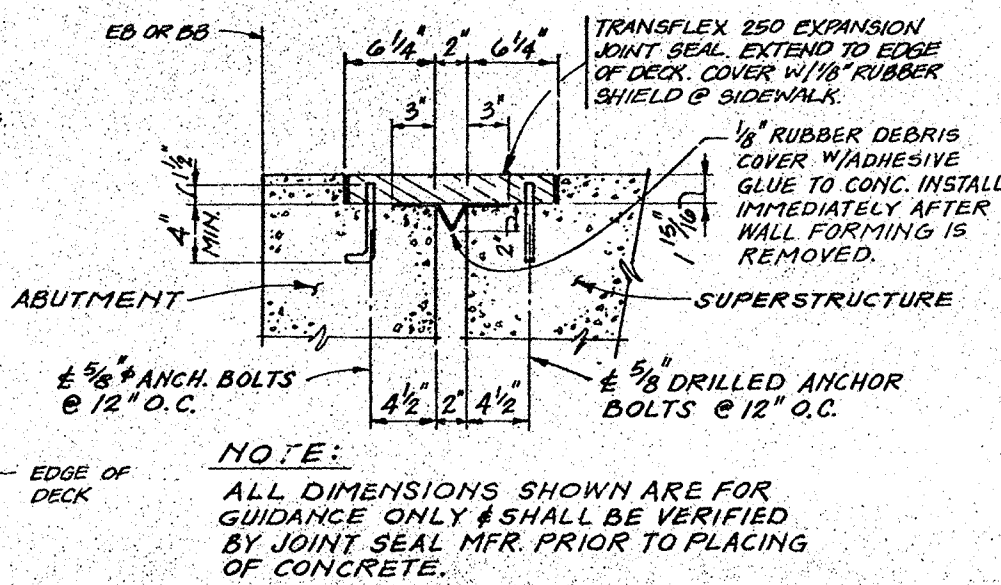


**TYPICAL EXPANSION JOINT AT
BEGINNING & END OF BRIDGE**
SCALE: $\frac{1}{2}'' = 1'-0''$

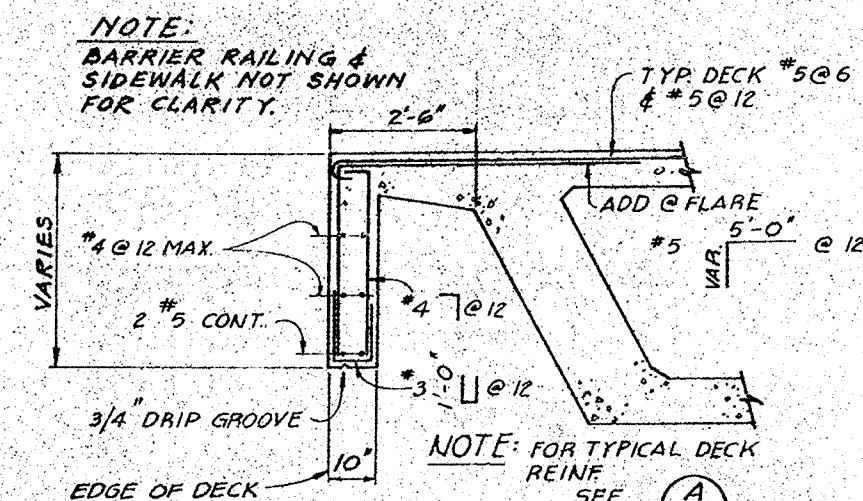


SECTION B
SCALE: $\frac{1}{2}'' = 1'-0''$

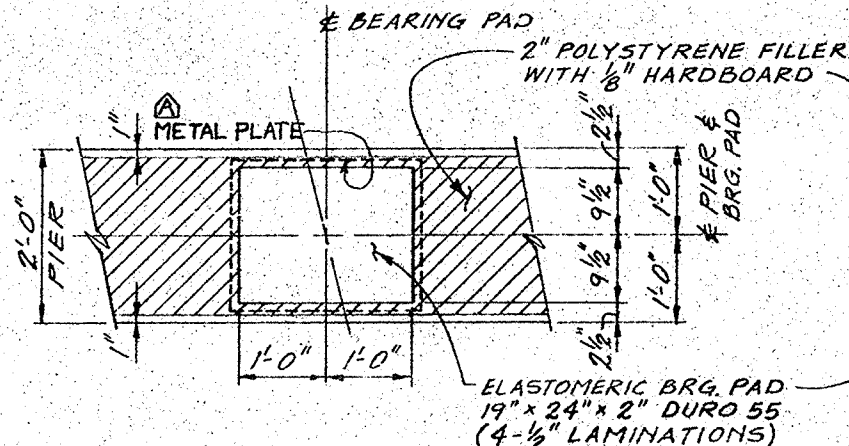


**PLAN
PIER No. 2 & 5 BEARING PAD DETAIL**
SCALE: $\frac{3}{4}'' = 1'-0''$

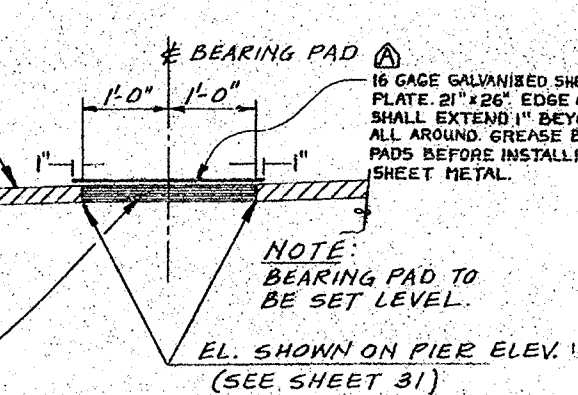

ELEVATION

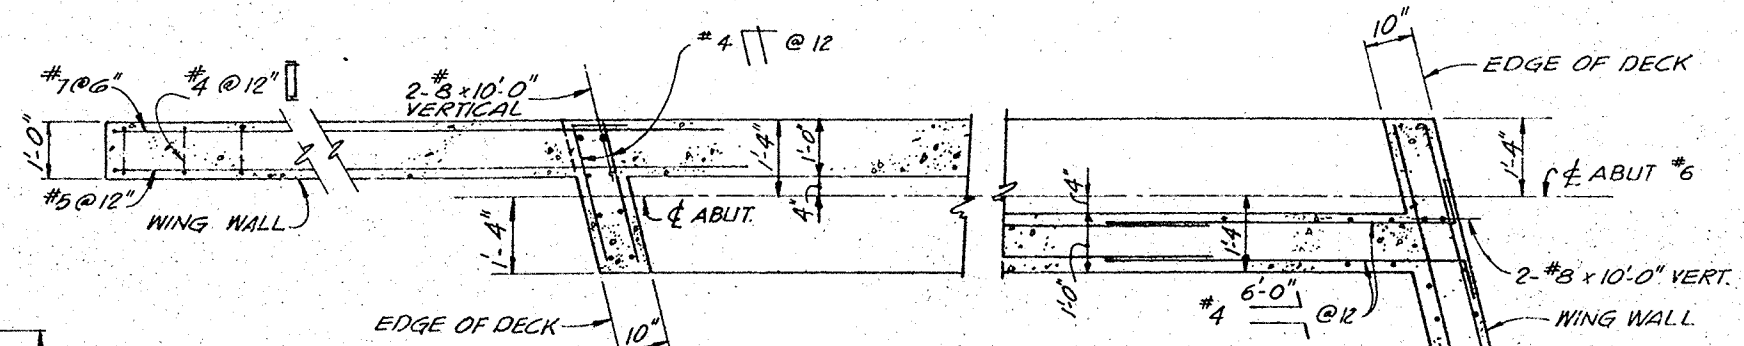


**ABUTMENT No. 1
S.W. WING WALL (SHOWN)
N.W. WING WALL (SIMILAR)**
**ABUTMENT No. 6
N.E. WING WALL (SHOWN)
S.E. WING WALL (SIMILAR)**
**PLAN
TYPICAL ABUTMENT CORNER DETAILS**
SCALE: $\frac{1}{2}'' = 1'-0''$

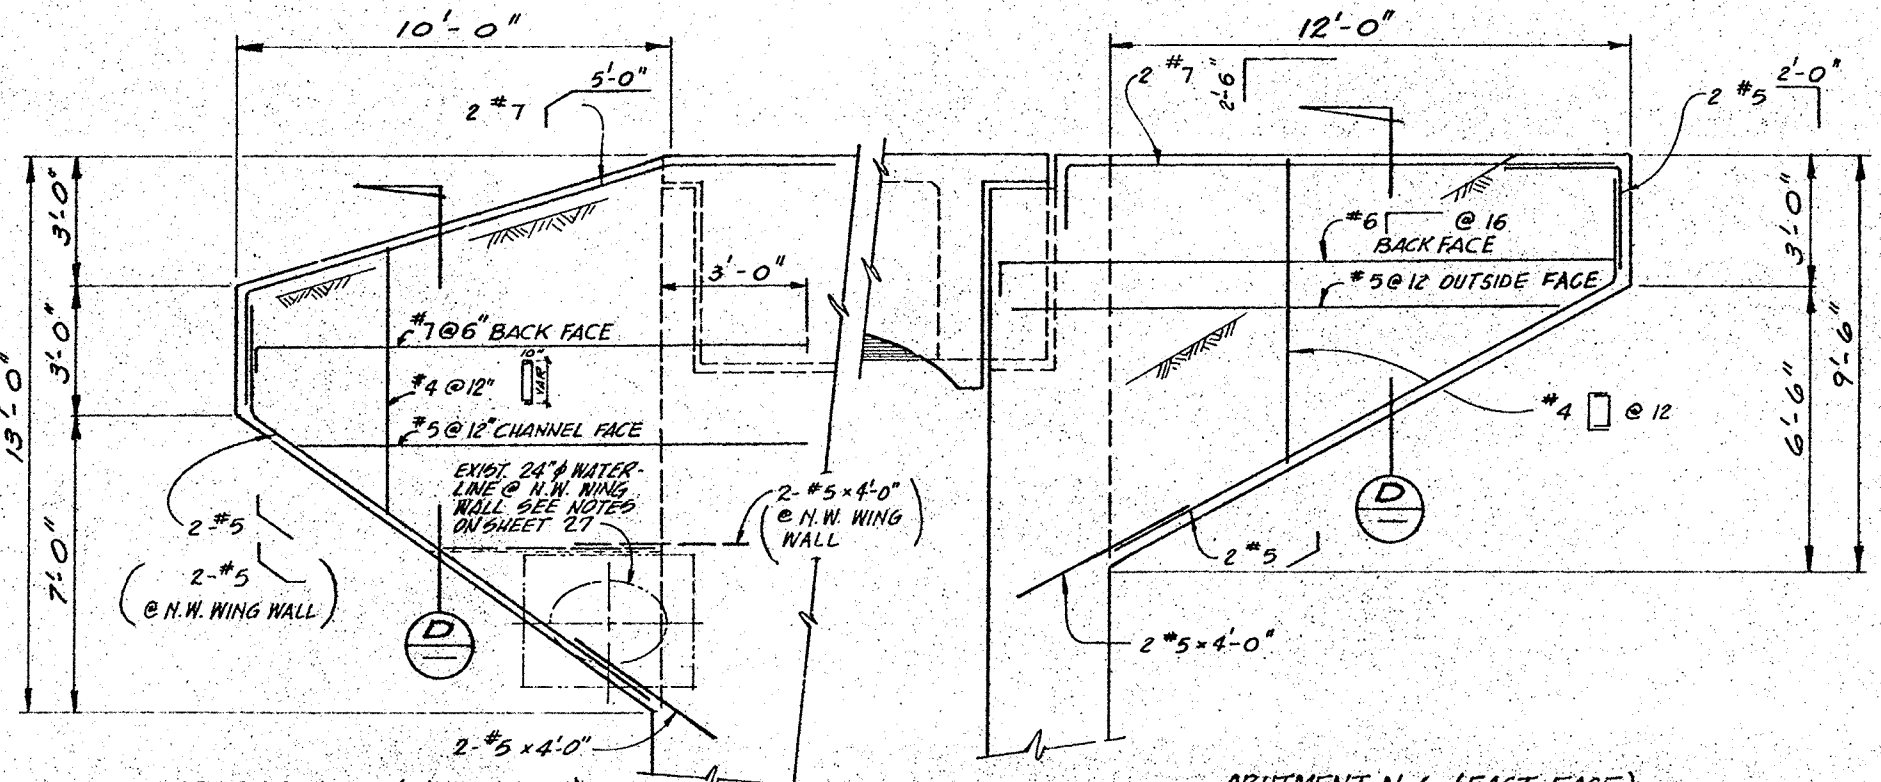

**ABUTMENT No. 1 (WEST FACE)
S.W. WING WALL (SHOWN)
N.W. WING WALL (SIMILAR)**
**ABUTMENT No. 6 (EAST FACE)
S.E. WING WALL (SHOWN)
N.E. WING WALL (SIMILAR)**

WING WALL ELEVATIONS
SCALE: $\frac{3}{8}'' = 1'-0''$

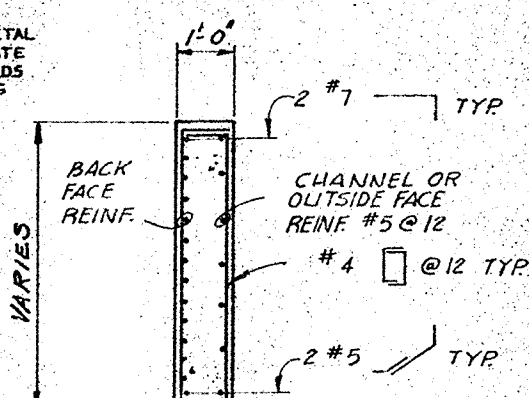

SECTION D
SCALE: $\frac{1}{2}'' = 1'-0''$

AS BUILT
WHILE THE INFORMATION CONTAINED HEREIN IS BELIEVED TO BE CORRECT, THE ENGINEER ASSUMES NO LIABILITY FOR ANY ERRORS, OMISSIONS, OR INADEQUACIES.

1 1/2 0 1 2
3 inches on original drawing

Bridge Plans
Dr. #7 13329
Sheet 30 of 53
Red: # 24.1
Type: ** Linen

ORANGE COUNTY ENVIRONMENTAL MANAGEMENT AGENCY			
ADAMS AVENUE BRIDGE OVER SANTA ANA RIVER			
ABUTMENT DETAILS - 2			
3-83 AS BUILT	DESCRIPTION	PREPARED UNDER	SHEET
MARK DATE	REVISIONS	DATE	30
DESIGNED	WAC	SCALE	DATE
DRAWN	DATE	AS SHOWN	SA 35

DR #7 13329