
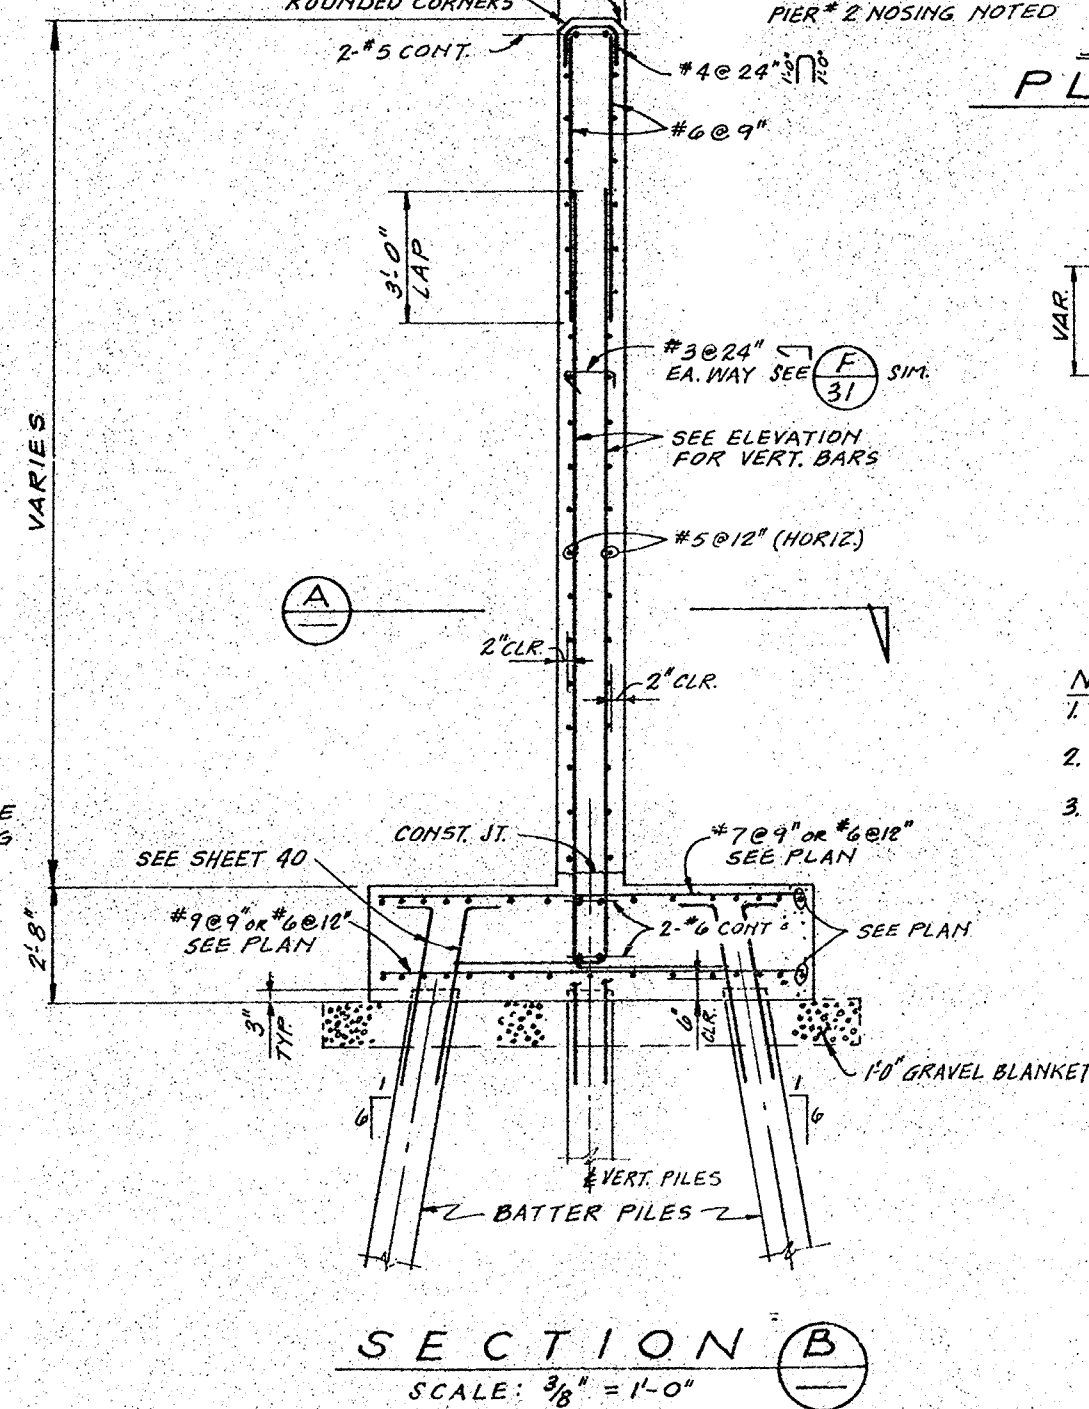
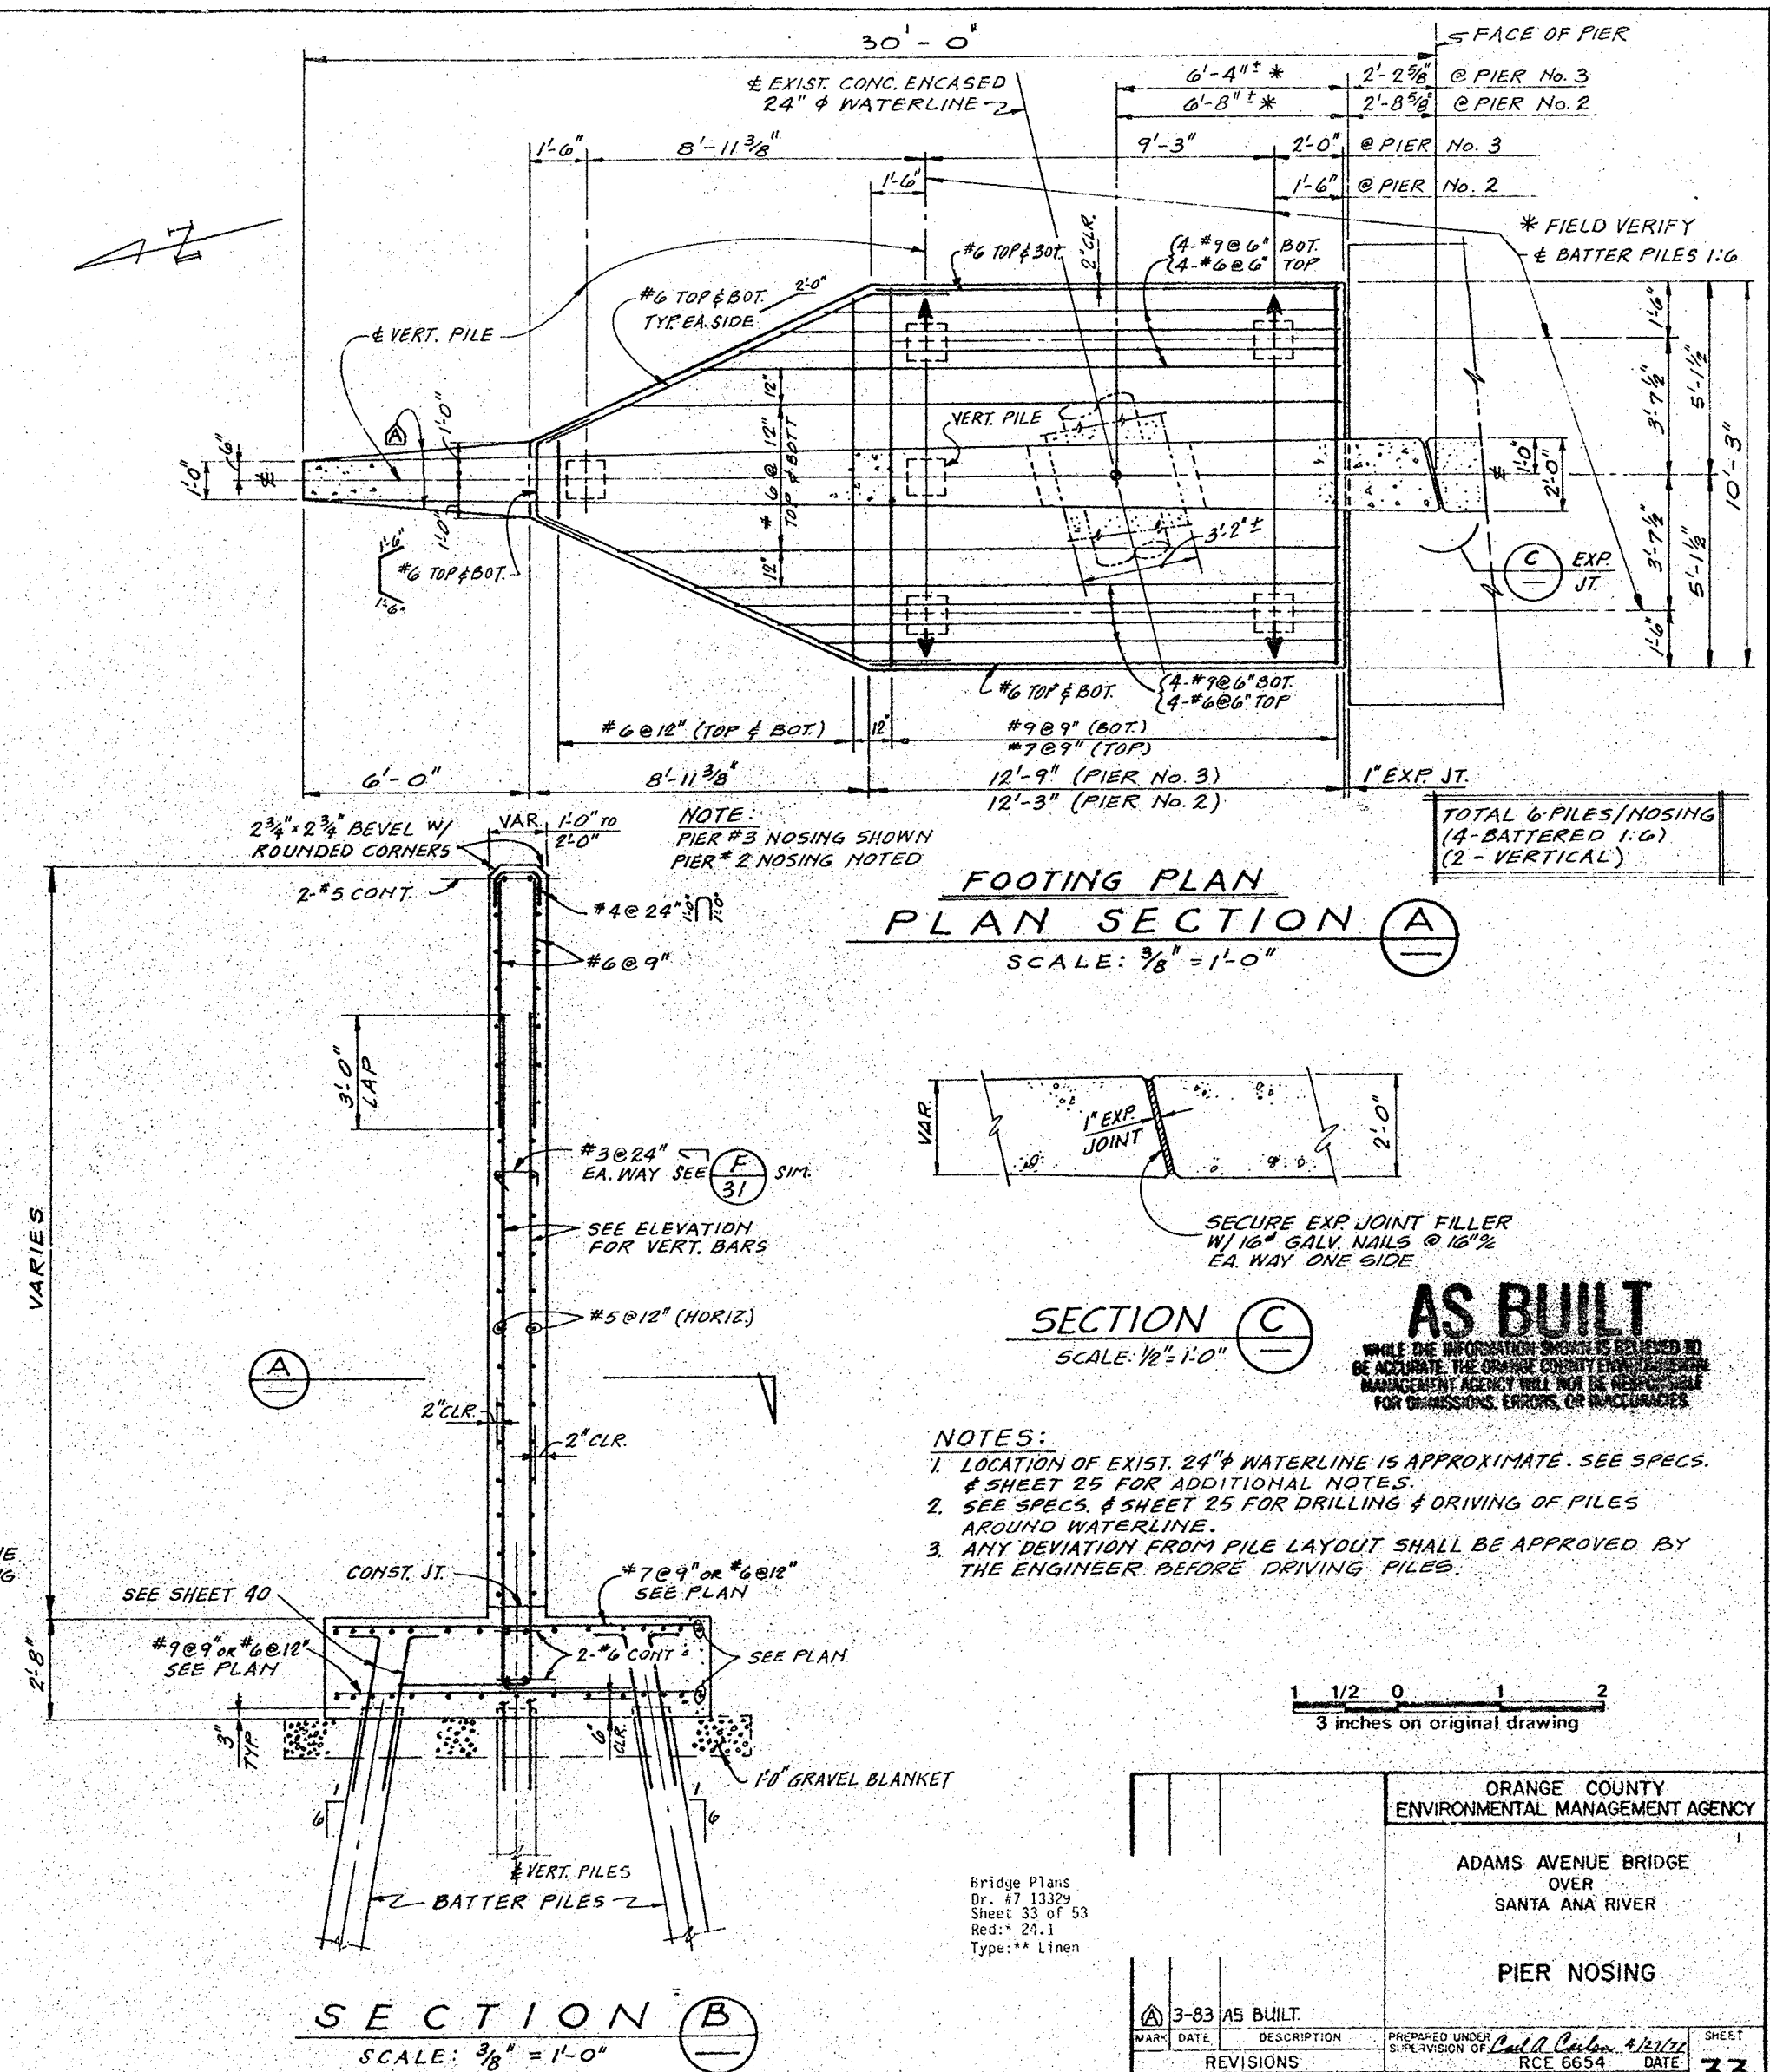


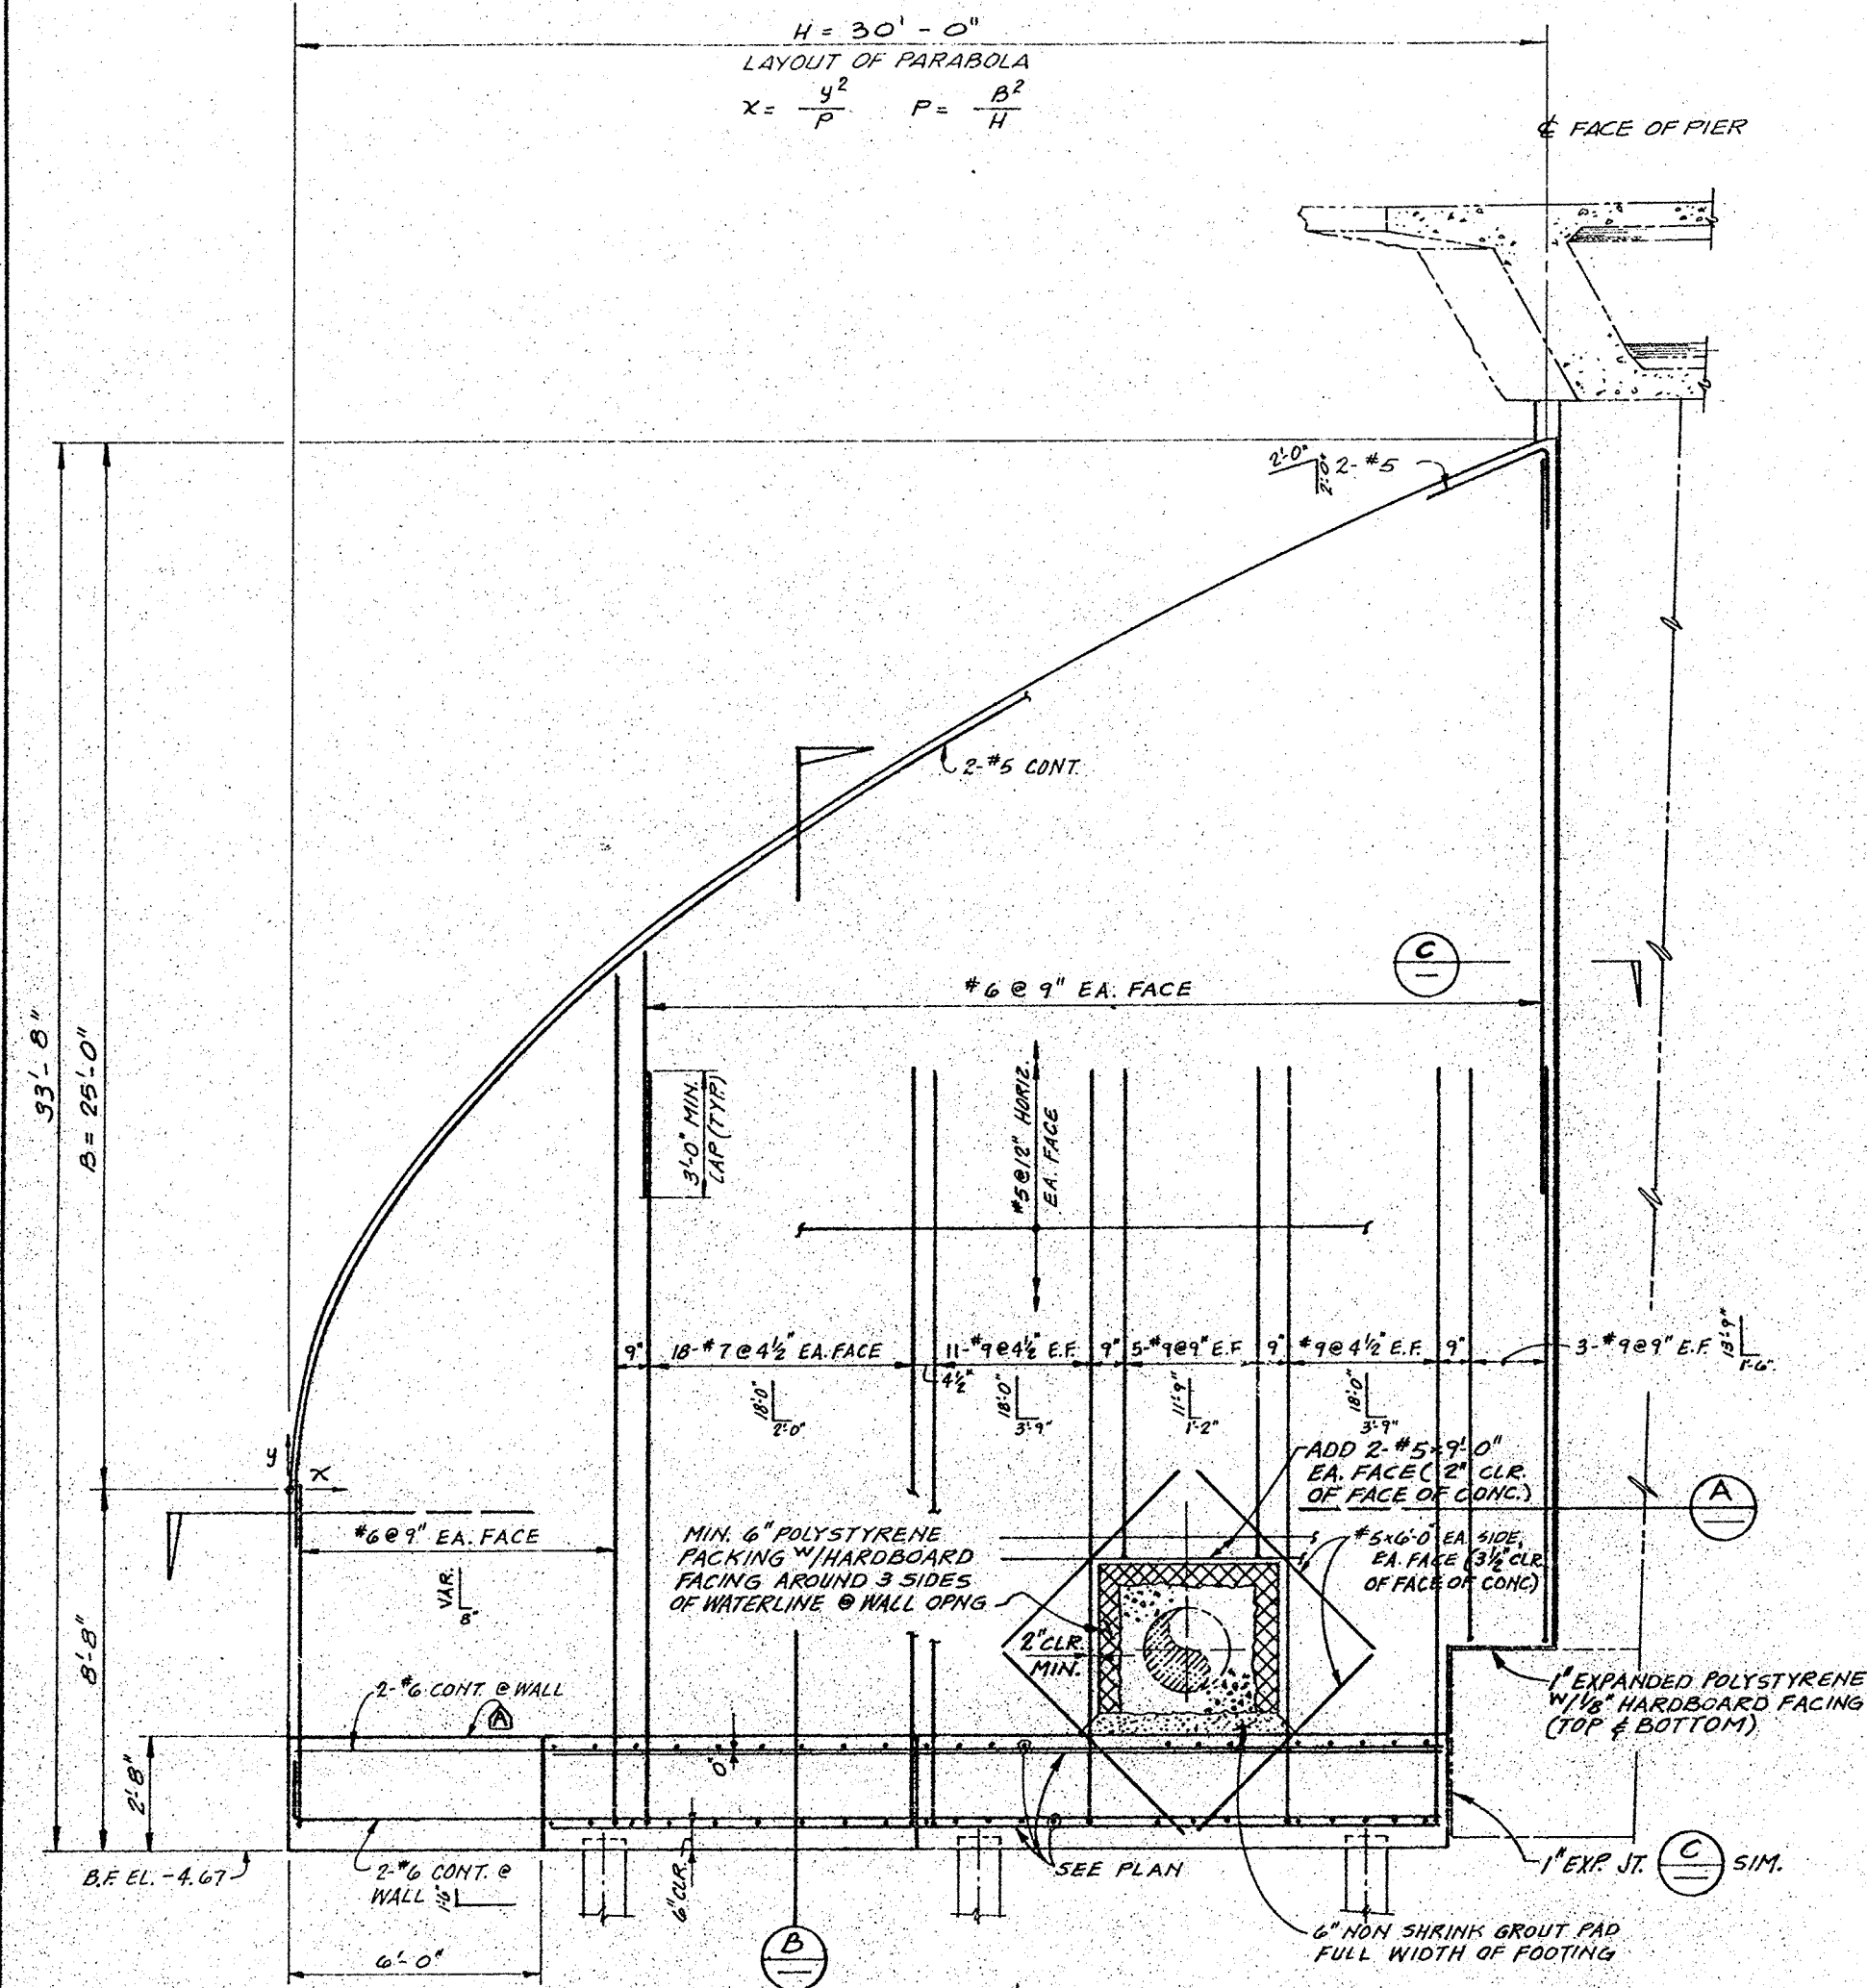

SECTION C
SCALE: 1/2" = 1'-0"

AS BUILT

WHILE THE INFORMATION SHOWN IS BELIEVED TO BE ACCURATE, THE ORANGE COUNTY ENVIRONMENTAL MANAGEMENT AGENCY WILL NOT BE RESPONSIBLE FOR OMISSIONS, ERRORS, OR INACCURACIES.

- NOTES:**
1. LOCATION OF EXIST. 24" ϕ WATERLINE IS APPROXIMATE. SEE SPECS. & SHEET 25 FOR ADDITIONAL NOTES.
 2. SEE SPECS. & SHEET 25 FOR DRILLING & DRIVING OF PILES AROUND WATERLINE.
 3. ANY DEVIATION FROM PILE LAYOUT SHALL BE APPROVED BY THE ENGINEER BEFORE DRIVING PILES.



		ORANGE COUNTY ENVIRONMENTAL MANAGEMENT AGENCY	
		ADAMS AVENUE BRIDGE OVER SANTA ANA RIVER	
		PIER NOSING	
 3-83 AS BUILT.		DESIGNED UNDER S. P. DIVISION OF <i>Paul R. Carlson 2/2/87</i>	
MARK DATE DESCRIPTION REVISIONS	RCE 6654 DATE		SHEET 33
DESIGNED J.S. DRAWN W.A.C. CHECKED D.B.S.	SCALE AS SHOWN DATE APRIL 1977		DWG. NO. S.A. 35 OF 53