
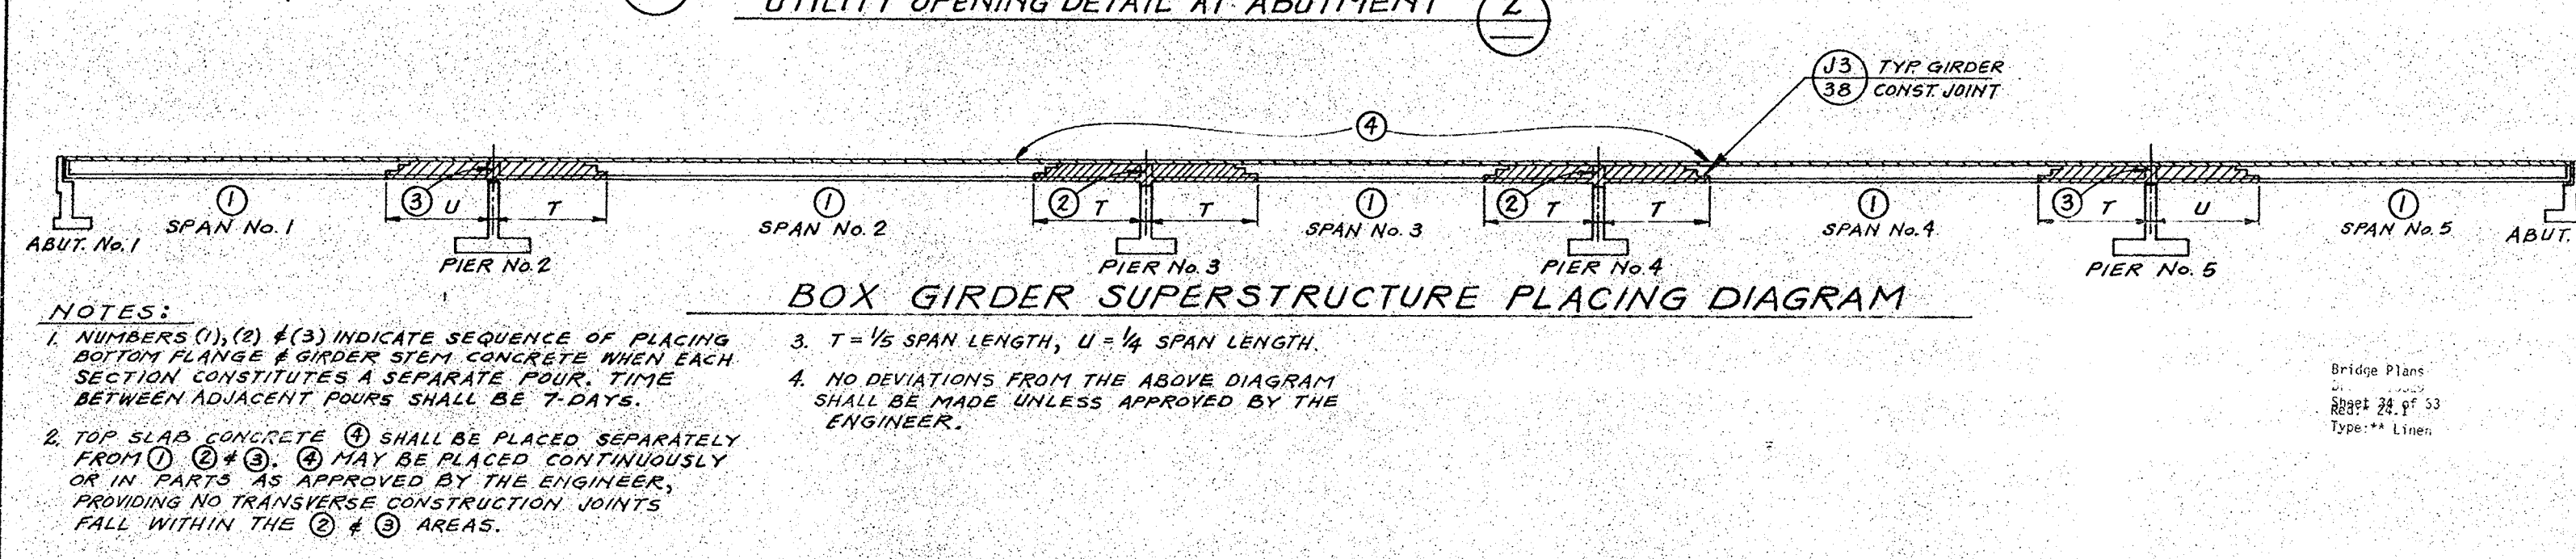
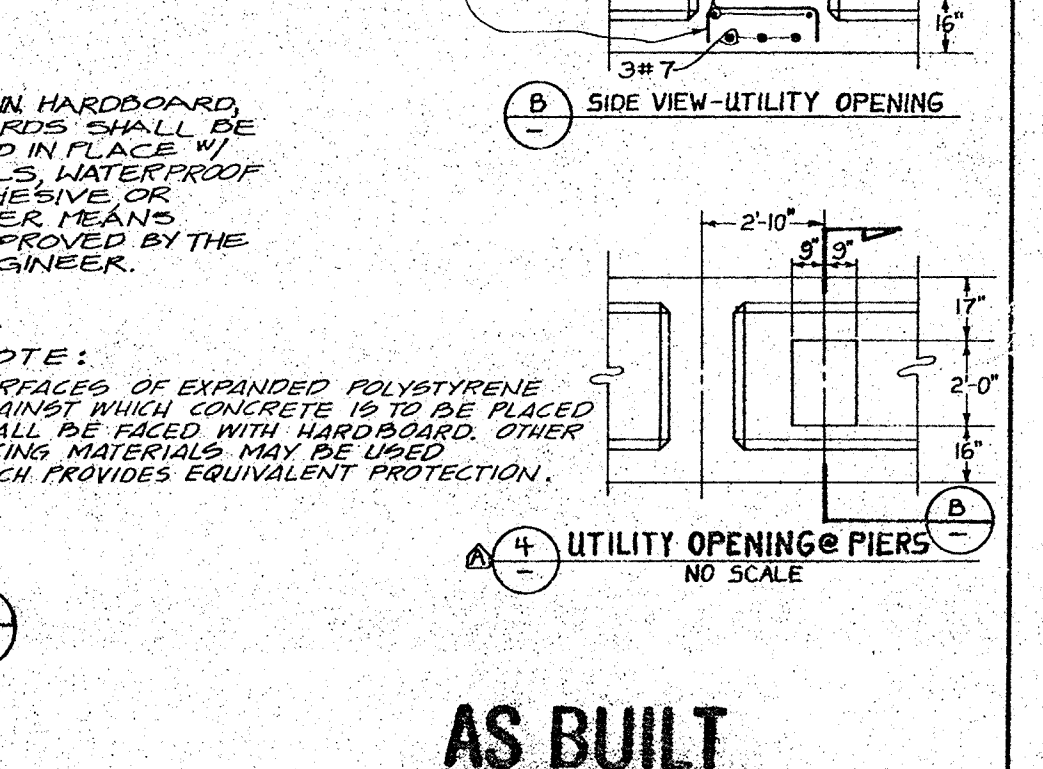
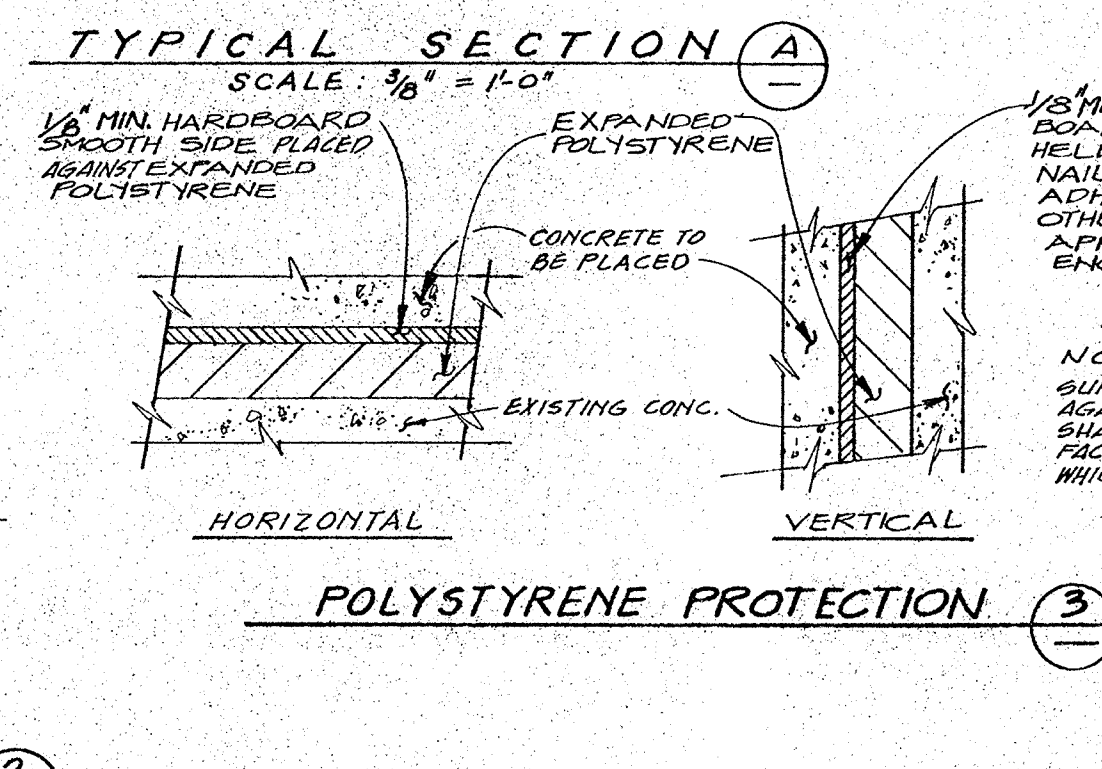
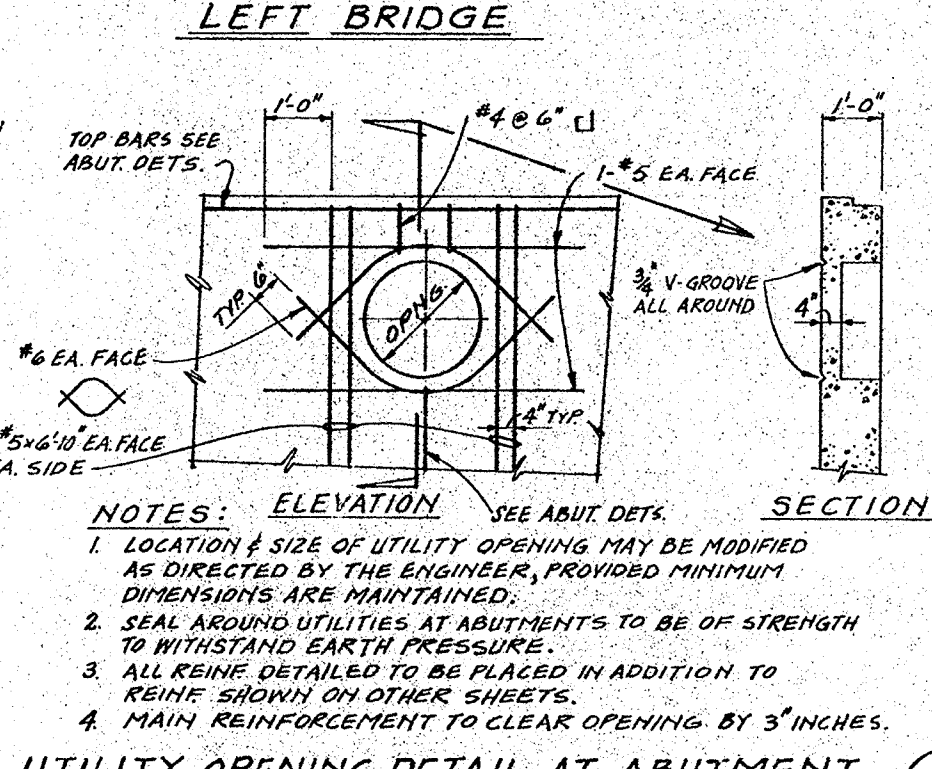
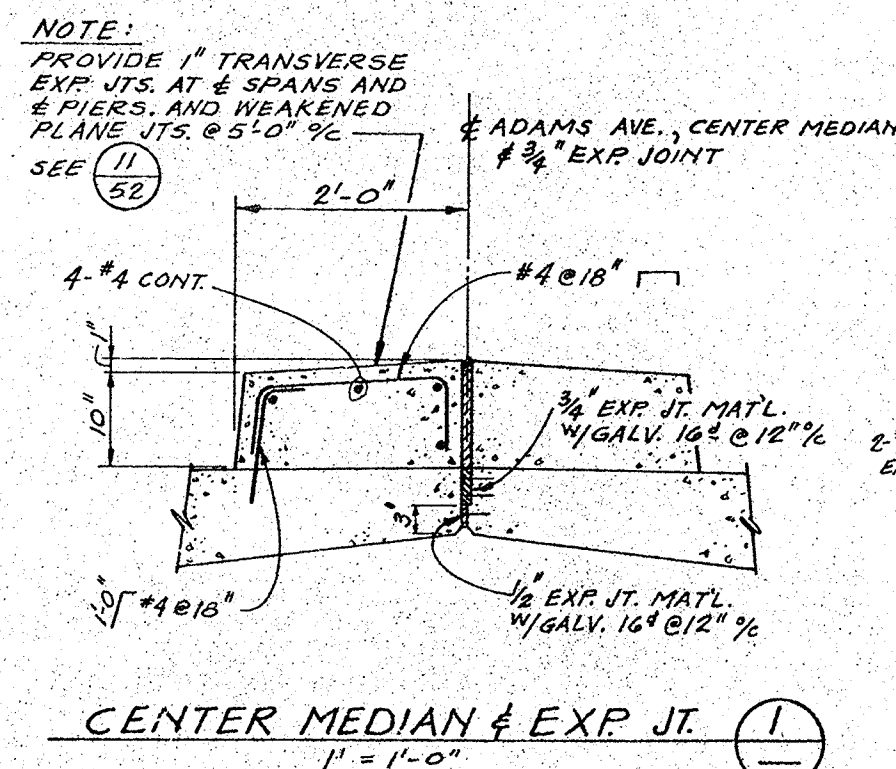


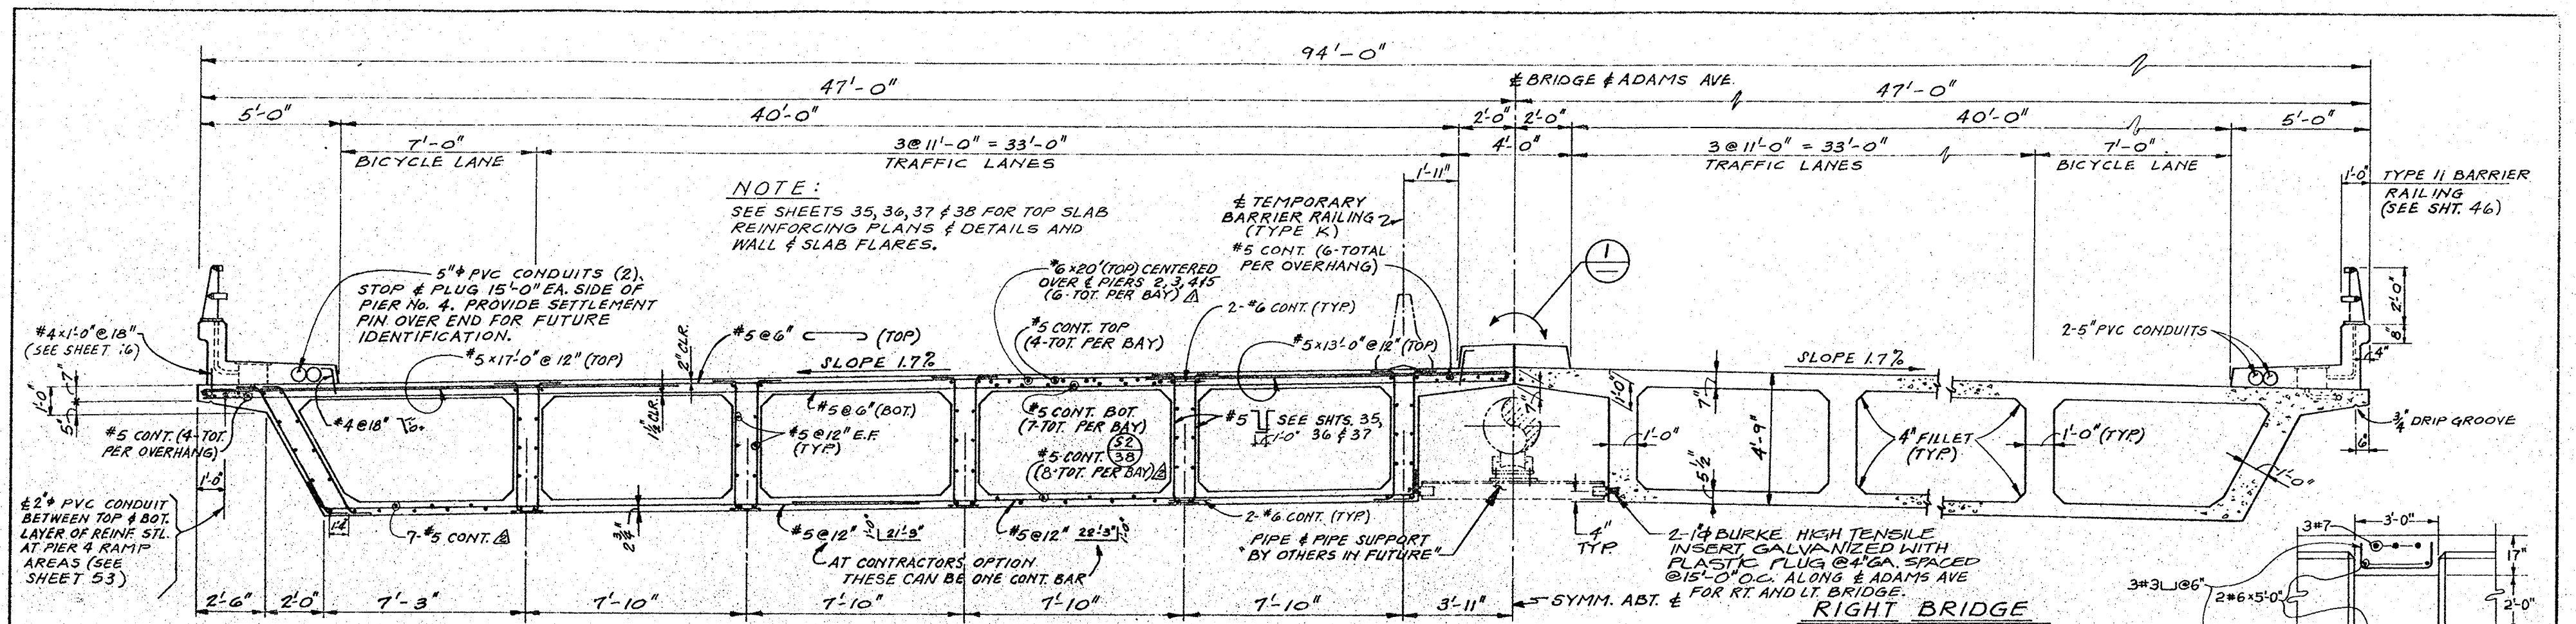

AS BUILT

WHILE THE INFORMATION SHOWN IS BELIEVED TO BE ACCURATE, THE ORANGE COUNTY ENVIRONMENTAL MANAGEMENT AGENCY WILL NOT BE RESPONSIBLE FOR OMISSIONS, ERRORS, OR IMPERFECTIONS.

ORANGE COUNTY ENVIRONMENTAL MANAGEMENT AGENCY

ADAMS AVENUE BRIDGE OVER SANTA ANA RIVER

TYPICAL SECTION

MARK	DATE	DESCRIPTION	PREPARED UNDER	SHEET
6-97	10/10/97	Additional long. reinf. over piers	RCE 6654	34
6-97	10/10/97	Additional long. reinf. in bottom slab	RCE 6654	34
3-83	AS BUILT		RCE 6654	34

DESIGNED: J.S. DATE: APRIL 1977 SCALE: S.A. 35
DRAWN: W.A.C. CHECKED: D.J.S. AS SHOWN: APRIL 1977