

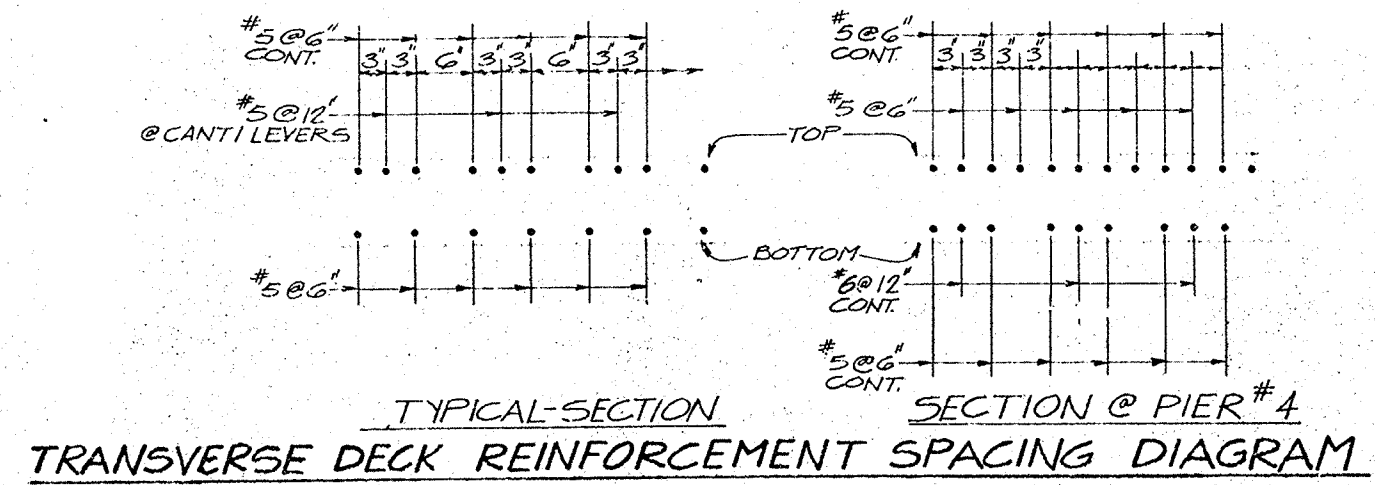
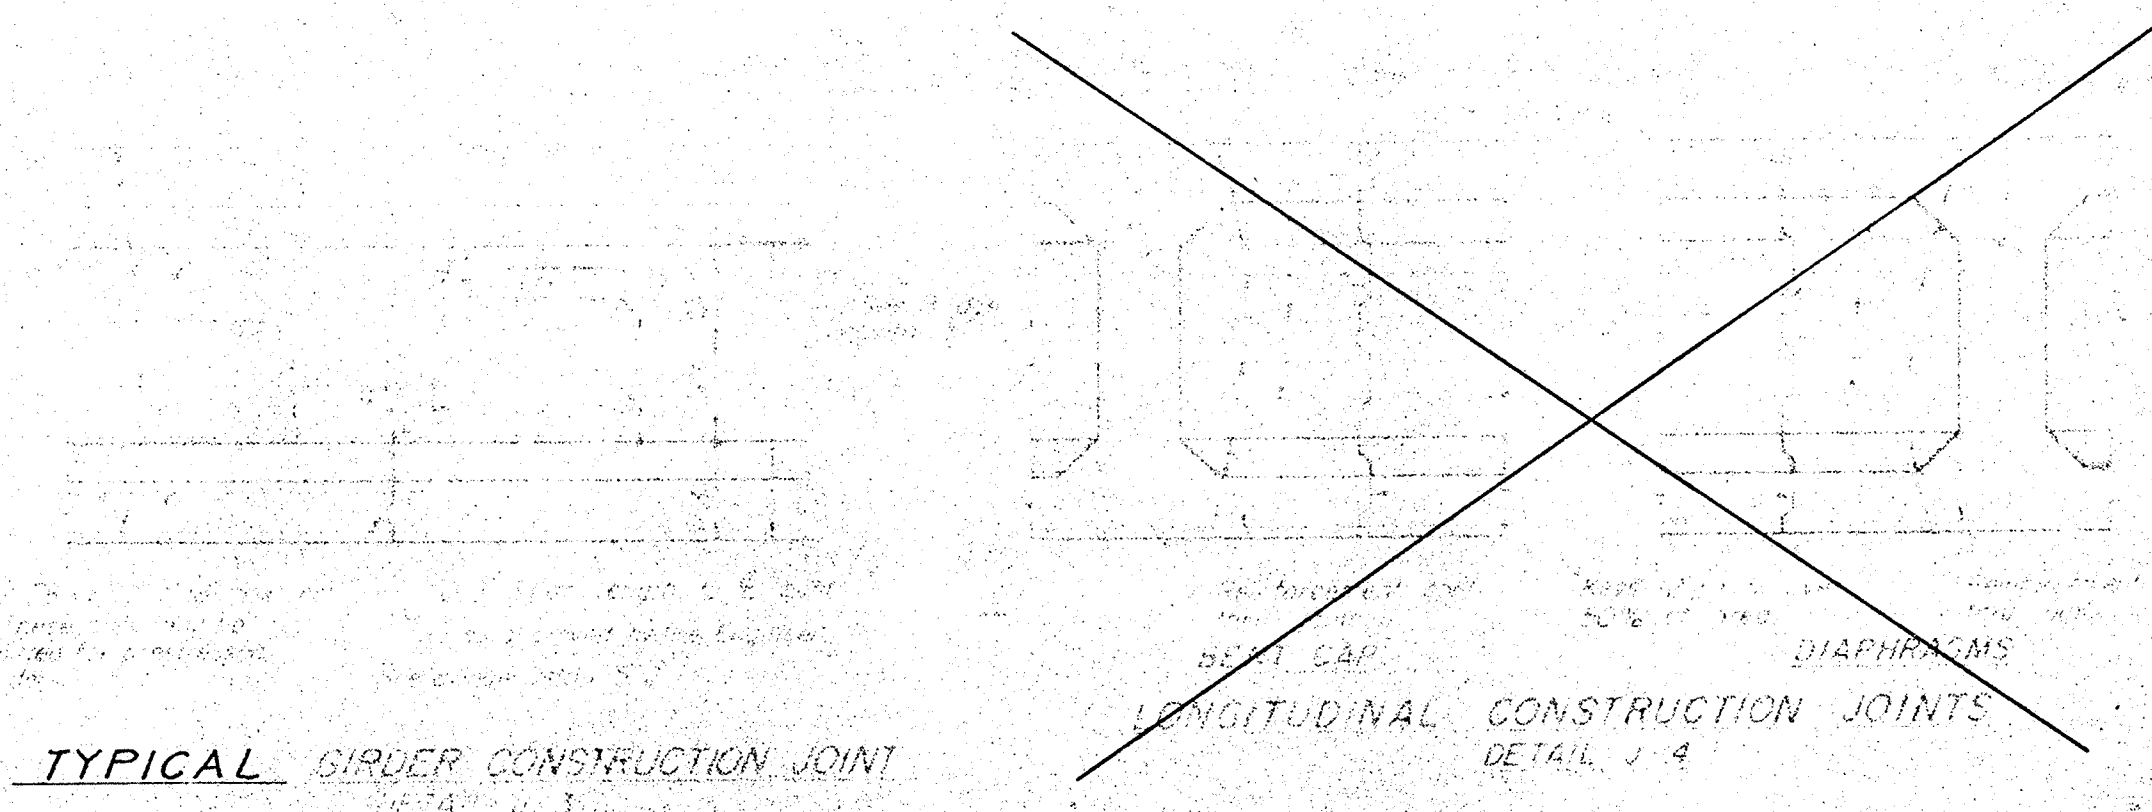
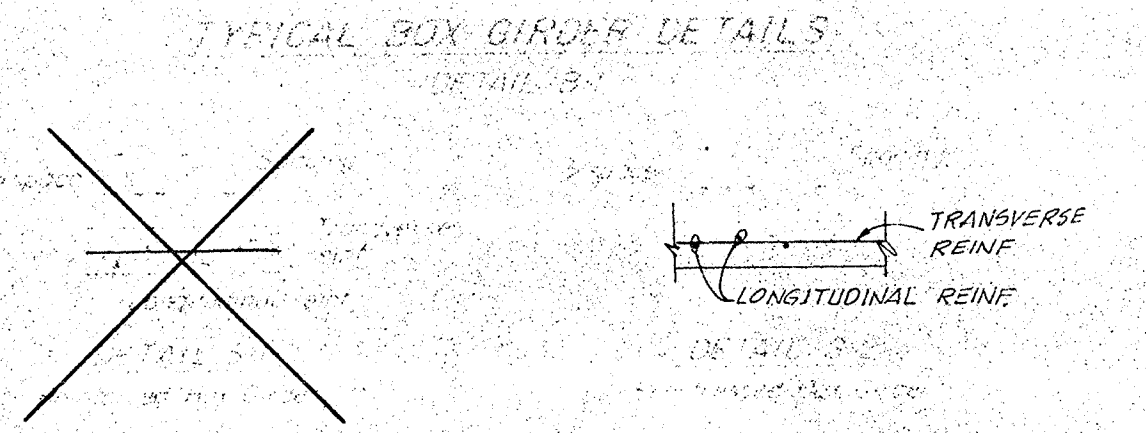
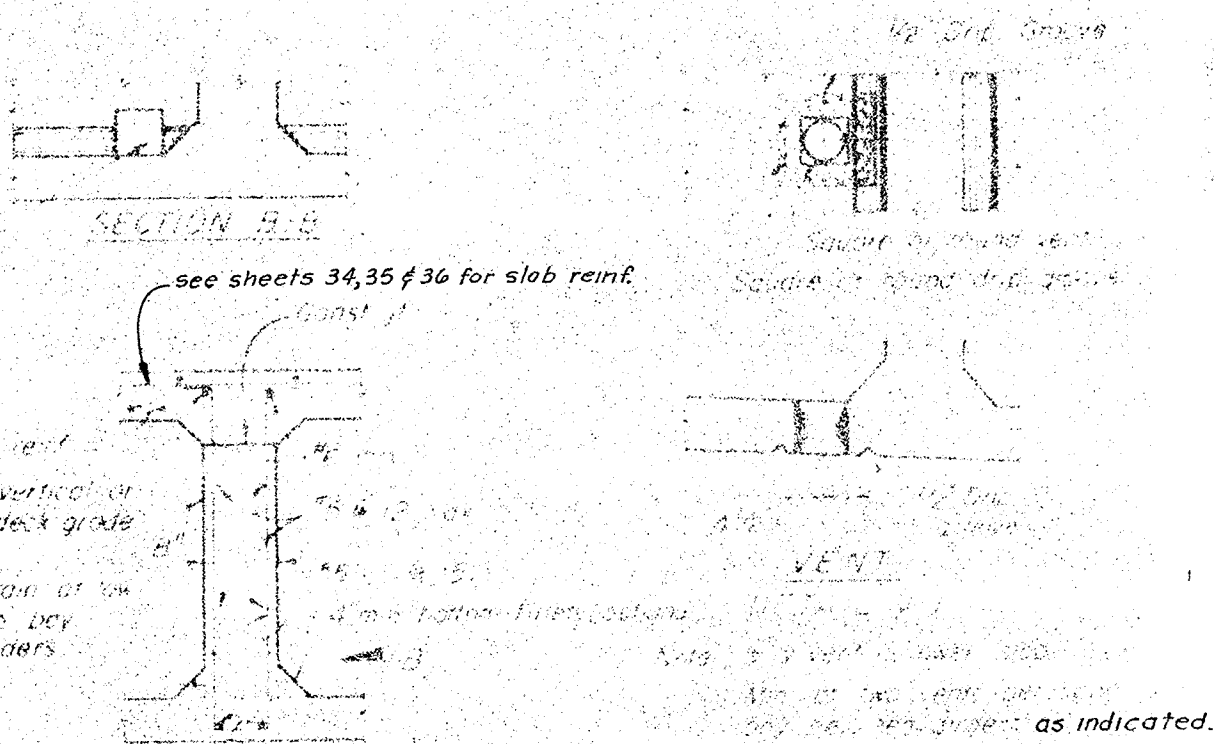
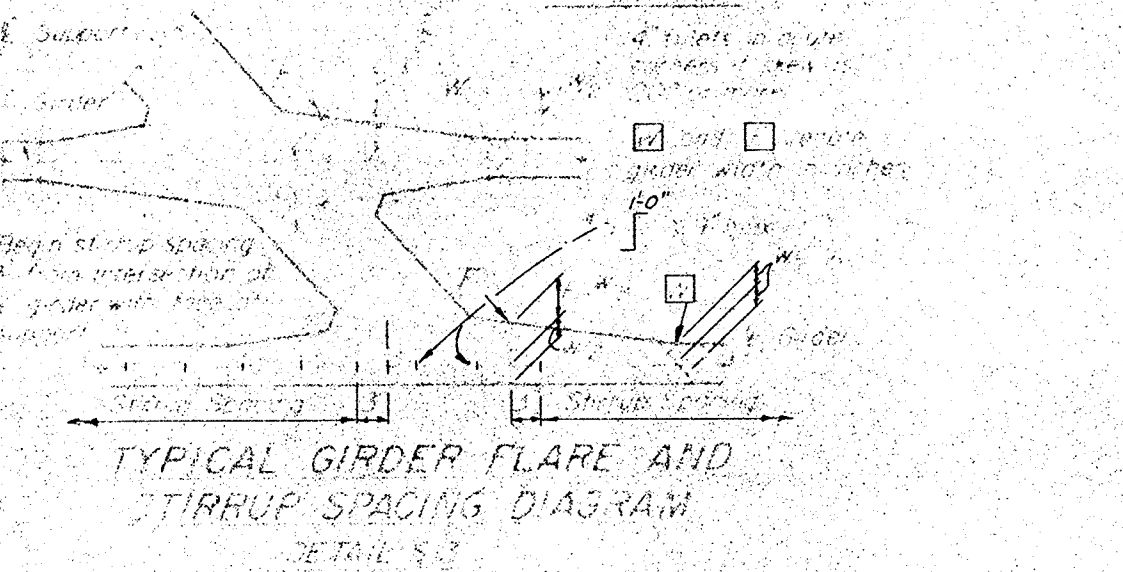
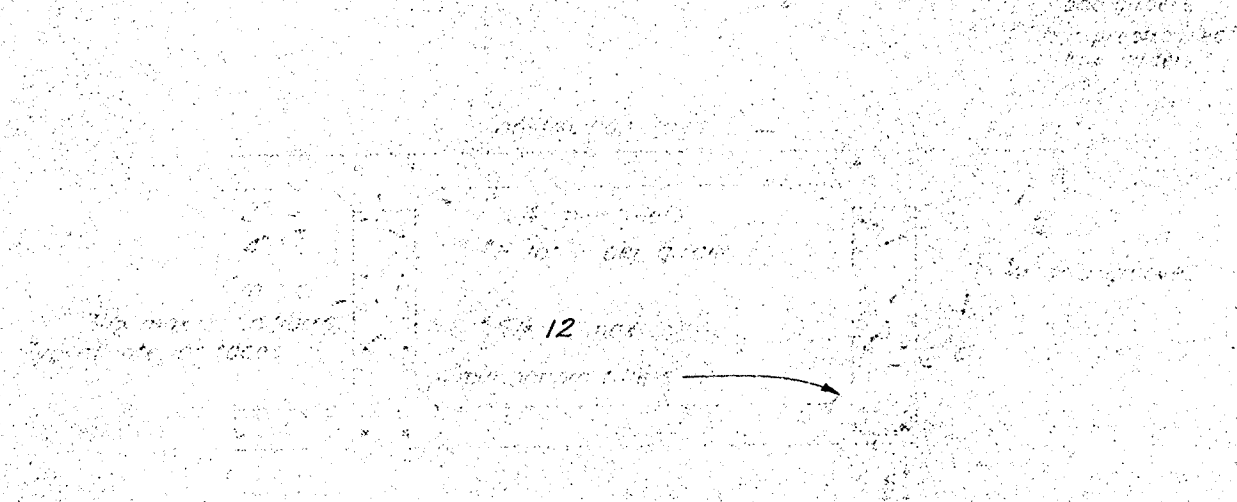


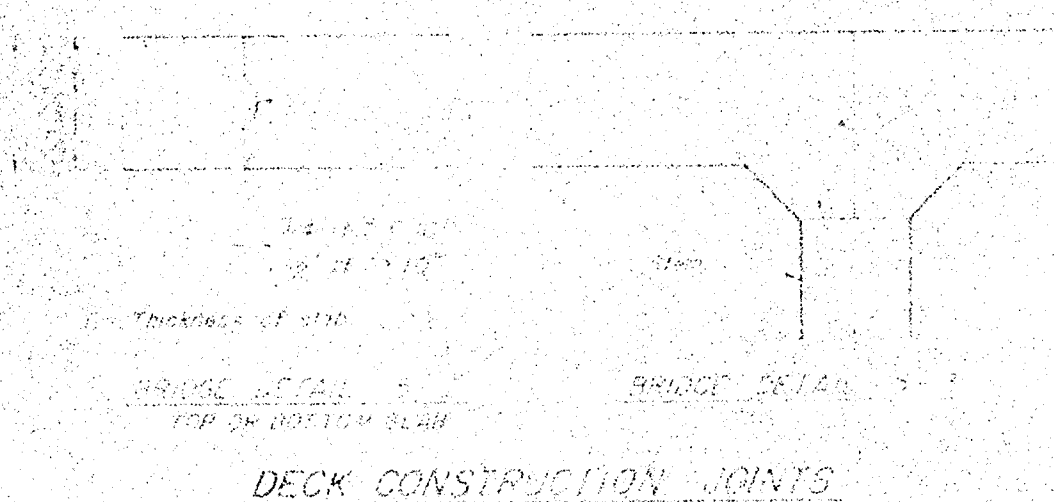

AS BUILT
WHILE THE INFORMATION SHOWN IS BELIEVED TO BE ACCURATE, THE ORANGE COUNTY ENVIRONMENTAL MANAGEMENT AGENCY WILL NOT BE RESPONSIBLE FOR OMISSIONS, ERRORS, OR INACCURACIES.

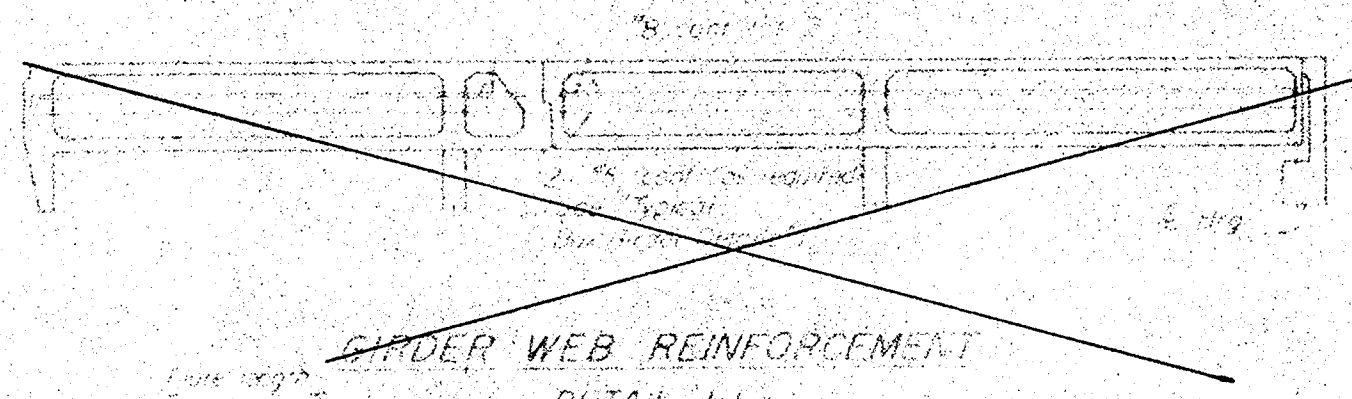

ORANGE COUNTY ENVIRONMENTAL MANAGEMENT AGENCY			
ADAMS AVENUE BRIDGE OVER SANTA ANA RIVER			
GIRDER DETAILS			
MARK	DATE	DESCRIPTION	PREPARED UNDER SUPERVISION OF
REVISIONS		DATE	SHEET
DESIGNED	STU	SCALE	DATE
DRAWN	CHECKED	DATE	DWG. NO.
AS SHOWN		APRIL 1977	S.A. 35
OF 53			

3247 13329