



COSTA MESA - SOUTH SIDE

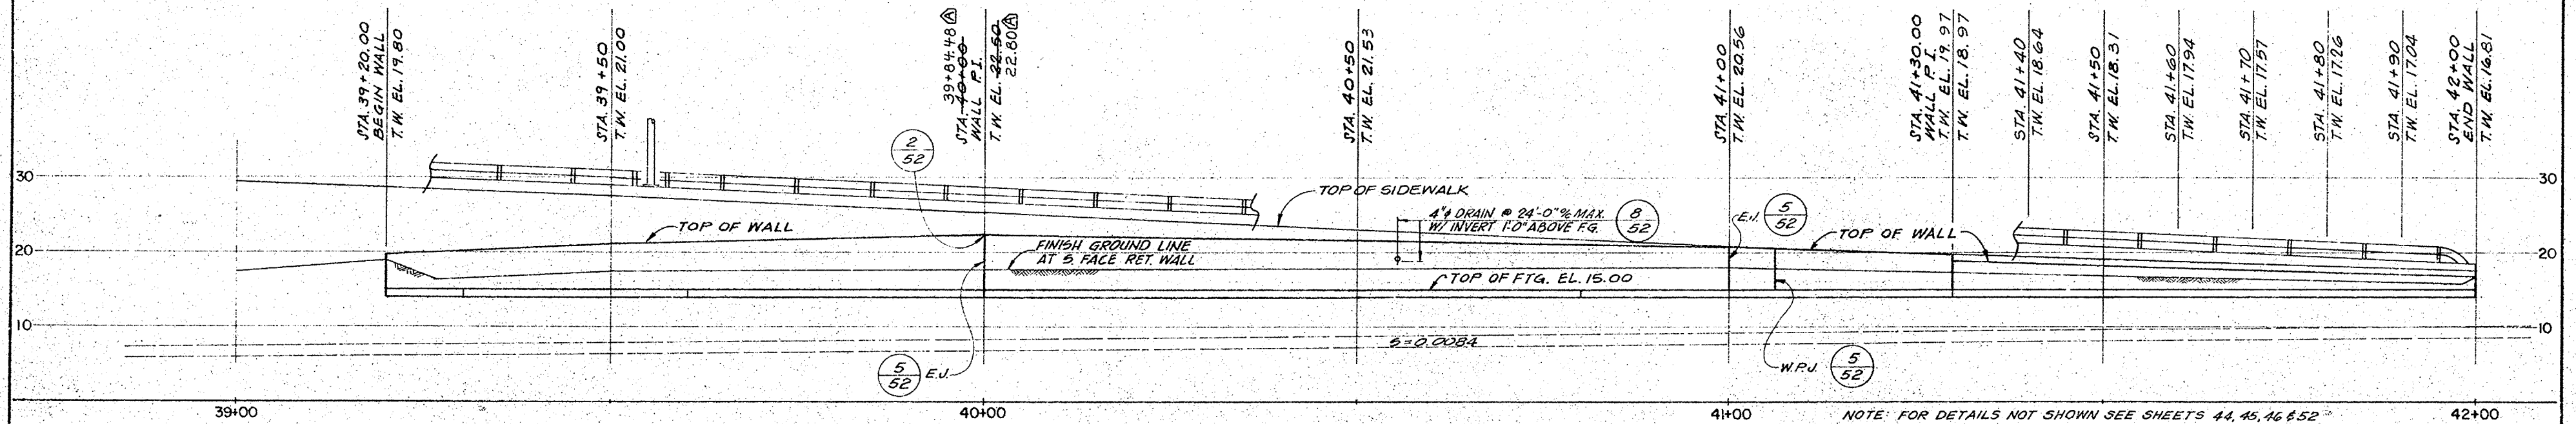

ELEVATION
SCALE: 1" = 10'-0"

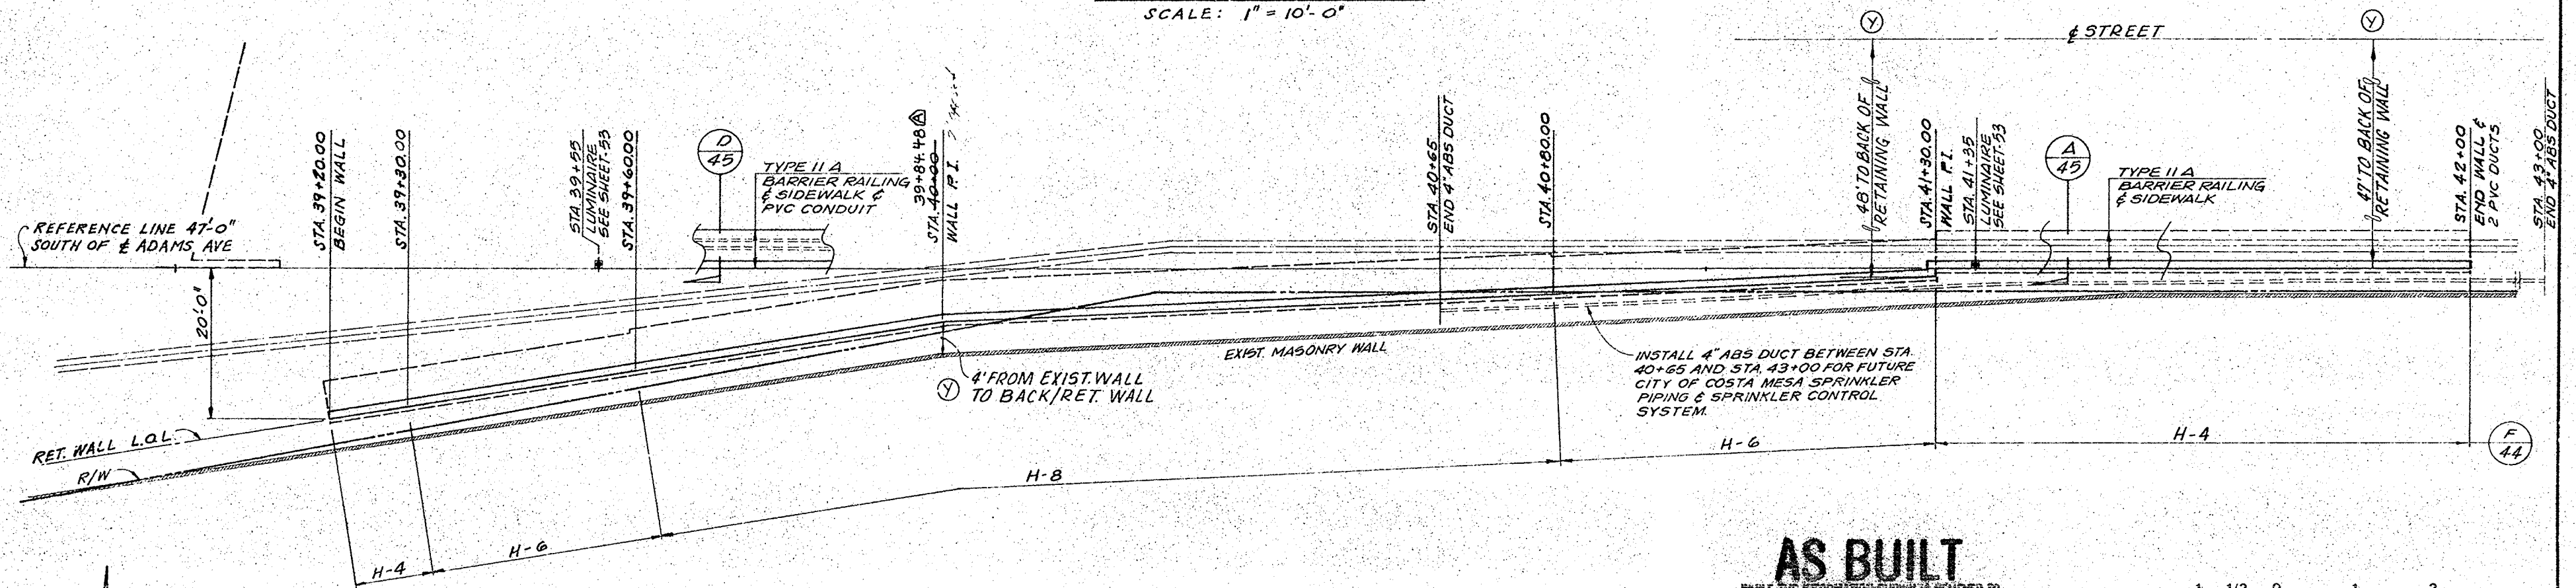

PLAN
SCALE: 1" = 10'-0"

AS BUILT
WHILE THE INFORMATION SHOWN IS BELIEVED TO BE ACCURATE, THE ORANGE COUNTY ENVIRONMENTAL MANAGEMENT AGENCY WILL NOT BE RESPONSIBLE FOR OMISSIONS, ERRORS, OR INACCURACIES.

Bridge Plans
Dr. #7 13329
Sheet 43 of 53
Rev. # 24.1
Type: ** Linen

1 1/2 0 1 2
3 inches on original drawing

8-277 3-83 Dimensions to ret. wall AS BUILT		ORANGE COUNTY ENVIRONMENTAL MANAGEMENT AGENCY ADAMS AVENUE BRIDGE OVER SANTA ANA RIVER RETAINING WALL - 3	
MARK	DATE	DESCRIPTION	PREPARED UNDER SUPERVISION OF
REVISIONS		DATE	RCE 6654
DESIGNED	W.B.	SCALE	DATE
DRAWN	W.A.C.	CHECKED	D.S.S.
AS SHOWN		APRIL 1977	DWS. NO. S.A. 35
SHEET		43	OF 53

247 13329