



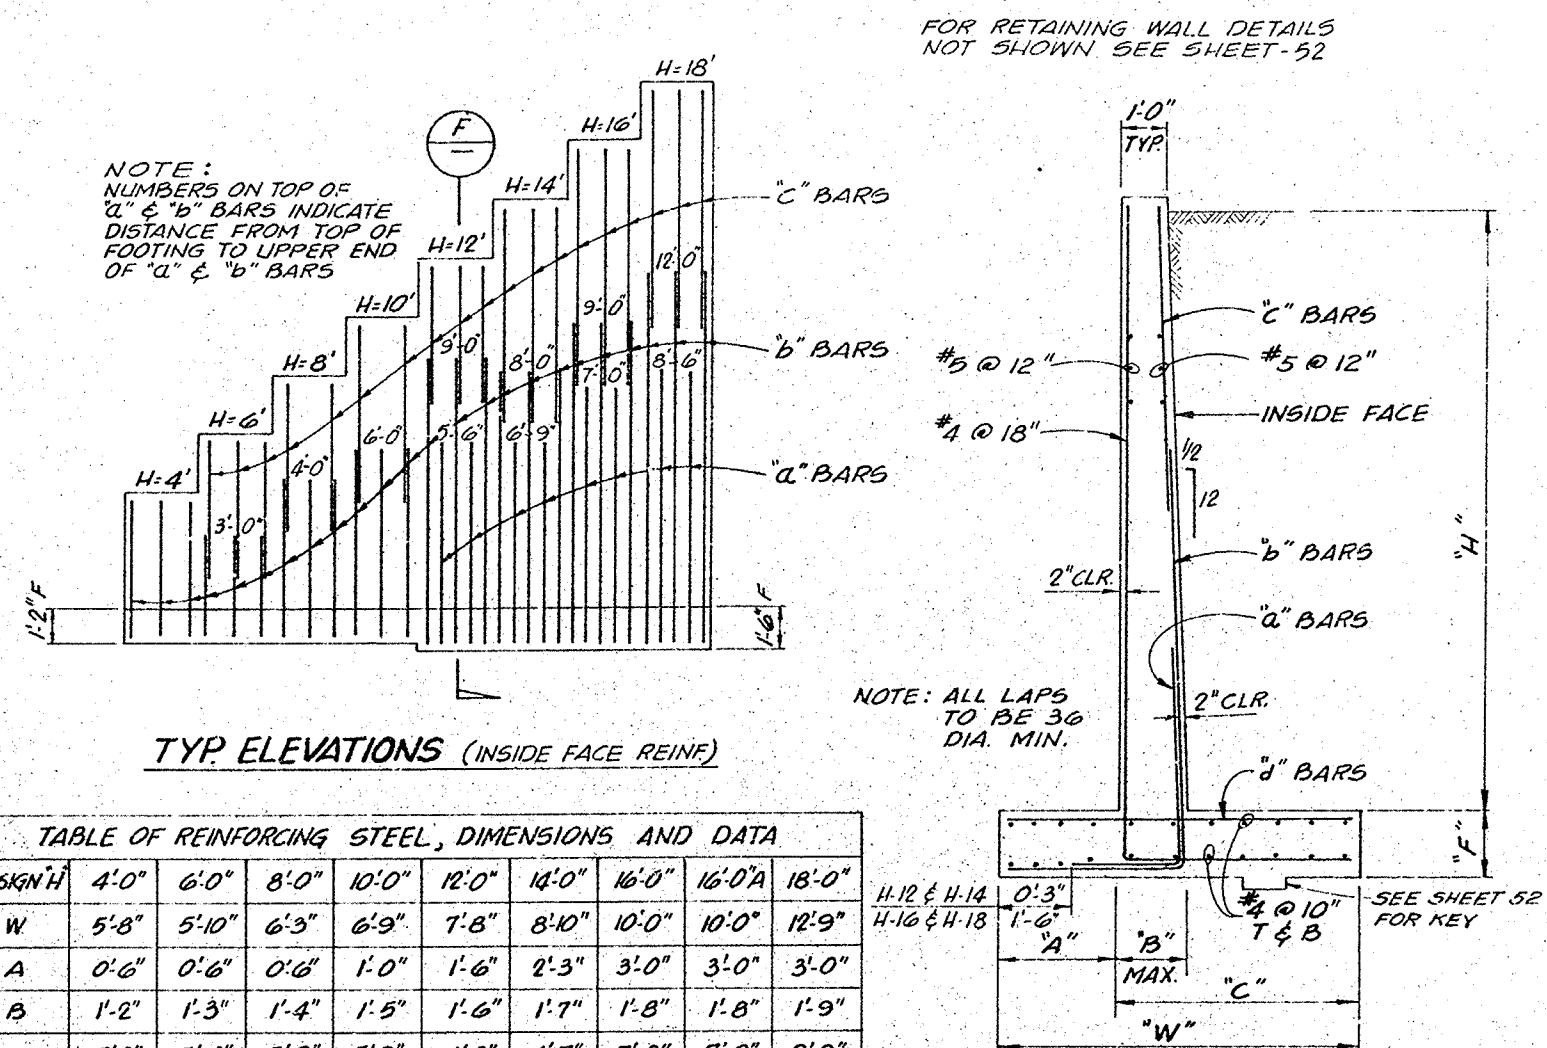

DESIGN#	4'0"	6'0"	8'0"	10'0"	12'0"	14'0"	16'0"	16'0"A	18'0"
W	5'8"	5'10"	6'3"	6'9"	7'8"	8'10"	10'0"	10'0"	12'9"
A	0'6"	0'6"	0'6"	1'0"	1'6"	2'3"	3'0"	3'0"	3'0"
B	1'2"	1'3"	1'4"	1'5"	1'6"	1'7"	1'8"	1'8"	1'9"
C	5'2"	5'4"	5'9"	5'9"	6'2"	6'7"	7'0"	7'0"	9'9"
F	1'2"	1'2"	1'2"	1'2"	1'6"	1'6"	1'6"	1'6"	1'6"
4" BARS	—	—	—	—	#6 @ 12"	#7 @ 12"	#7 @ 12"	#7 @ 12"	#9 @ 12"
5" BARS	#4 @ 12"	#5 @ 12"	#5 @ 10"	#6 @ 10"	#5 @ 12"	#6 @ 12"	#5 @ 12"	#6 @ 12"	#5 @ 12"
6" BARS	—	#4 @ 12"	#5 @ 20"	#5 @ 20"	#5 @ 12"	#5 @ 12"	#5 @ 12"	#7 @ 12"	#5 @ 12"
8" BARS	#5 @ 12"	#5 @ 10"	#6 @ 10"	#7 @ 12"	#7 @ 12"	#6 @ 6"	#6 @ 6"	#7 @ 6"	#8 @ 6"

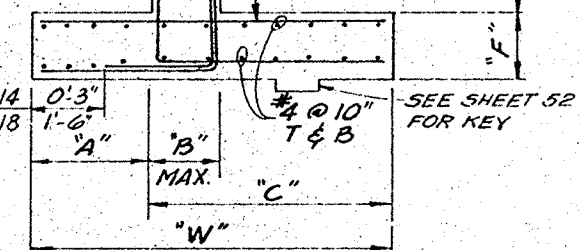


TYP. SECTION (F)
NO SCALE


AS BUILT
WHILE THE INFORMATION SHOWN IS BELIEVED TO
BE ACCURATE, THE ORANGE COUNTY ENVIRONMENTAL
MANAGEMENT AGENCY WILL NOT BE RESPONSIBLE
FOR OMISSIONS, ERRORS, OR INACCURACIES.

Bridge Plans
Dr. #7 13329
Sheet 44 of 53
Red:* 24.1
Type:** Linen

1 1/2 0 1 2
3 inches on original drawing

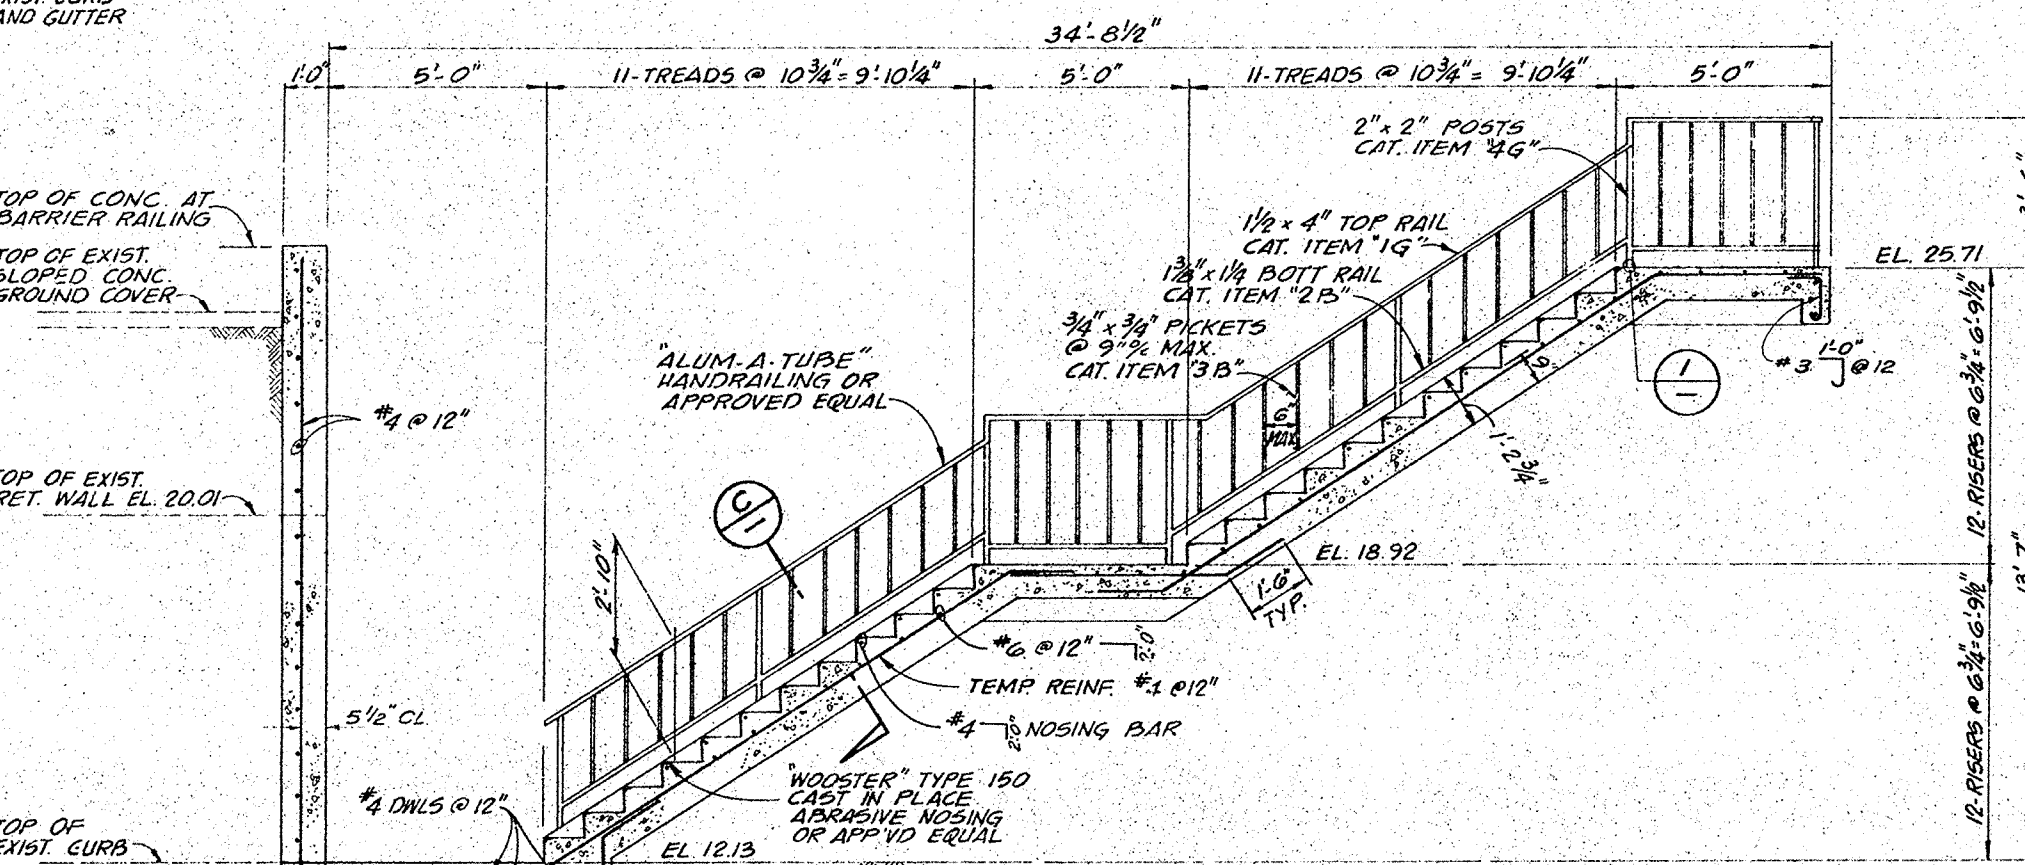


SECTION (A)
SCALE: $\frac{3}{8}'' = 1'-0''$

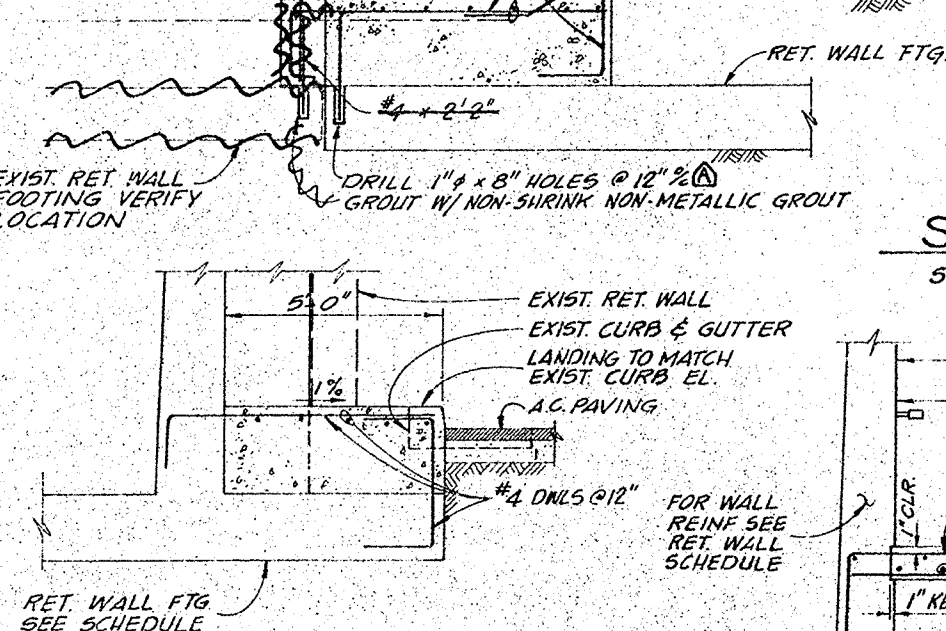


SECTION (B)

SCALE: $\frac{3}{8}'' = 1'-0''$

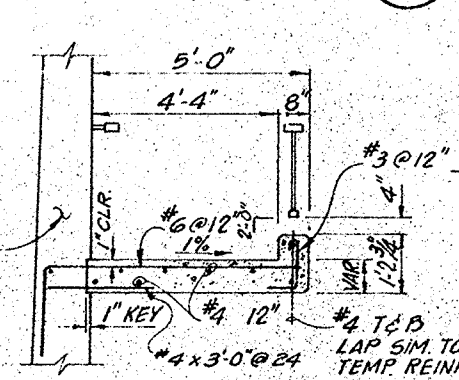


SECTION C


SCALE: $\frac{3}{8}'' = 1'-0''$

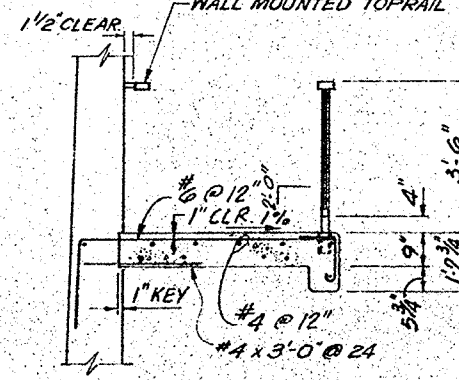

SECTION (D)
SCALE: $\frac{3}{8}'' = 1'-0''$

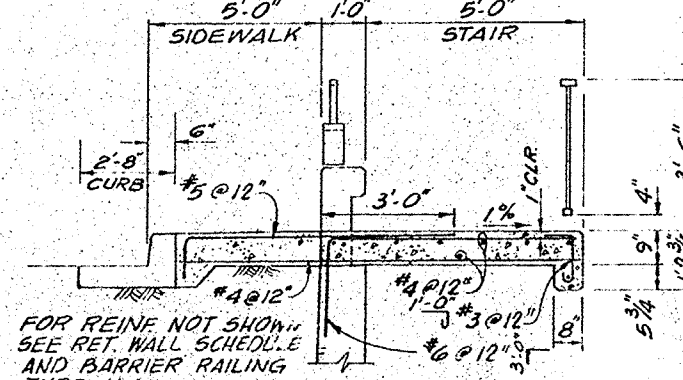

SECTION (E)
SCALE: $\frac{3}{8}'' = 1'-0''$

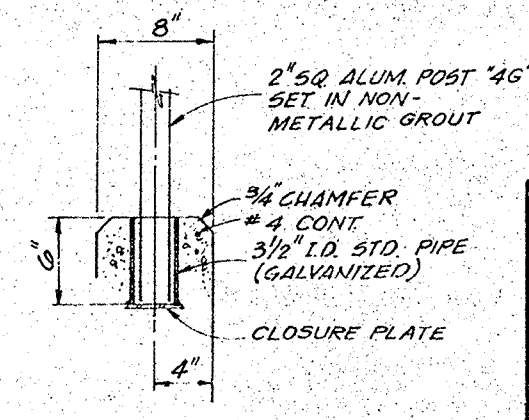

DETAIL (1)
SCALE: 1 1/2" = 1'-0"

		ORANGE COUNTY ENVIRONMENTAL MANAGEMENT AGENCY			
		ADAMS AVENUE BRIDGE OVER SANTA ANA RIVER			
		RETAINING WALL DETAILS-I			
		3-83 AS BUILT.			
MARK DATE DESCRIPTION	PREPARED UNDER SUPERVISION OF			SHEET	
REVISIONS		RCE 6654		DATE	
DESIGNED W.B.	SCALE DATE		DWG. NO.		
DRAWN R.B.B.	AS SHOWN APRIL 1977		S.A. 35		
				44 OF 53	

DR# 7 13329