


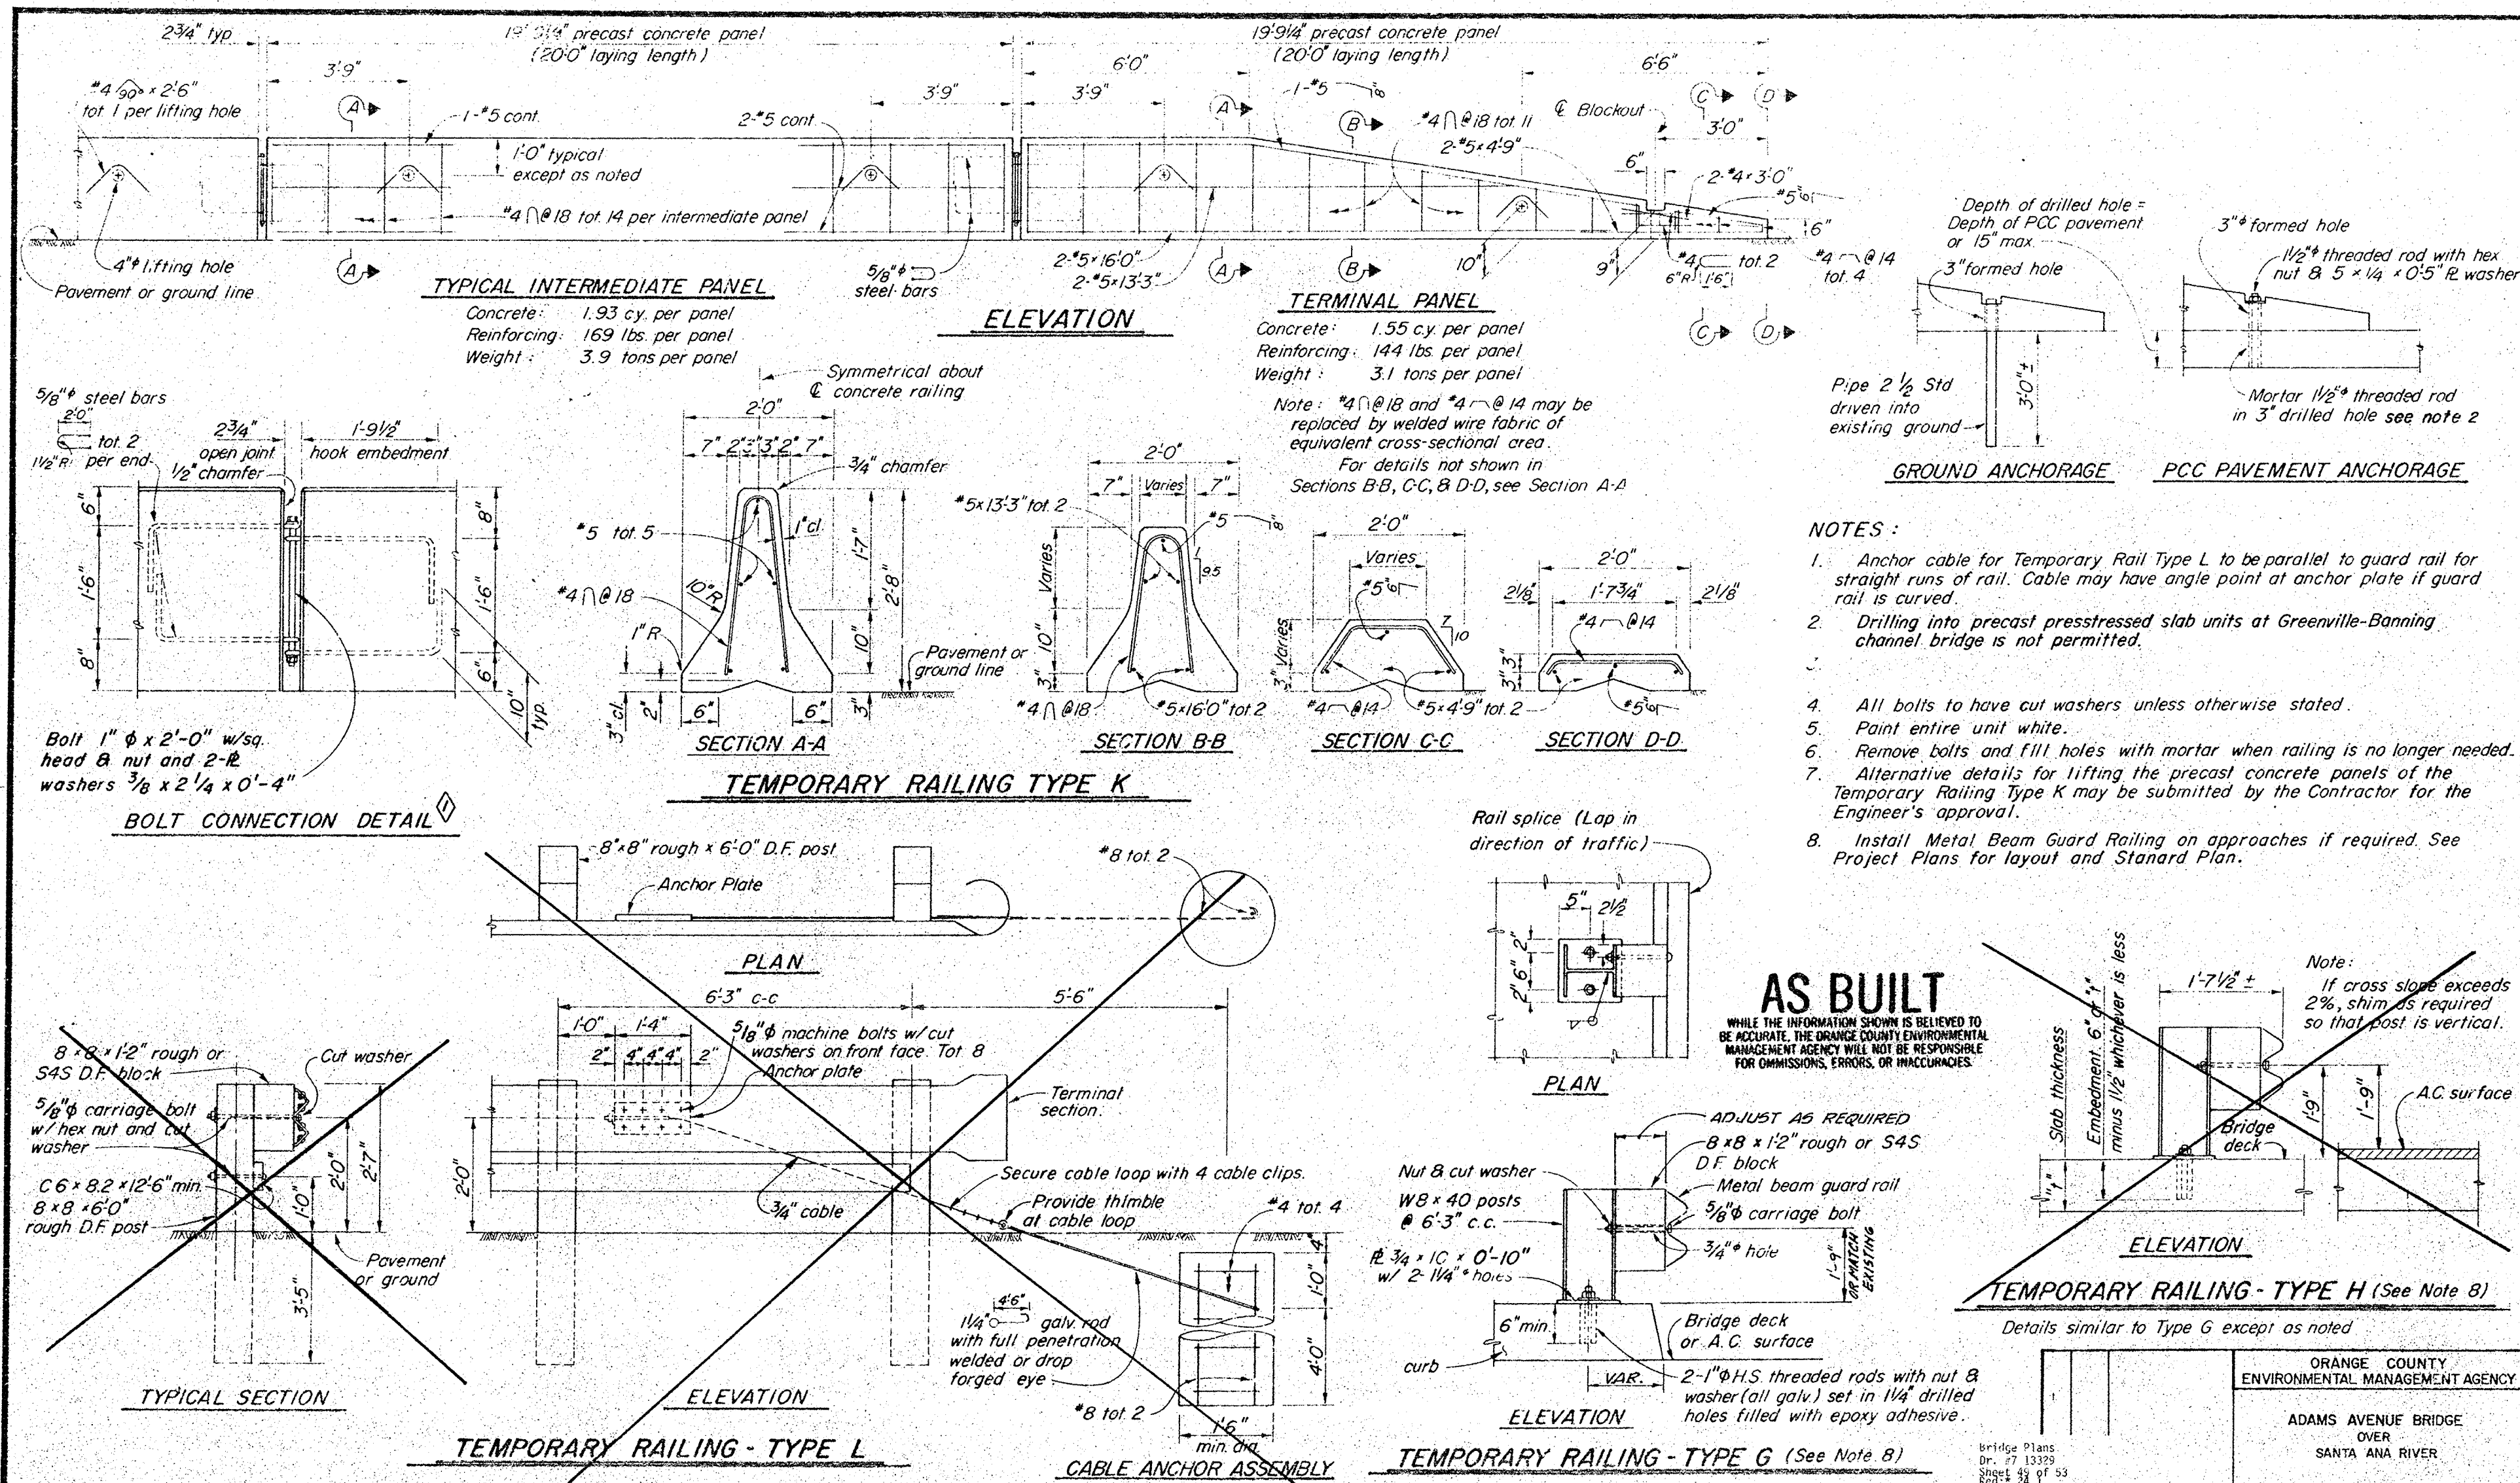

AS BUILT

WHILE THE INFORMATION SHOWN IS BELIEVED TO BE ACCURATE, THE ORANGE COUNTY ENVIRONMENTAL MANAGEMENT AGENCY WILL NOT BE RESPONSIBLE FOR OMISSIONS, ERRORS, OR INACCURACIES.

ORANGE COUNTY ENVIRONMENTAL MANAGEMENT AGENCY	
ADAMS AVENUE BRIDGE OVER SANTA ANA RIVER	
TEMPORARY RAILING DETAILS	
DATE: 1/15/77	SHEET: 49 OF 53
DESIGNED: STD	DWG. NO. RCE 6654
DRAWN: J.S.	DATE: APRIL 1977
CHECKED: J.S.	SCALE: AS SHOWN
APPROVED: J.S.	DATE: APRIL 1977

DRW 7 13329

B11-30