


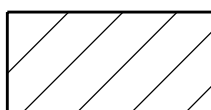
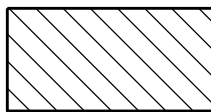
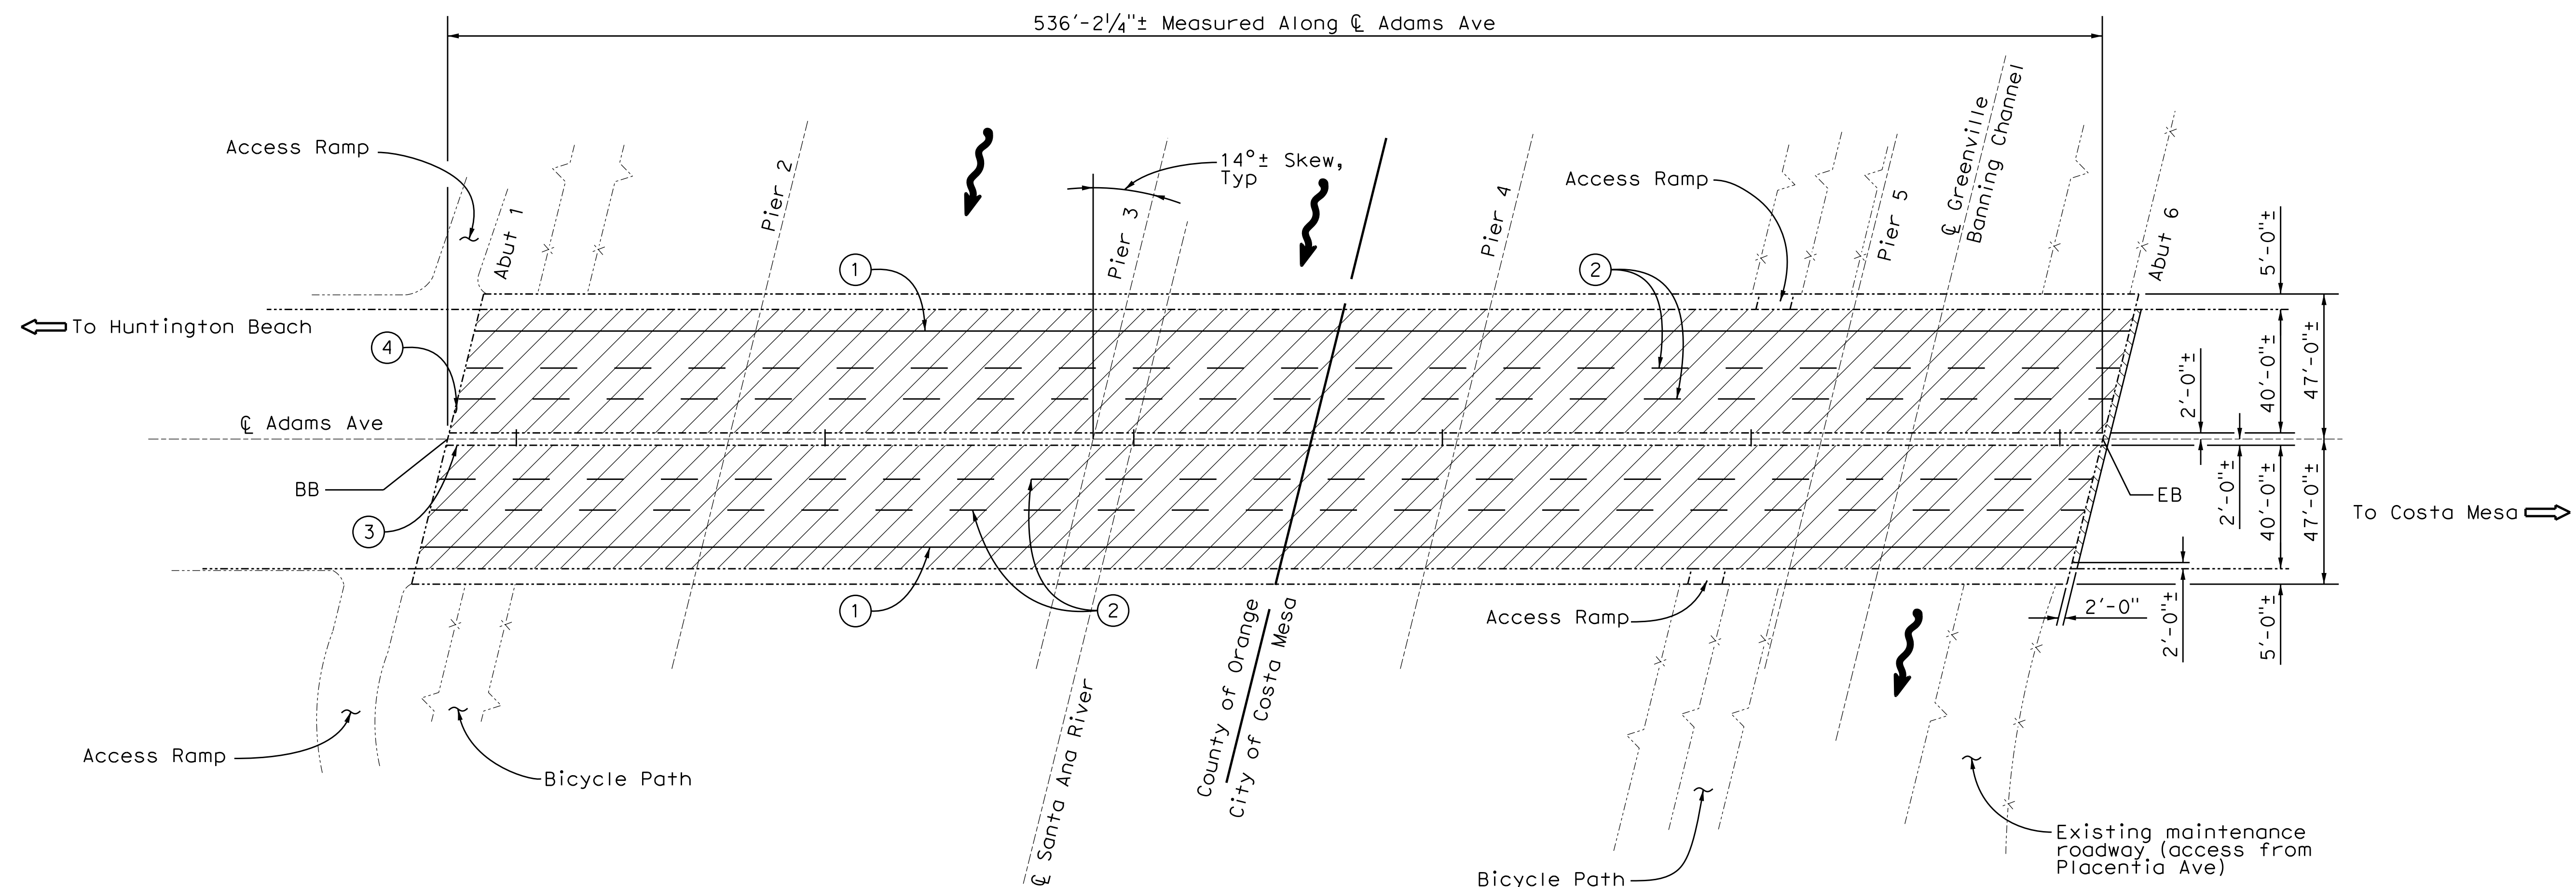


FILE NAME : G:\BridgeMaint\ProjectNo1 ER20260\AAB-Batched\Projects\3_LowerSARArea-Ph1\CAD\Revised\PlansbyCo1-TitleSheet.dgn

LEGEND

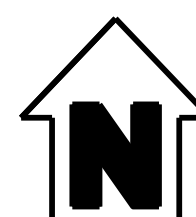
	Indicates existing.
	Indicates direction of traffic.
	Indicates direction of flow.
	Indicates limits of clean and treat bridge deck with high molecular weight methacrylate.
	Indicates limits of AC departure leveling and repair in kind.
①	Remove and replace existing striping and pavement markers per "Caltrans Standard Plan A20D Detail 39".
②	Remove and replace existing striping and pavement markers per "Caltrans Standard Plan A20A Detail 14A".
③	Repair concrete spall on raised median. See "Median Repair Detail" on "Miscellaneous Details" sheet.
④	Patch hole (12"±x18"±x4"±) with rapid setting concrete.




NOTE:
THE CONTRACTOR SHALL VERIFY ALL
CONTROLLING FIELD DIMENSIONS
BEFORE ORDERING OR FABRICATING
ANY MATERIAL.


PLAN

1"=30'

[illegible]

PREPARED UNDER THE RESPONSIBLE CHARGE OF:





11/6/2014

DATE

CO PHUNG

<div> <div>ORANGE COUNTY</div> <div>PUBLIC WORKS</div> </div>	DESIGNED BY: C. PHUNG
	DRAWN BY: CPKN E. FRONDOSO
	DRAWING CODE:
CAPITAL PROJECTS	FILE NAME:
	PLOT DATE: 3/20/14 SCALE: AS NOTED

MAINTENANCE OF VARIOUS
BRIDGES IN ORANGE COUNTY

LOWER SANTA ANA RIVER
AREA BRIDGES - PHASE I

ADAMS AVENUE BRIDGE
OVER SANTA ANA RIVER
BR. NO. 55C-0344

SHEET REFERENCE NUMBER

GENERAL PLAN

SHEET 7 OF 26

NO AS BUILT CHANGES

