
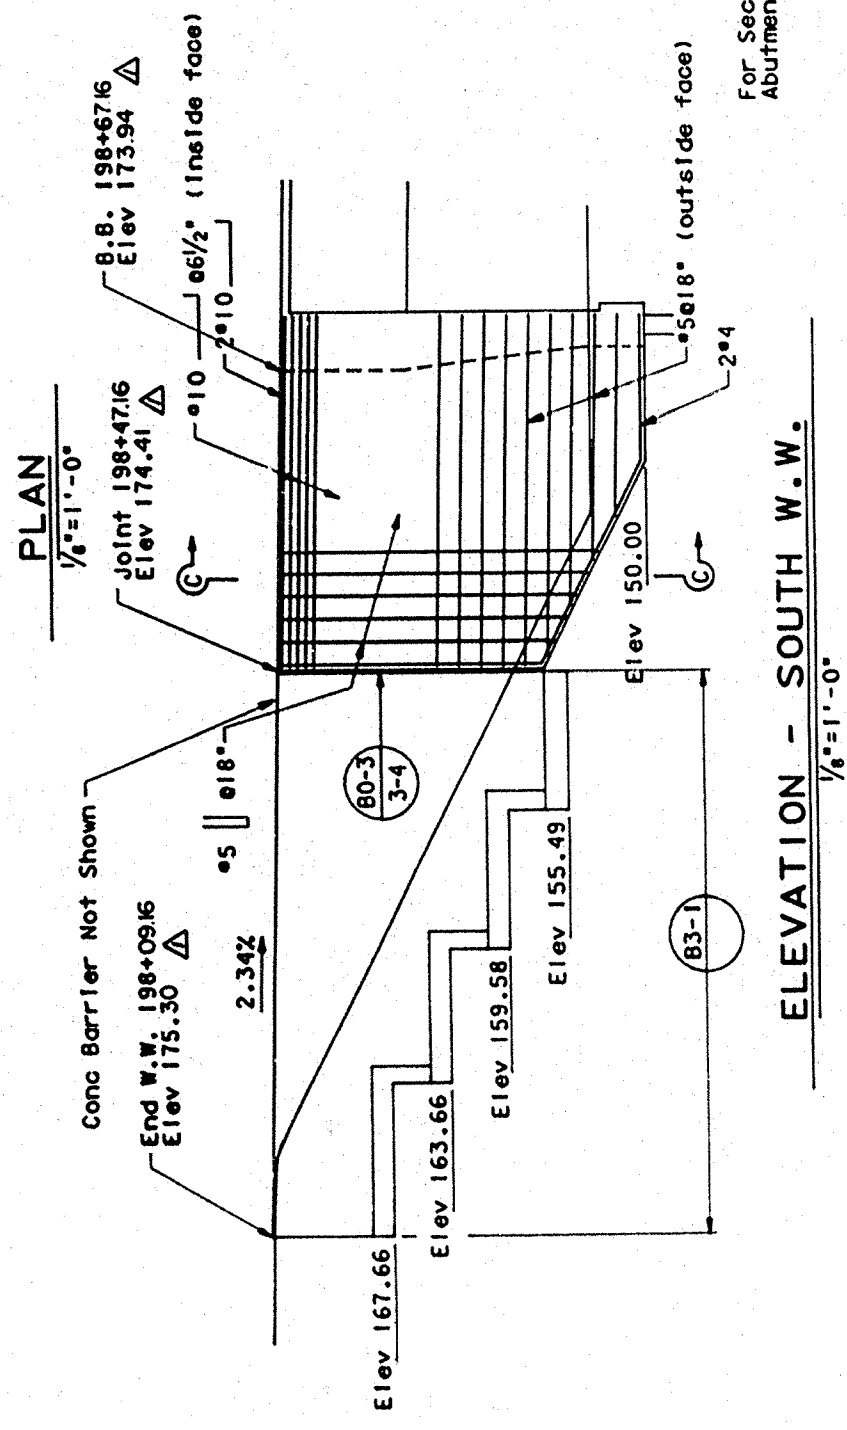
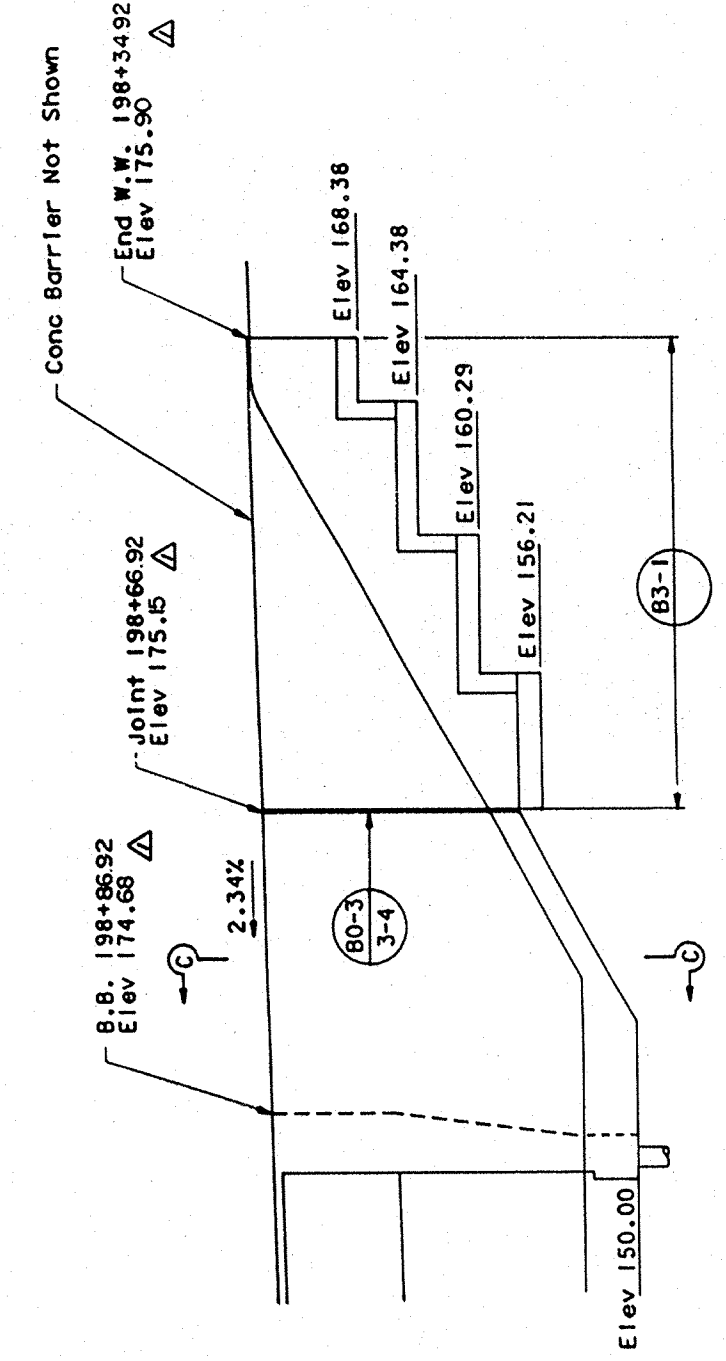


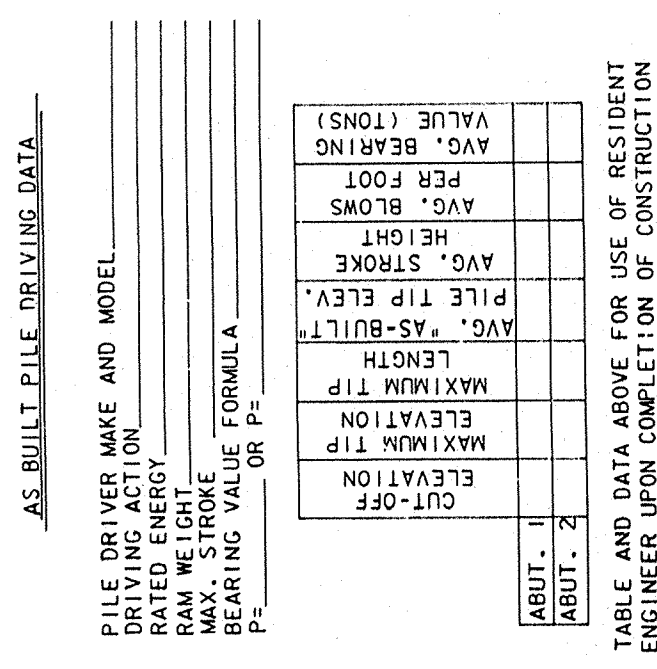

Note 1: Pervious back-fill shall be continuous behind abutments and wing walls.

TYPICAL ABUTMENT SECTION B-B

ELEVATION - NORTH W.W.
 $\frac{1}{8}'' = 1' - 0''$

For Sect C-C See
Abutment 2 Details Sheet

ELEVATION - SOUTH W.W.
1/8"=1'-0"

[illegible]

LIBBY

STRUCTURAL ENGINEERS

4452 GLACIER AVENUE
DENVER, CO 80202

(615) 283-5424




Jack C. Raub Company

Engineering & Planning

2402 Oakdale Drive • Dallas, Texas • (972) 711-6700 • Fax

DR. 4 (15141)