




- ① CONTRACTOR SHALL RE-INSTALL THE FENCE AT THE END OF THE COUNTY TRAIL APPROXIMATELY 150 FEET SOUTH OF THE EXISTING BIKE TRAIL. THE FENCE SHALL BE POSTED WITH THE WARNING SIGNS LISTED BELOW.
- ② CONTRACTOR SHALL CLOSE THE ROAD OVER THE BIKE TRAIL AT THE INTERSECTION OF THE BIKE TRAIL AND ALISO CREEK ROAD. THE BIKE TRAIL SHALL BE OPEN TO THE COUNTY INSPECTOR TO DISTRIBUTE TO THE APPROPRIATE ROAD CONTROL PERSONNEL. A SIGN SHALL BE POSTED WITH THE WARNING LISTED BELOW.
- ③ CONTRACTOR SHALL INSTALL A SIGN ADJACENT TO THE EXISTING ALISO CREEK BIKE TRAIL AT STATION 29+10 PER ALISO CREEK BIKE TRAIL FROM MOUNTAIN PARKWAY TO THE BIKE TRAIL APPROXIMATELY 50 FEET NORTHEAST OF EXISTING BIKE TRAIL BRIDGE WITH THE WARNING LISTED BELOW.
- BIKE TRAIL SIGN WARNING:**
- WARNING**
- DUE TO THE CONSTRUCTION OF A BRIDGE ACROSS ALISO CREEK AT THE INTERSECTION OF BIKE TRAIL AND ALISO CREEK ROAD, THE BIKE TRAIL WILL BE CLOSED TO ALL TRAFFIC. ALL USERS NOT TRAVELING TO ALISO CREEK PARKWAY-ALL USERS MUST RETURN ALONG THE SAME ROUTE THEY ENTERED TO ENTER THIS BIKE TRAIL. CONSTRUCTION ACTIVITY IS EXPECTED TO BE CONTINUOUS UNTIL JANUARY 1988.



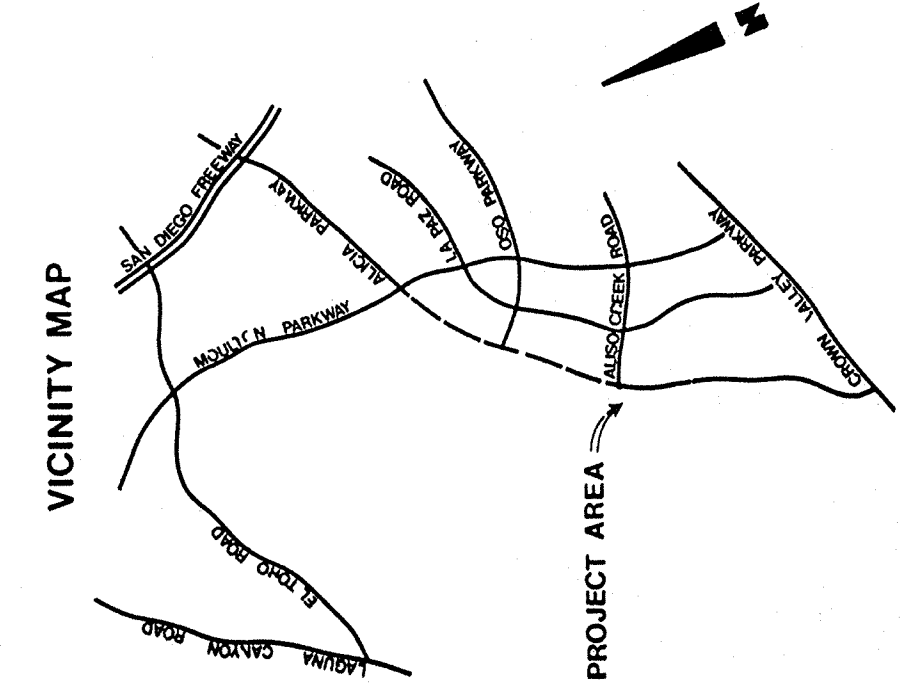

Jack G. Raub Company
Engineering & Planning
1000 N. Main Street, Suite 200
Orange, CA 92667

REVISION DESCRIPTION		DATE	BY
1	ADDED BIKE TRAIL SIGNAGE	10/12/87	JGR

PLAN SCALE
1" = 50'

DATE
10/12/87

BY
JGR

DETOUR PLAN
FOR
ALISO CREEK
ROAD BRIDGE

SHEET
8
OF 8

DR. 4 (15141)
DR. 4 (15141)