



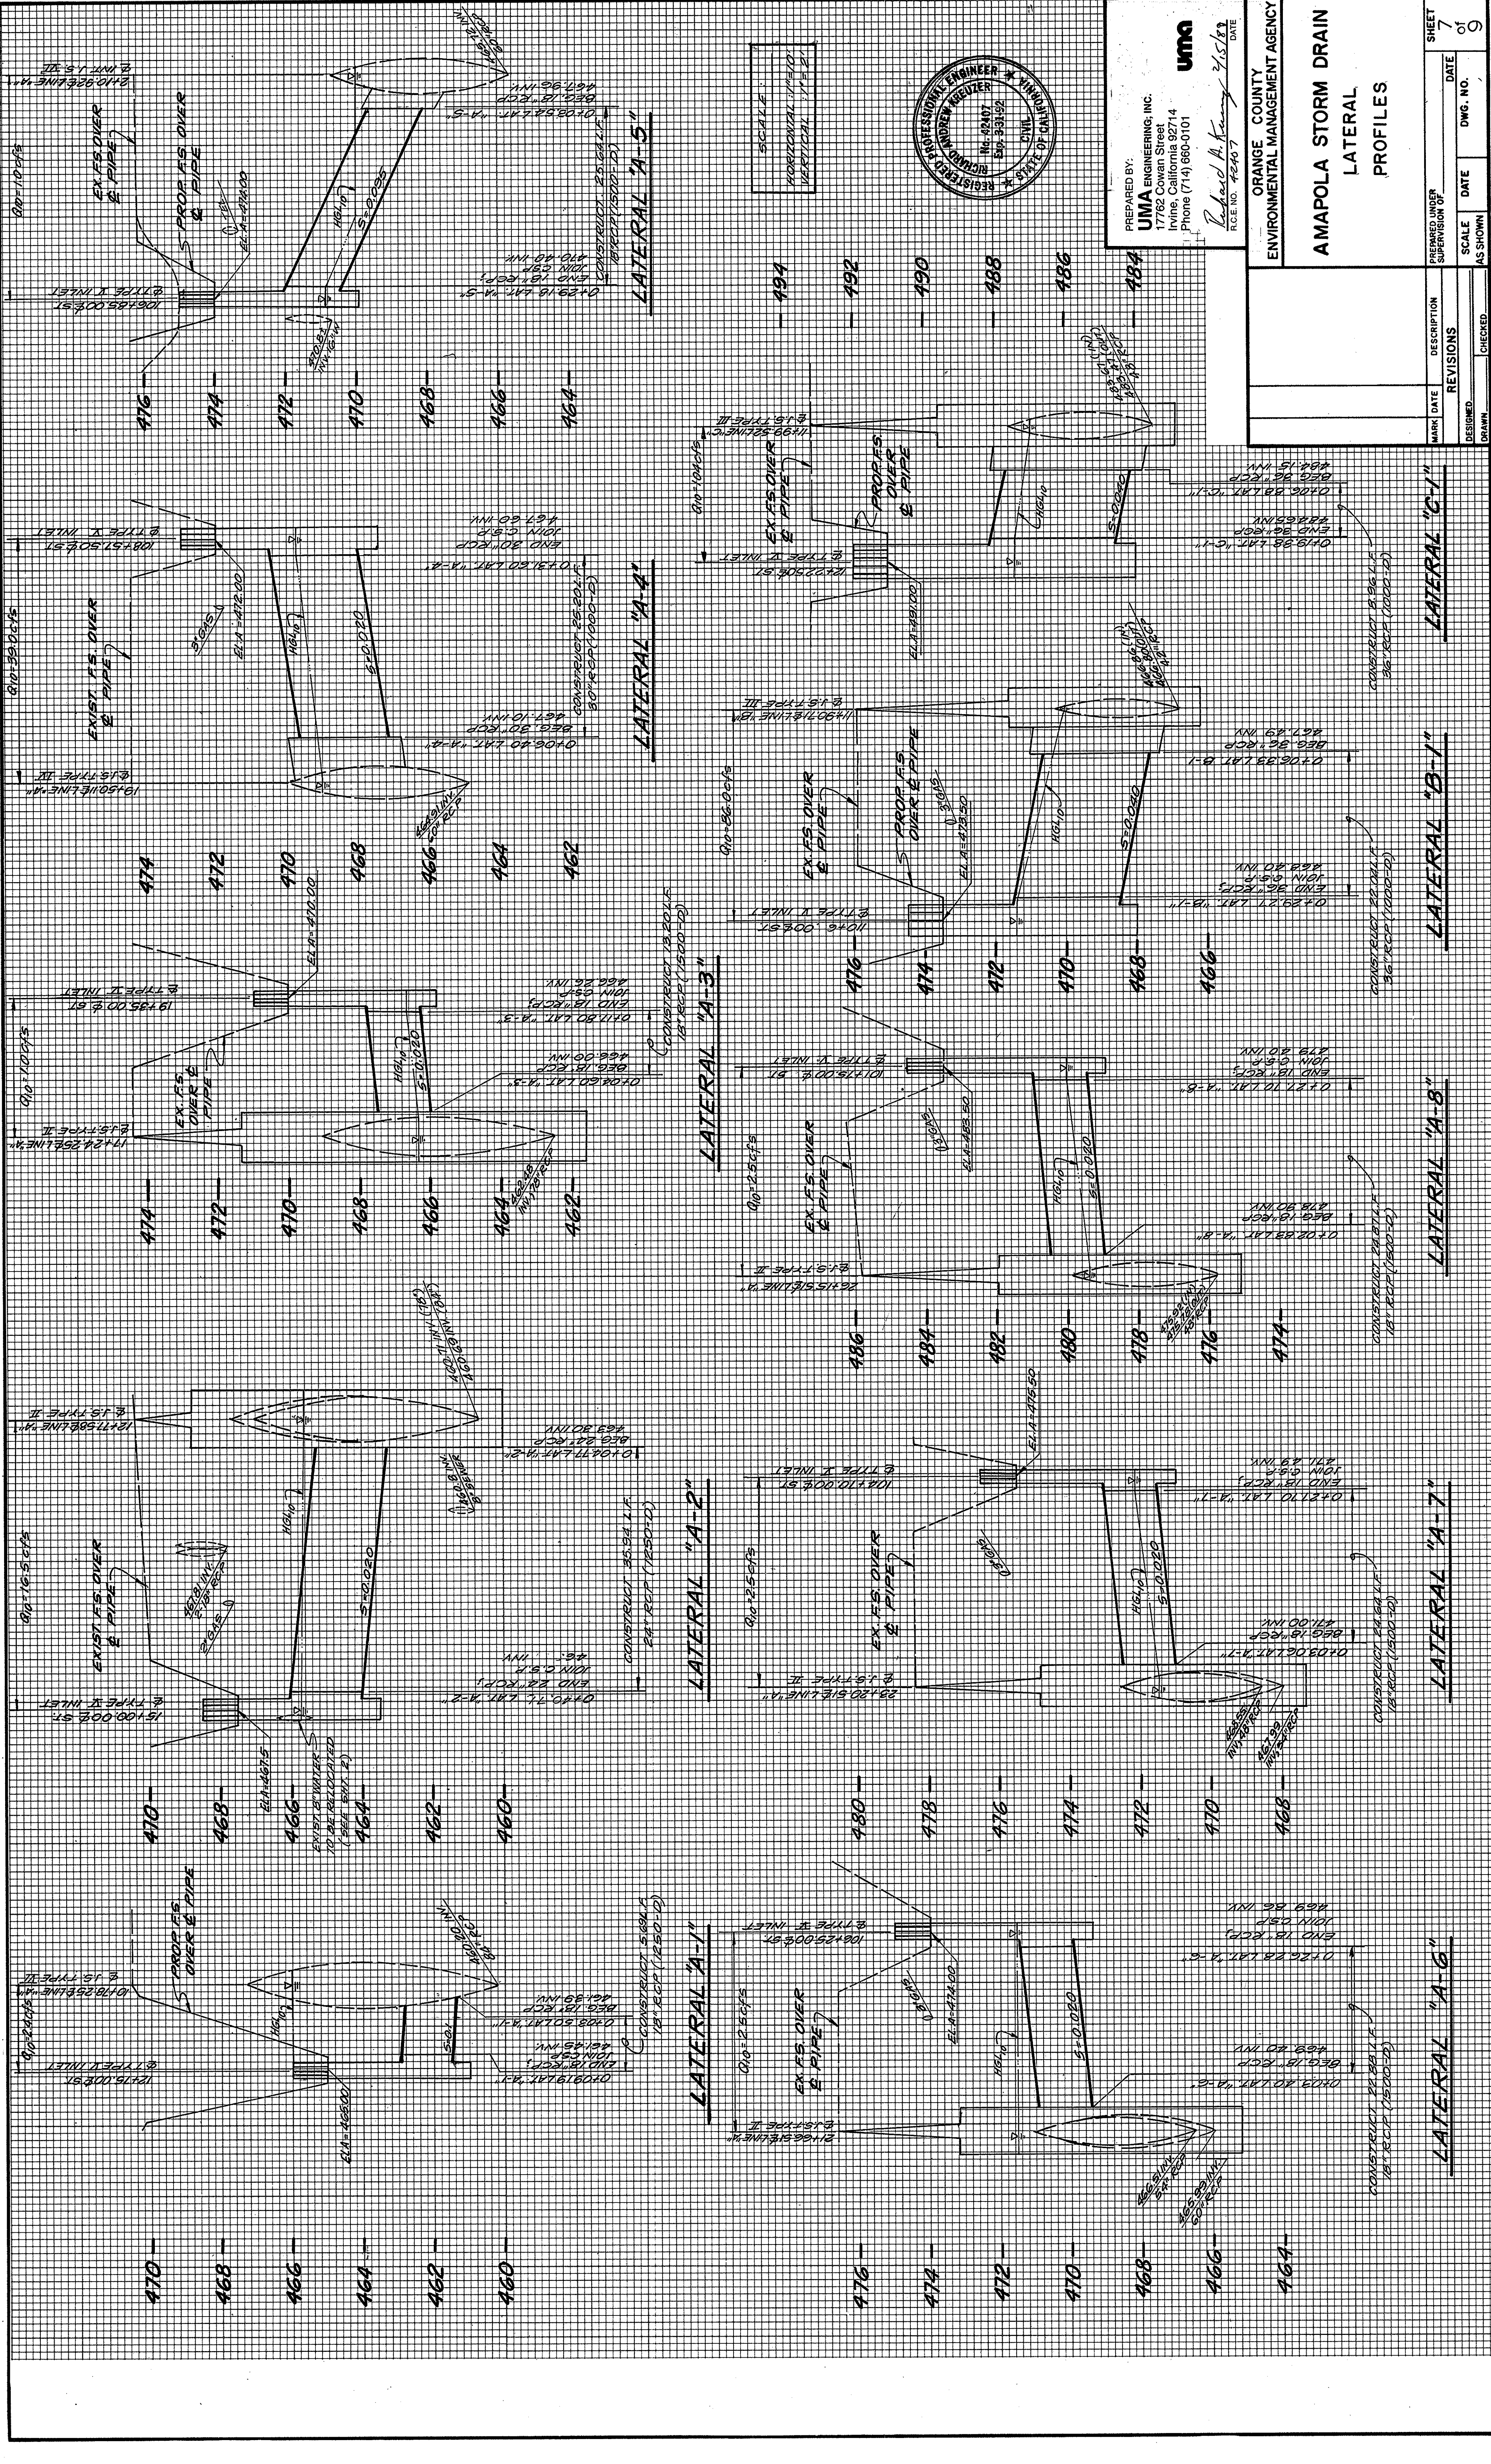

SCALE
HORIZONTAL 1"=10'
VERTICAL 1"=2'

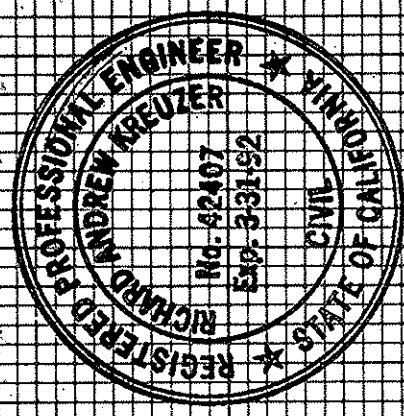

PREPARED BY:
UMA ENGINEERING, INC.
17762 Cowan Street
Irvine, California 92714
Phone (714) 660-0101

Richard A. Kung
DATE 3/5/82
PAGE NO. 42407

ORANGE COUNTY ENVIRONMENTAL MANAGEMENT AGENCY		AMAPOLA STORM DRAIN LATERAL PROFILES		MARK DATE	DESCRIPTION	REVISIONS	SCALE	DATE	DWG. NO.	SHEET
							AS SHOWN			7 of 9
				DESIGNED	CHECKED					
				DRAWN						

LATERAL "A-5"

LATERAL "A-4"

LATERAL "A-3"

LATERAL "A-2"

LATERAL "A-1"

LATERAL "C-1"

LATERAL "B-1"

LATERAL "A-8"

LATERAL "A-7"

LATERAL "A-6"