



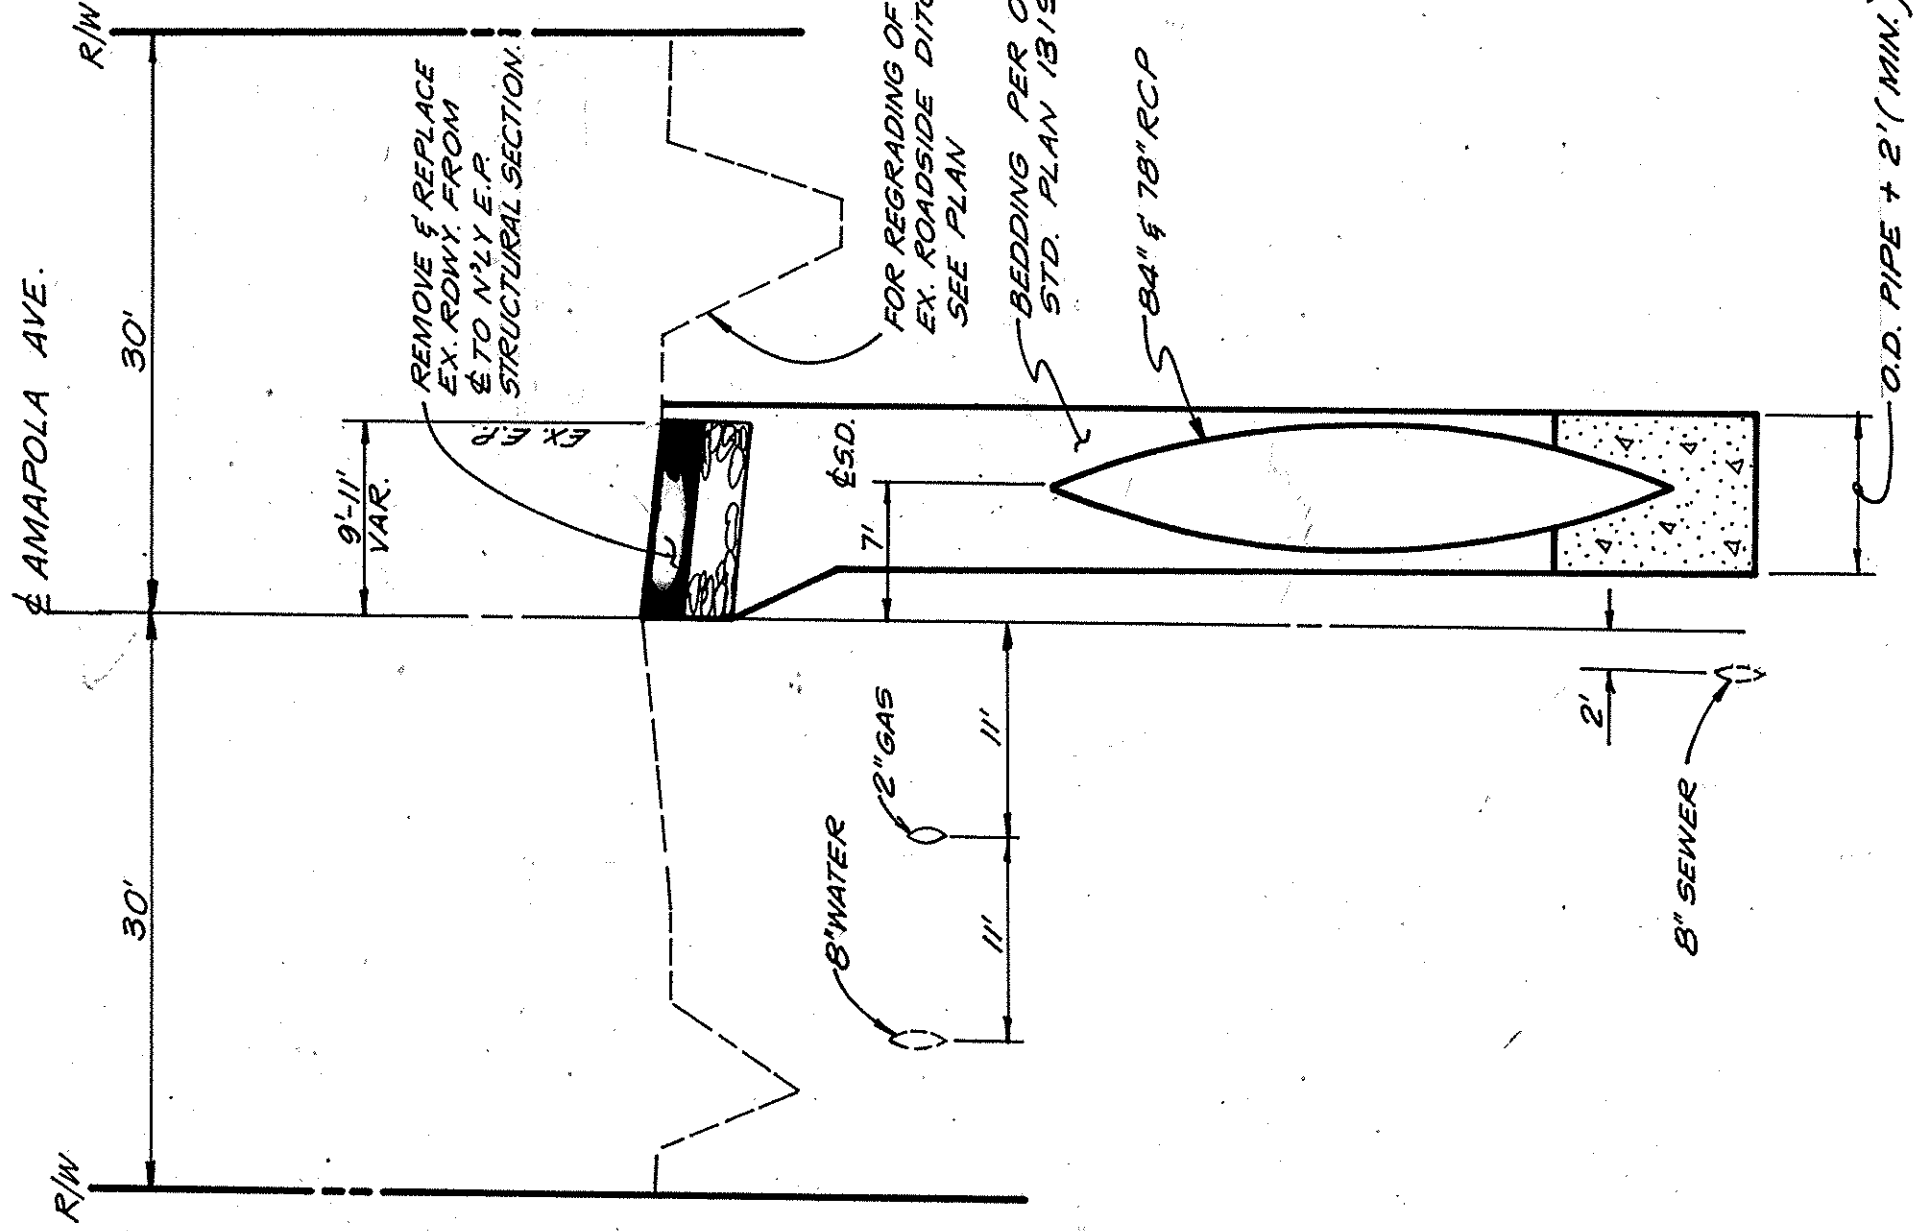

TYPICAL SECTION

AMAPOLA AVENUE


SCALE: HORIZONTAL: 1"=10'
VERTICAL: 1"=2'

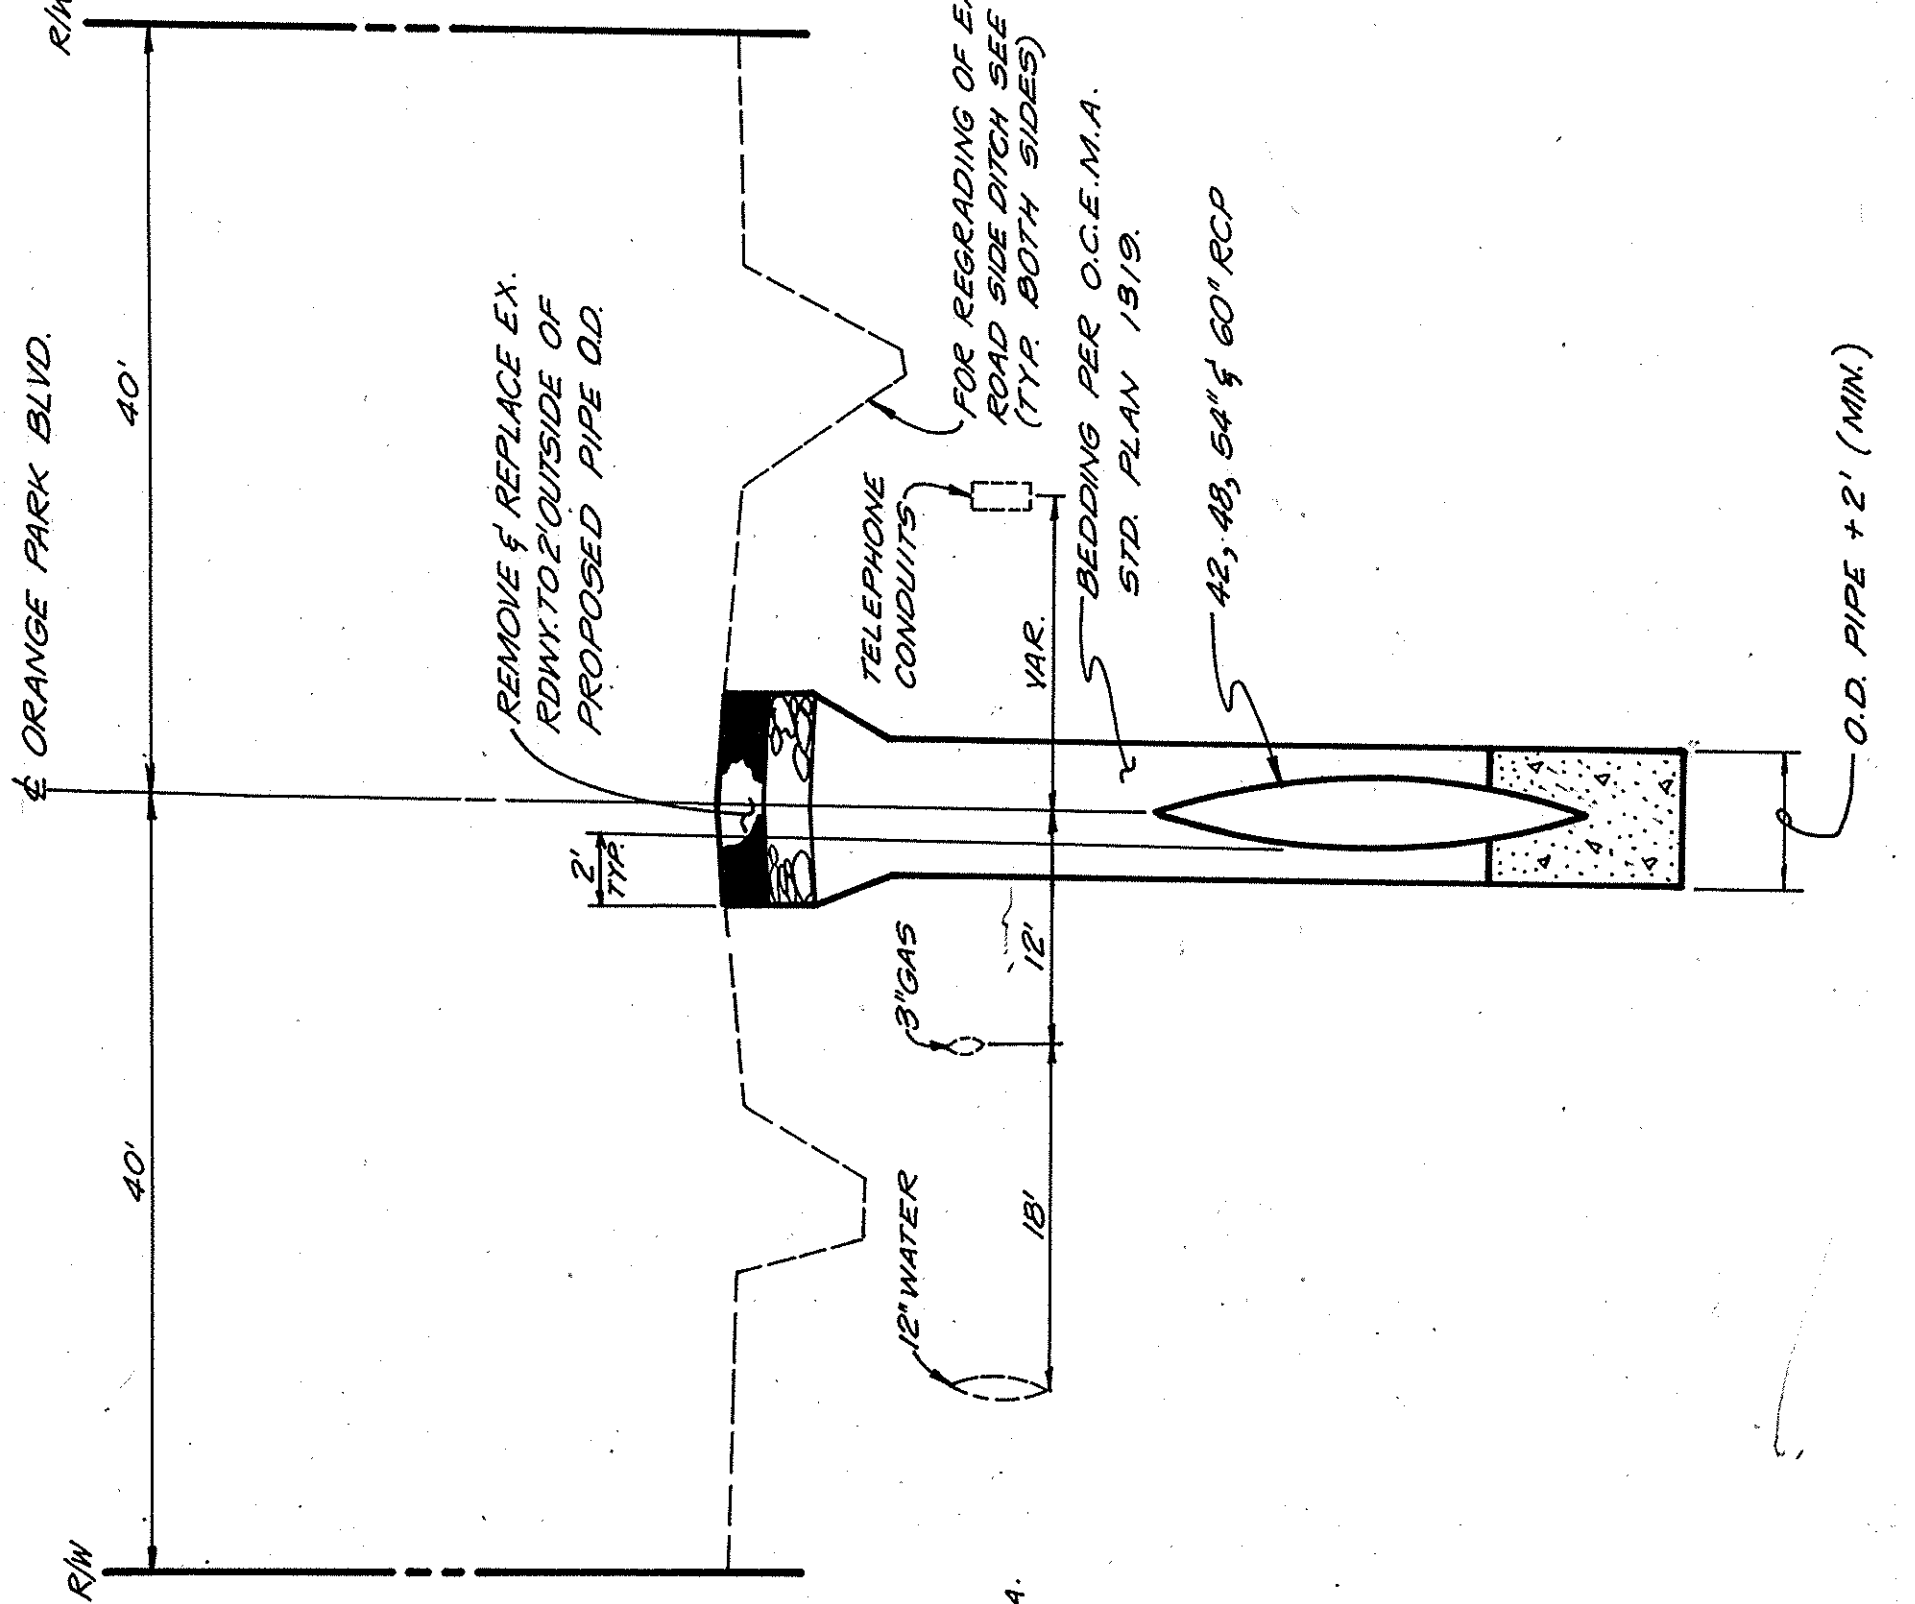

TYPICAL SECTION

ORANGE PARK BOULEVARD

SCALE: HORIZONTAL: 1"=10'
VERTICAL: 1"=2'

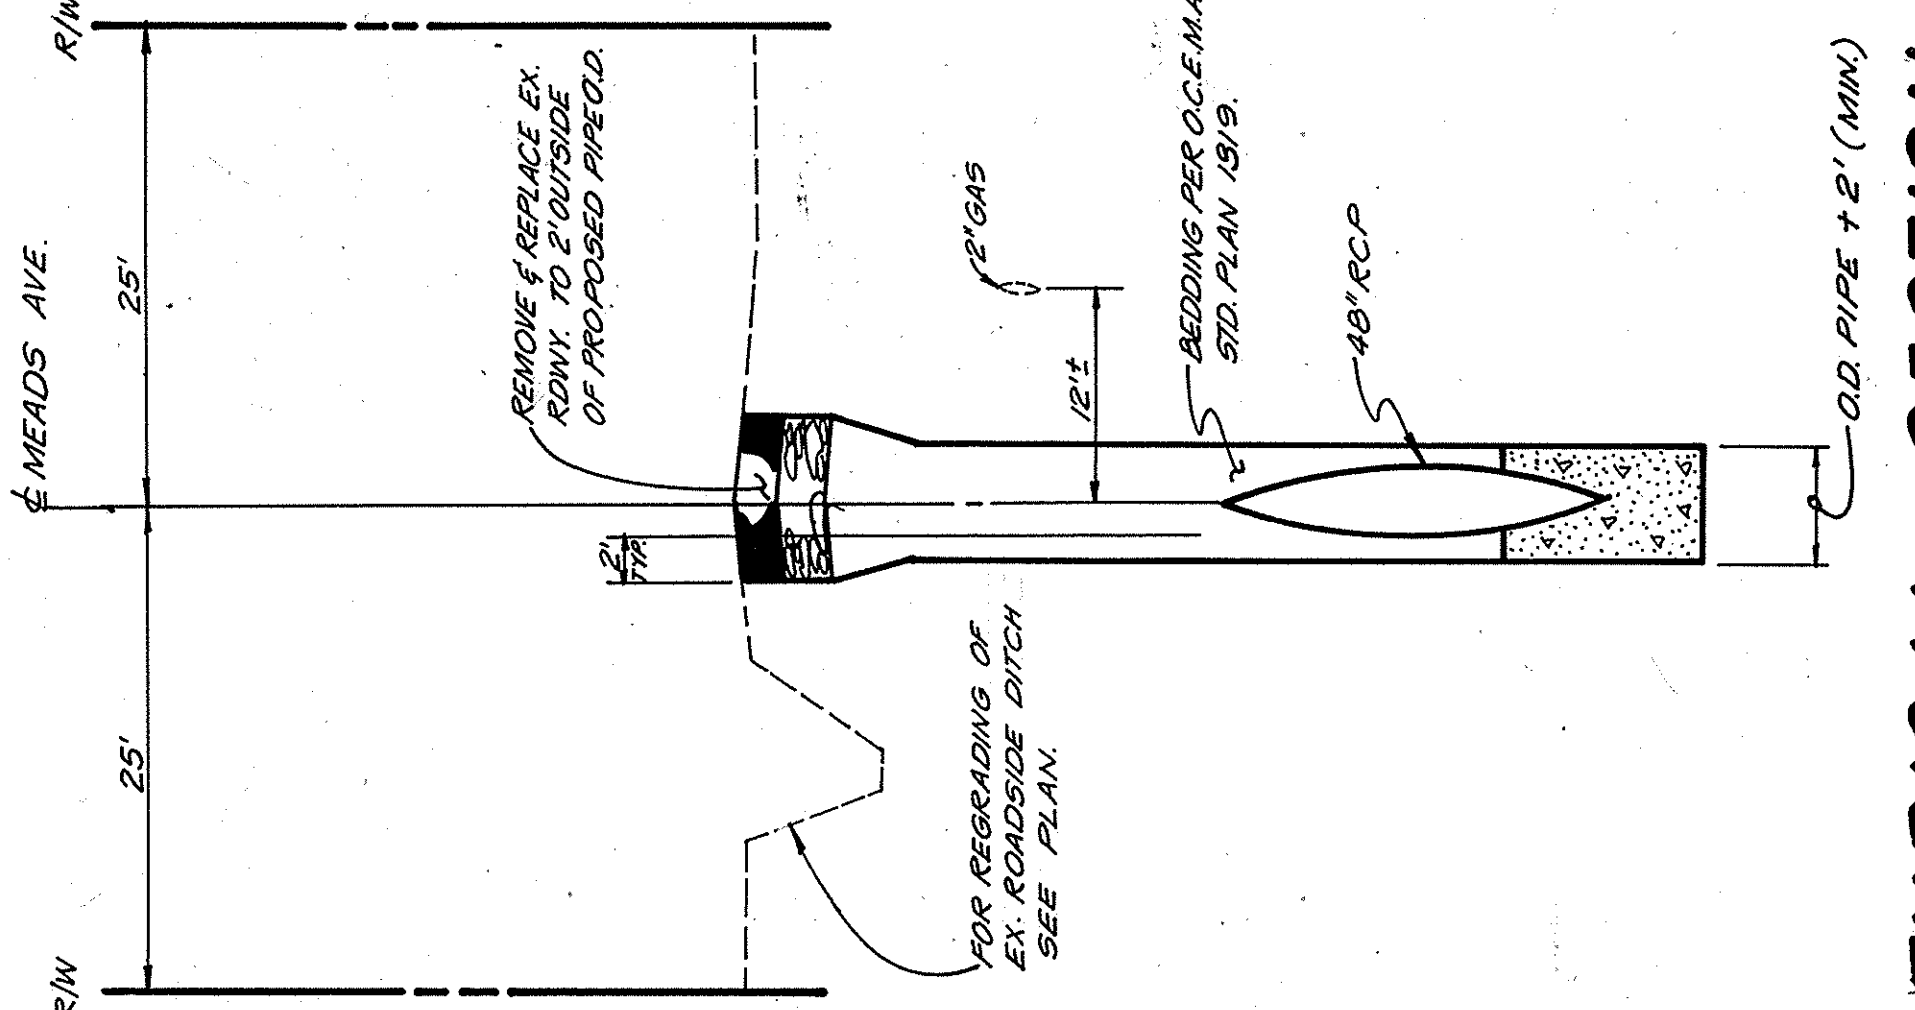

TYPICAL SECTION


MEADS AVENUE

SCALE: HORIZONTAL: 1"=10'
VERTICAL: 1"=2'

CONSTRUCTION QUANTITIES

CONST. NOTE	DESCRIPTION	UNIT	QUANTITIES							
			SHT. 2	SHT. 3	SHT. 4	SHT. 5	SHT. 6	SHT. 7	SHT. 9	TOTAL
1	PROVIDE & PLACE 18" RCP PER O.C.E.M.A. STD. PLAN 13/19	L.F.						116.92		117 L.F.
2	PROVIDE & PLACE 24" RCP PER O.C.E.M.A. STD. PLAN 13/19	L.F.						35.94		36 L.F.
3	PROVIDE & PLACE 30" RCP PER O.C.E.M.A. STD. PLAN 13/19	L.F.						25.20		25 L.F.
4	PROVIDE & PLACE 36" RCP PER O.C.E.M.A. STD. PLAN 13/19	L.F.						35.44		35 L.F.
5	PROVIDE & PLACE 42" RCP PER O.C.E.M.A. STD. PLAN 13/19	L.F.			108.75		115.57			304 L.F.
6	PROVIDE & PLACE 48" RCP PER O.C.E.M.A. STD. PLAN 13/19	L.F.				329.76	263.86			594 L.F.
7	PROVIDE & PLACE 54" RCP PER O.C.E.M.A. STD. PLAN 13/19	L.F.				99.42	108.92			148 L.F.
8	PROVIDE & PLACE 60" RCP PER O.C.E.M.A. STD. PLAN 13/19	L.F.				240.96				241 L.F.
9	PROVIDE & PLACE 78" RCP PER O.C.E.M.A. STD. PLAN 13/19	L.F.	121.92	490.51	19.06					626 L.F.
10	PROVIDE & PLACE 84" RCP PER O.C.E.M.A. STD. PLAN 13/19	L.F.	274.61							275 L.F.
11	CONSTRUCT JUNCTION PER O.C.E.M.A. STD. PLAN 13/1	EA.	1	1	1	2				5 EA.
12	CONSTRUCT JUNCTION STRUCTURE TYPE III PER O.C.E.M.A. STD. PLAN 13/2	EA.		2		2				4 EA.
13	CONSTRUCT JUNCTION PER O.C.E.M.A. STD. PLAN 13/3	EA.			1					1 EA.
14	CONSTRUCT JUNCTION PER O.C.E.M.A. STD. PLAN 13/4	EA.	1		1					2 EA.
15	CONSTRUCT INLET TYPE I PER O.C.E.M.A. STD. PL 13/05	EA.	2	1	4	2	2			11 EA.
17	CONSTRUCT BRICK & MORTAR CURB	EA.			1	1	1			3 EA.
18	CONSTRUCT STORM DRAIN OUTLET STRUCTURE & CHANNEL IMPROVEMENTS PER DETAILS ON SHEET 3.	L.S.								-
-	PROVIDE & PLACE ROCK SLOPE PROTECTION PER O.C.E.M.A. STD. PLAN 13/05	S.F.								60 S.F.
-	SINCE & REMOVE EXIST. A.C. PAVEMENT	S.F.	3500	5000	4900	4015	2,800			20,215 S.F.
-	* A.C. PAVEMENT (TRENCH RESURFACING)	TON	87	124	121	100	70			502 TON
-	* AGGREGATE BASE (TRENCH RESURFACING)	TON	127	181	178	146	102			794 TON
19	SINCE AND REMOVE EXISTING WALL	L.F.	60							60 L.F.
20	CONSTRUCT 0.15' A.C. PAVEMENT OVERLAY	TON			151	156	62			315 TON

* THESE QUANTITIES WERE BASED ON AN ASSUMED STRUCTURAL SECTION OF 4" A.C. OVER 6" A.B.

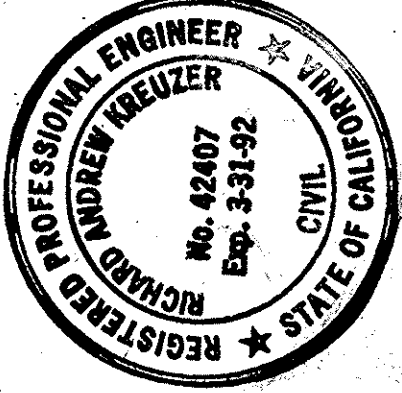

PREPARED BY:
UMA ENGINEERING, INC.
17762 Cowan Street
Irvine, California 92714
Phone (714) 860-0101

Richard A. Kneizer 2/15/92
RICHARD A. KNEIZER No. 42407 DATE

ORANGE COUNTY ENVIRONMENTAL MANAGEMENT AGENCY	
AMAPOLA STORM DRAIN	
TYPICAL SECTIONS	
GENERAL NOTES	
8 QUANTITIES	
MARK	DATE
DESCRIPTION	REVISIONS
DESIGNED	SCALE
DRAWN	CHECKED
PREPARED UNDER SUPERVISION OF	DATE
DATE	DWG. NO.
SHEET 8	of 9