



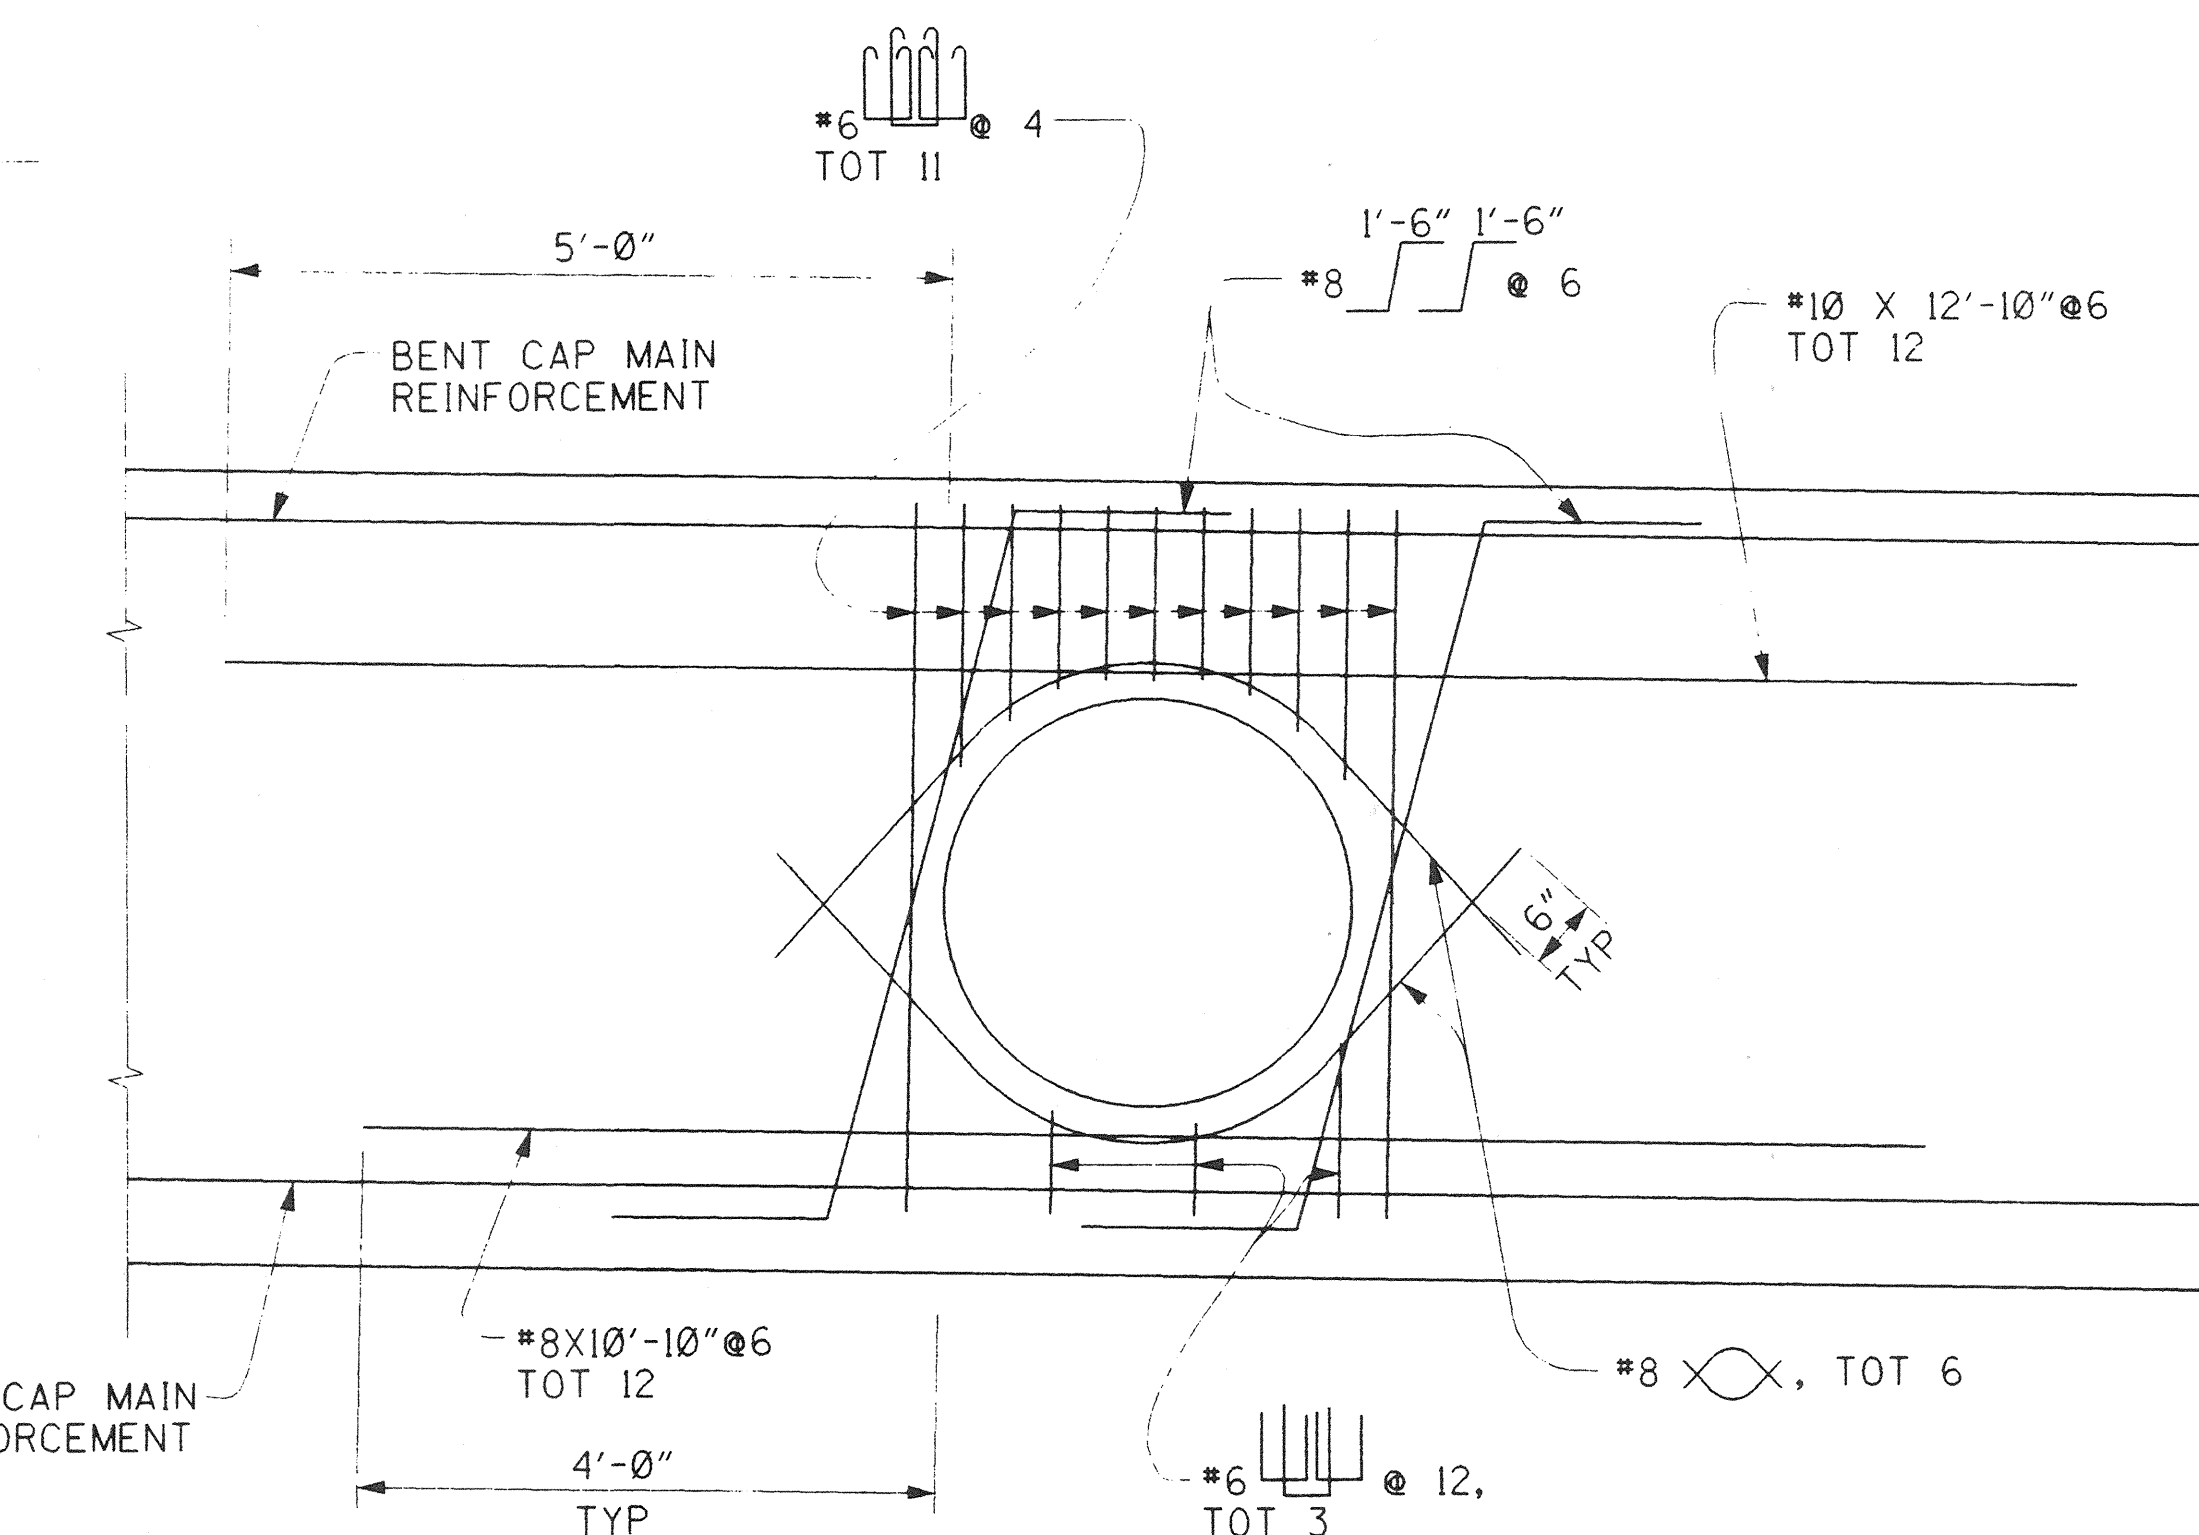

34" Ø UTILITY OPENING DETAIL


$$\frac{1}{2}'' = 1' - 0''$$

FOR UTILITY OPENING SIZES AT
ABUTMENT SEE "ABUTMENT
DETAILS NO.1 & NO.2" SHEETS

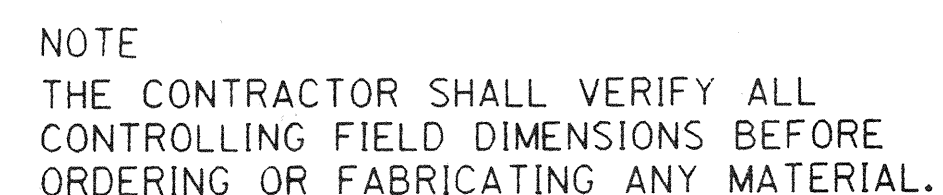

HNTB

36 EXECUTIVE PARK
SUITE 200
IRVINE, CALIFORNIA 92614

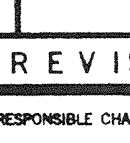	10/99	AS BUILT SHOWN
	7/97	SMWD FACILITY MODIFIED
MARK	DATE	DESCRIPTION
R E V I S I O N S		
PREPARED UNDER RESPONSIBLE CHARGE OF:		
 		
RICHARD A. HART		DATE
PCE 395595 (EXP. 12-31-97)		

ORANGE COUNTY
PUBLIC FACILITIES AND RESOURCES DEPT.
ANTONIO PARKWAY
WILDLIFE
UNDERCROSSING

TYPICAL SECTION

DESIGNED <u>Wendy W. Li</u>		SHEET 45 OF 64
DRAWN <u>S. Garcia</u>	CHECKED <u>S. Whitaker</u>	
SCALE AS SHOWN	DATE	DRAWING NO.

Design Filename: p:\2570\cadd\antowildlife\animtsl.dgn
 Plotted on: 26-AUG-1997 14:31 Generated by: West

Design Filename:
Plotted on:

File Name: SOGN-FILE-NAME\$\$\$\$\$
Data Stored: cdl-comm-xxxx.bluem