

TOP REINFORCEMENT


NOT TO SCALE

BOTTOM REINFORCEMENT

NOT TO SCALE

NOTES:

- 1. ALL REINFORCEMENT SHOWN ARE #9 BARS, UNLESS OTHERWISE NOTED.
 NUMBERS AT THE END OF BARS INDICATE LENGTH FROM © BENT FOR TOP REINF AND FROM & SPAN FOR BOTTOM REINF.
- 2. TOP AND BOTTOM REINFORCEMENT SYMMETRICAL ABOUT & SPAN 2.
- 3. THE CONTRACTOR SHALL VERIFY ALL CONTROLLING FIELD DIMENSIONS BEFORE ORDERING OR FABRICATING ANY MATERIAL.
- 4. BOTTOM REINFORCEMENT SHALL NOT BE LAP SPLICED WITHIN MIDDLE THIRD OF EACH SPAN OR WITHIN 0.25L OF THE CLOF BENT CAP. TOP REINFORCEMENT SHALL NOT BE LAP SPLICED WITHIN 1/3 SPAN LENGTH EITHER SIDE OF BENTS.

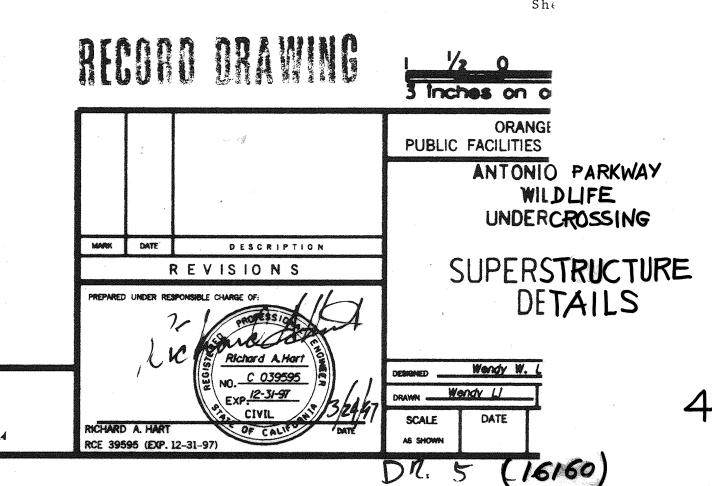

DR

36 EXECUTIVE PARK SUITE 200 IRVINE, CALIFORNIA 92614 HNTB

47