



# ANTONIO PARKWAY WILDLIFE UNDERCROSSING

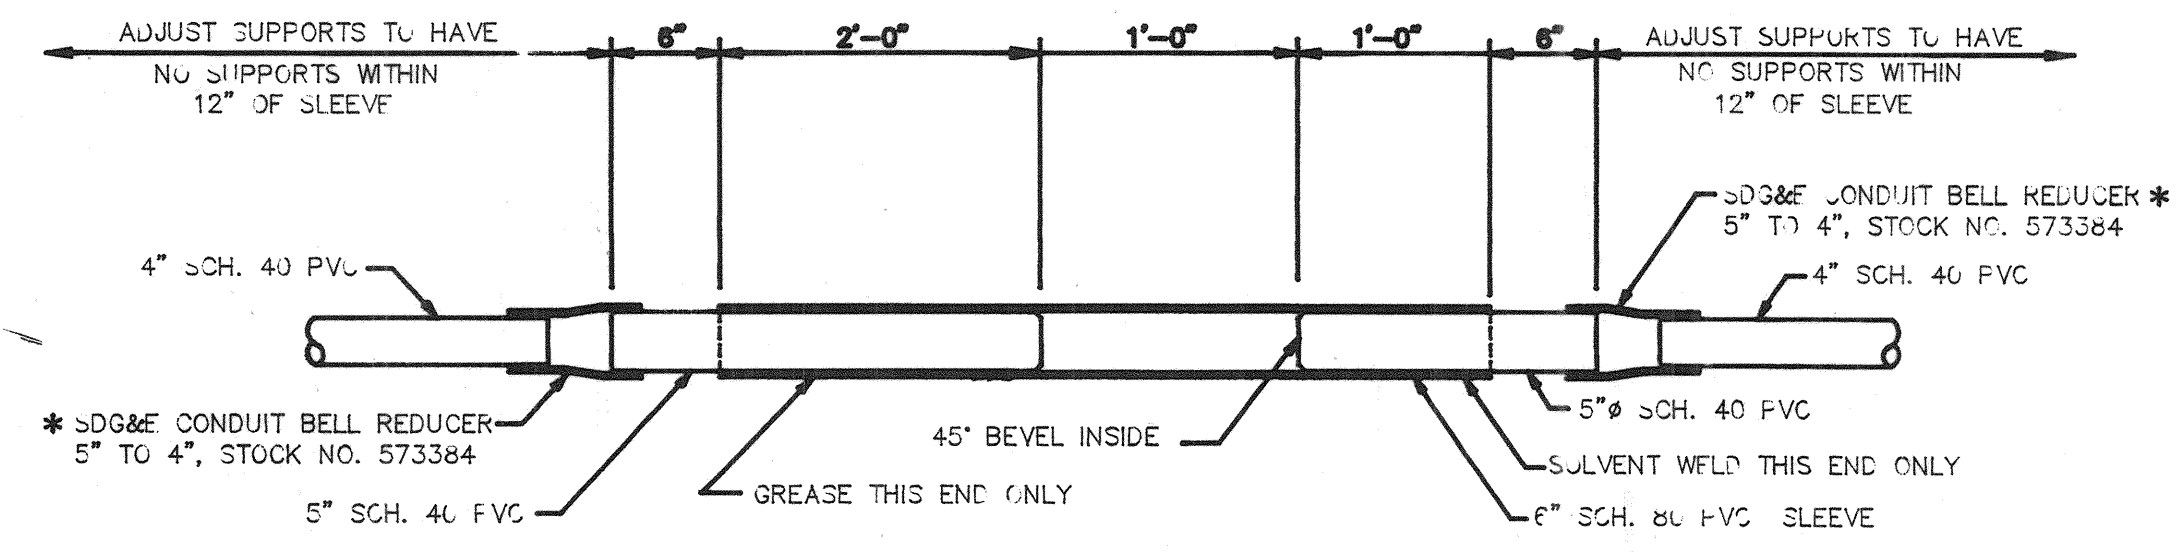


**4"  $\phi$  EXPANSION SLEEVE**

NO SCALE  
\* SOLVENT WELD BOTH 5"  $\phi$  AND 4"  $\phi$  TO BELL REDUCER

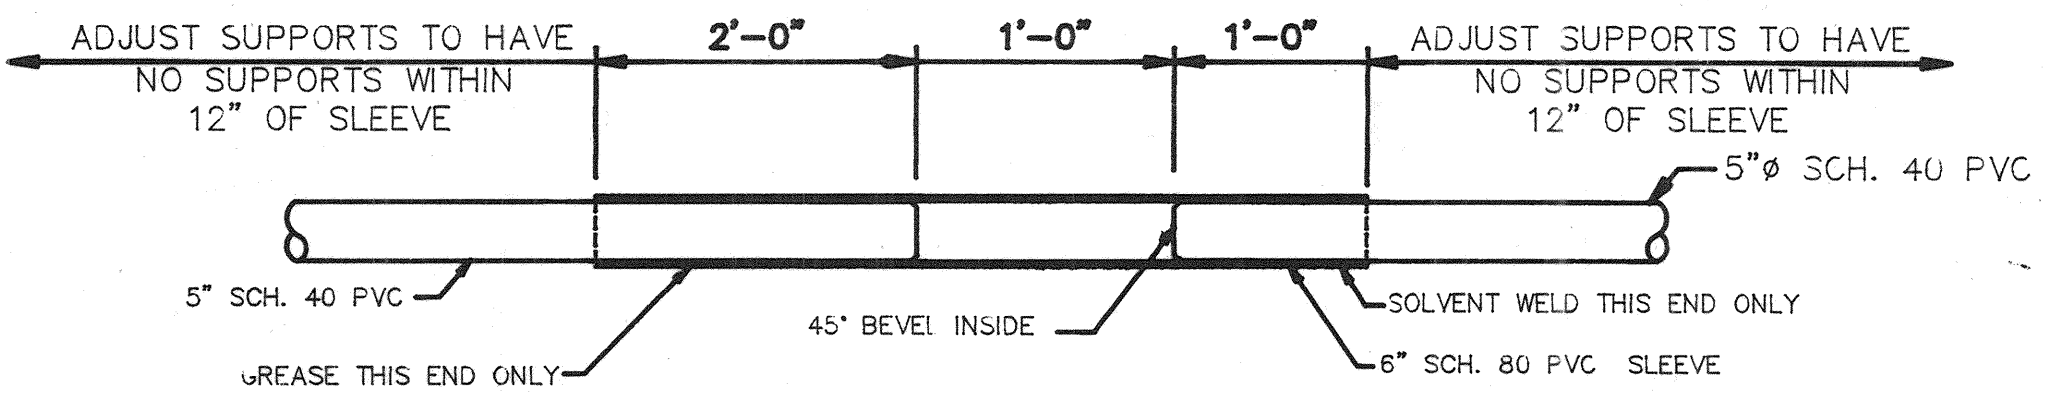

**5"  $\phi$  EXPANSION SLEEVE**


NO SCALE  
**SPECIAL EXTENDED EXPANSION SLEEVE  
DETAILS (4" AND 5")**

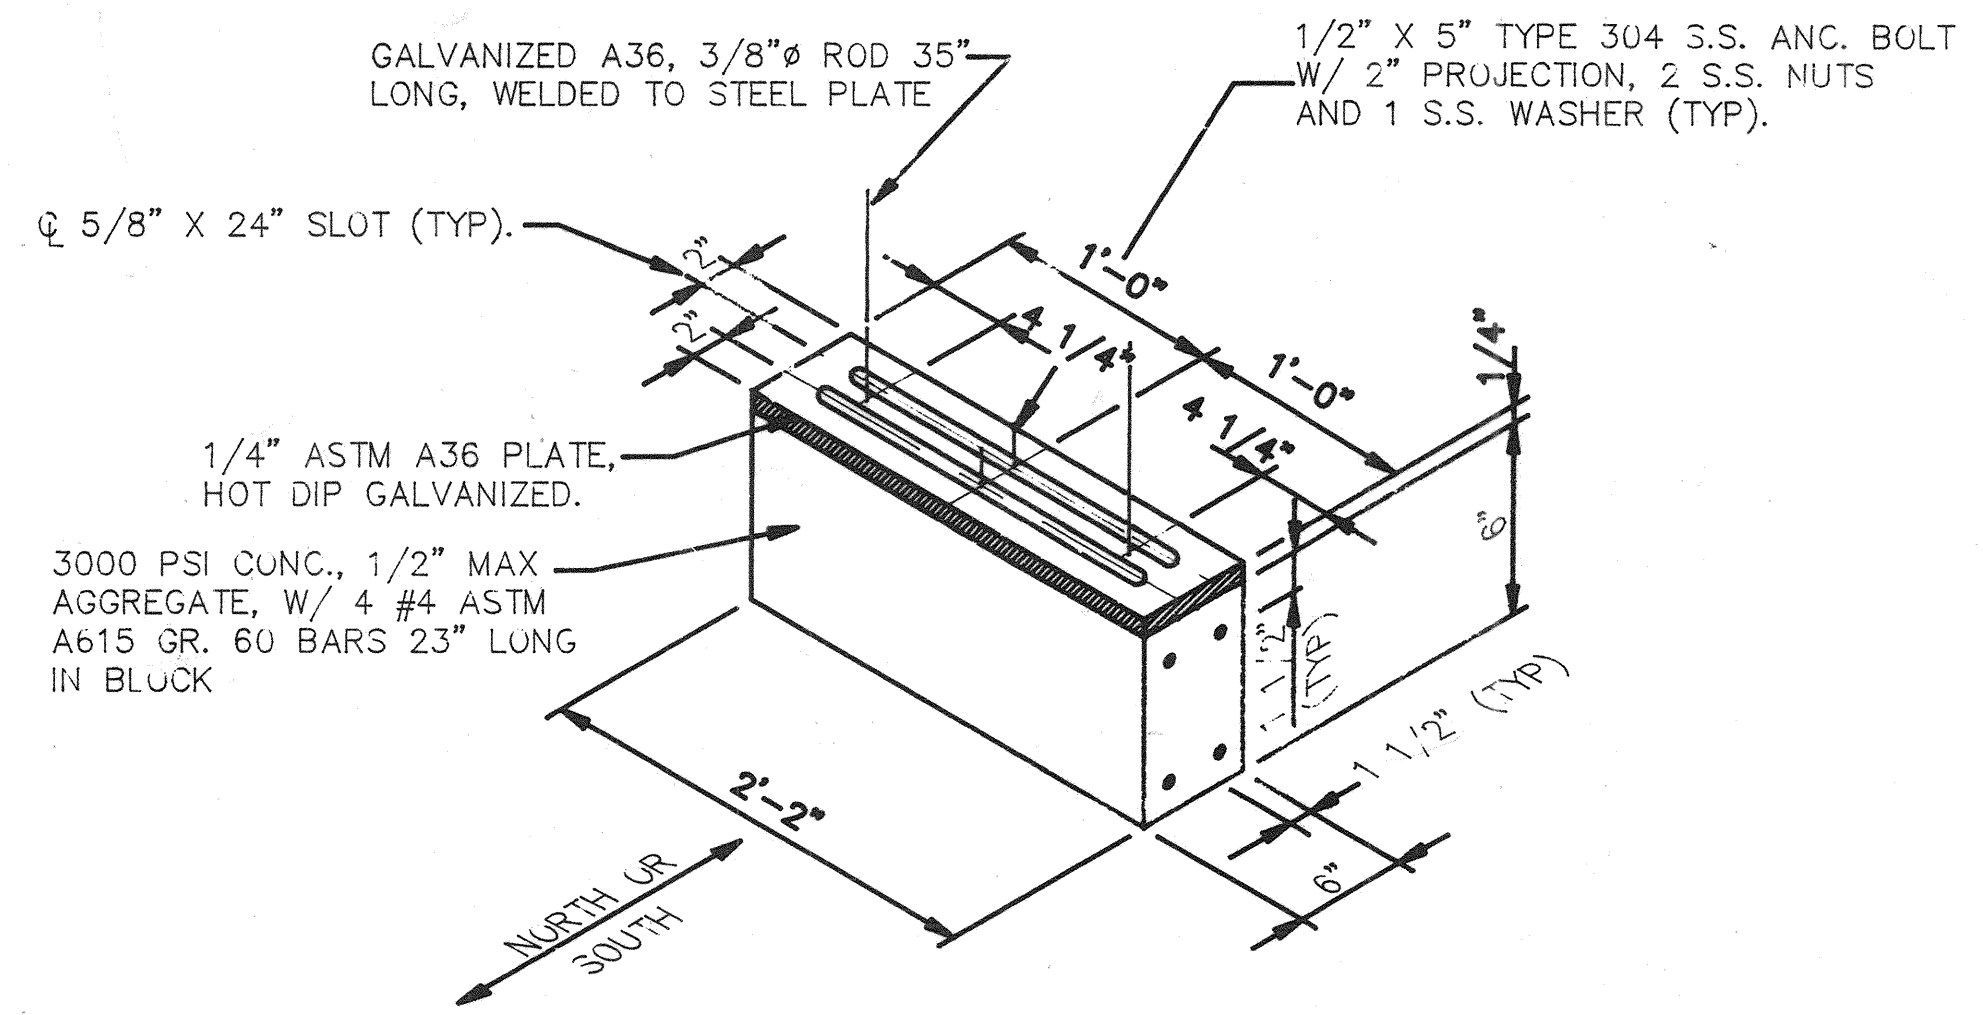

**SLIDING SUPPORT DETAIL**


NOT TO SCALE

**SLIDING SUPPORT DETAIL**

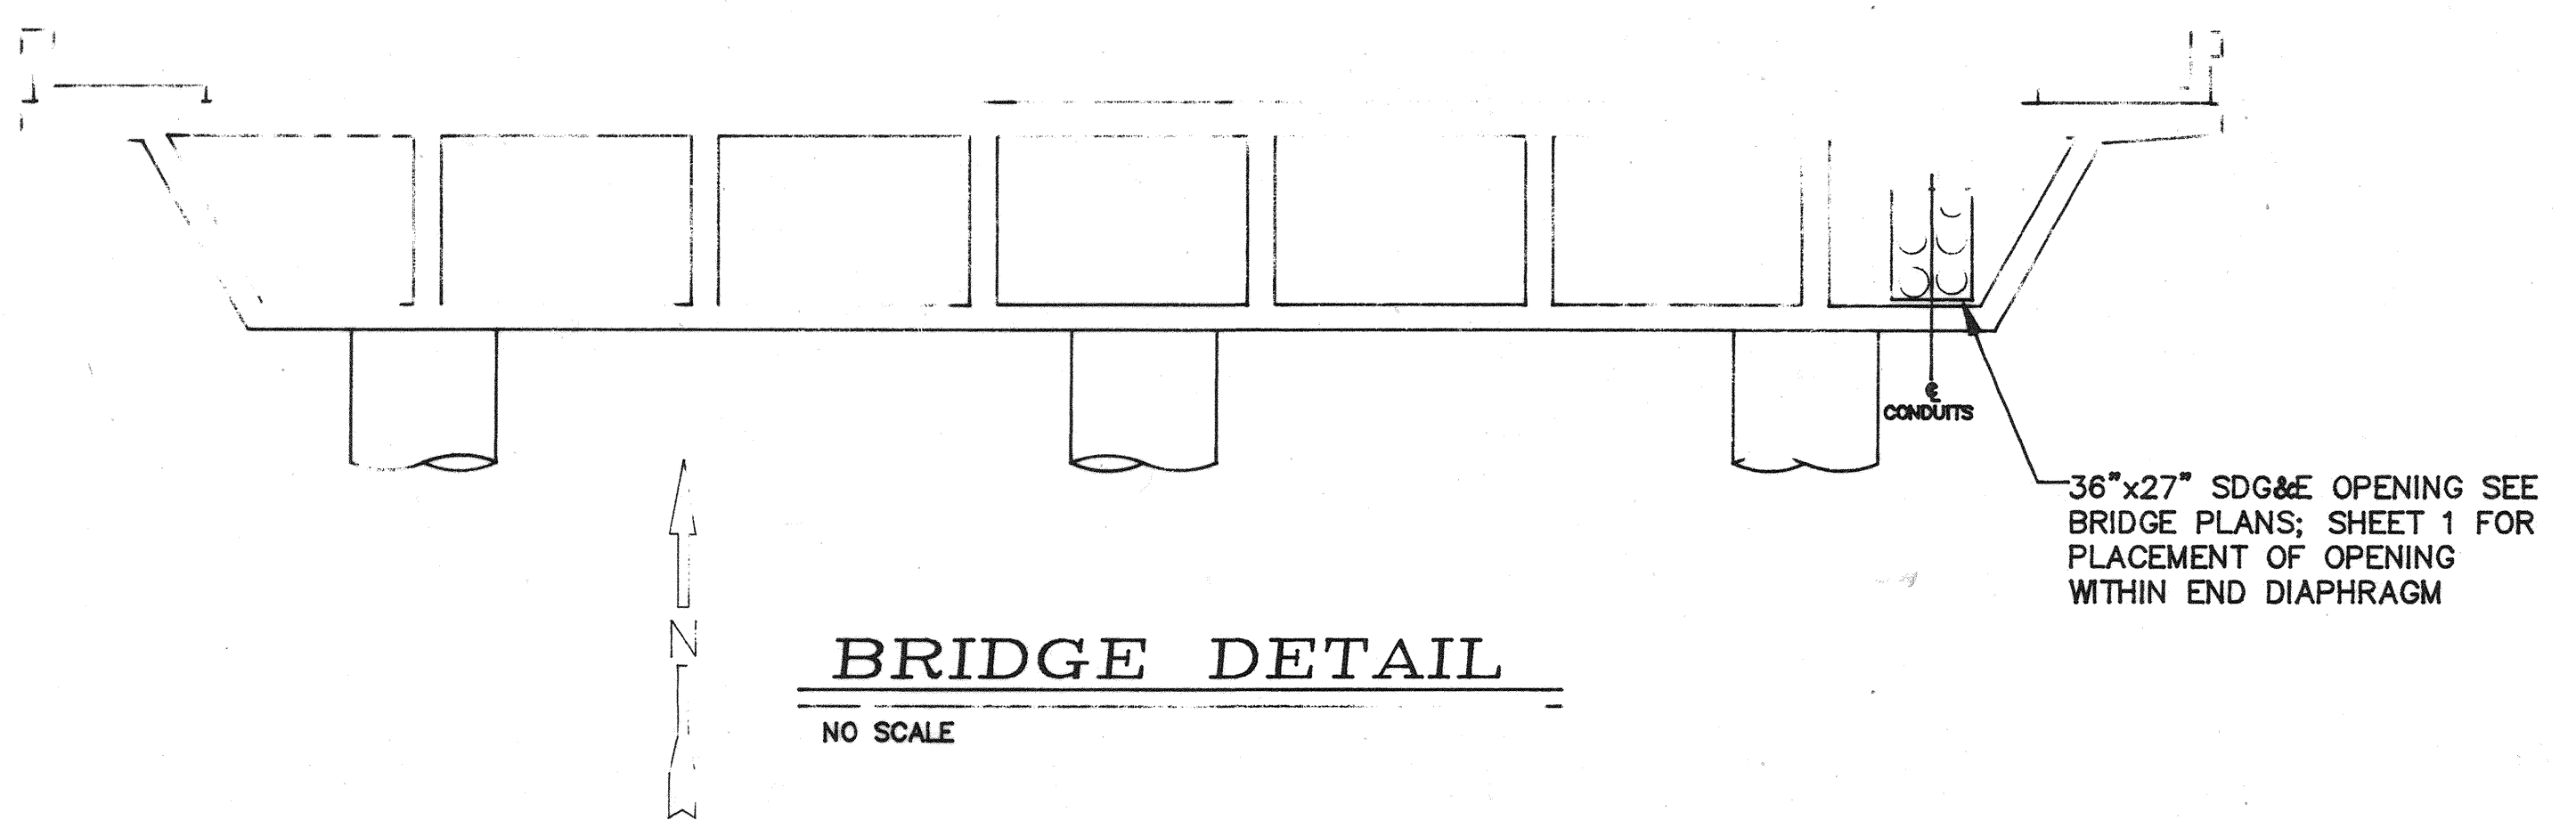

**BRIDGE DETAIL**

NO SCALE

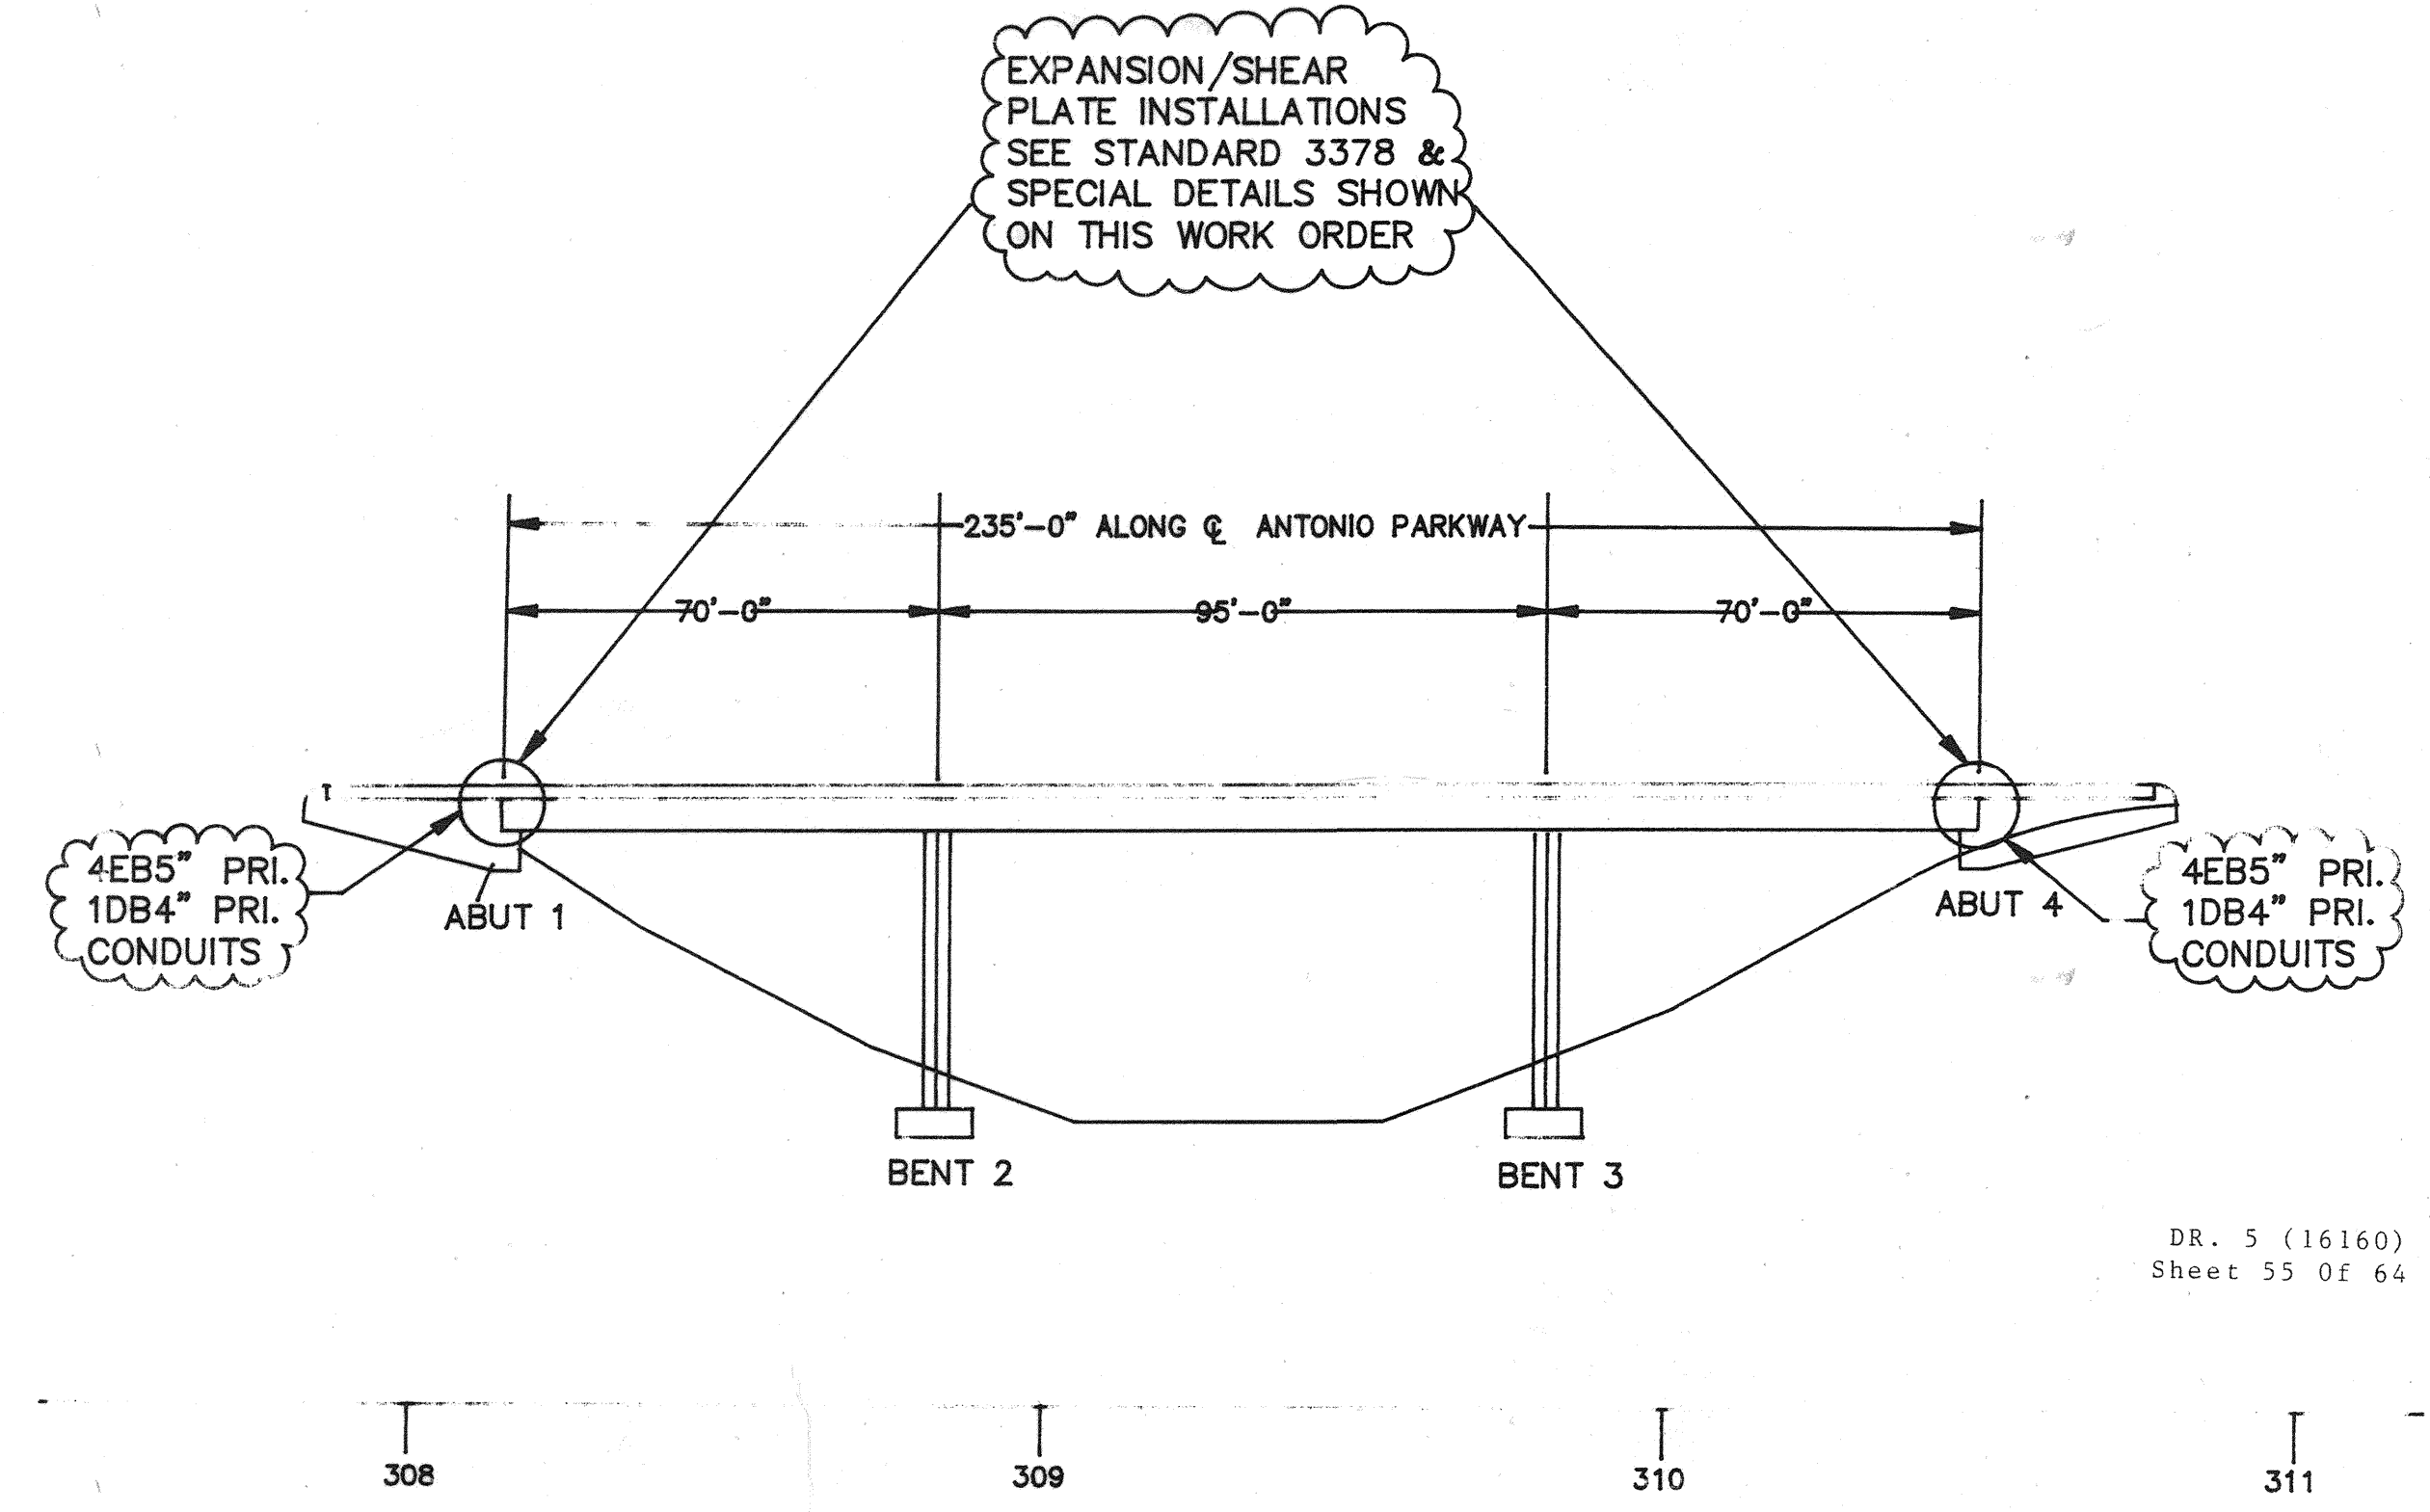

DR. 5 (16160)  
Sheet 55 Of 64

DESIGNED BY PATI GOOD	PLOT DATE 04/03/97	PROJECT NO. 511869-040	SHEET 1 OF 1
CONSTRUCTION ORDER NO. 2546570			SHEET 55 OF 64