



TOC		
Station	Offset from Centerline (ft)	Proposed Elevations (ft)
304+32.00	49.93	602.69
304+50.00	49.53	602.18
304+77.30	48.97	601.42
305+00.00	48.49	600.76
305+25.00	47.97	600.11
305+50.00	47.46	599.48
305+75.00	46.94	598.98
306+00.00	46.41	598.62
306+08.36	46.28	598.46
306+24.95	46.18	598.23
306+29.71	46.27	598.22
306+50.00	46.22	597.92
306+56.44	46.24	597.85
306+60.79	46.25	597.75
306+69.78	46.26	597.63
306+75.00	46.26	597.56
306+79.88	46.25	597.50
306+91.21	46.26	597.35
306+95.83	46.33	597.34
307+01.93	46.17	597.23
307+00.00	46.22	597.26
307+16.47	46.27	597.11
307+19.73	46.29	597.07
311+00.00	46.08	599.02
311+25.00	46.14	599.61
311+50.00	46.24	600.14
311+75.00	46.18	600.68
312+00.00	46.18	601.19
312+25.00	46.36	601.74
312+50.00	46.56	602.23
312+75.00	46.84	602.73
313+00.00	47.03	603.21
313+25.00	47.24	603.65
313+50.00	47.42	604.07
313+75.00	47.64	604.45
314+00.00	47.86	604.82
314+25.00	48.07	605.19
314+50.00	48.27	605.53
314+75.00	48.46	605.85
315+00.00	48.67	606.17
315+25.00	48.88	606.41
315+50.00	49.10	606.64
315+75.00	49.28	606.83
316+00.00	49.48	607.01
316+25.00	49.69	607.12
316+50.00	49.89	607.32
316+75.00	50.09	607.46
317+00.00	50.29	607.55
317+25.00	50.49	607.58
317+50.00	50.70	607.59
317+75.00	50.92	607.59
318+00.00	51.08	607.58
318+25.00	51.14	607.54
318+50.00	51.15	607.47
318+75.00	51.12	607.38
319+00.00	51.14	607.26
319+25.00	51.15	607.13
319+50.00	51.16	606.98
319+75.00	51.13	606.77
320+00.00	51.17	606.53
320+25.00	51.18	606.29
320+50.00	51.17	606.03
320+75.00	51.22	605.76
321+00.00	51.23	605.45
321+25.00	51.17	605.08
321+50.00	51.23	604.69
321+75.00	51.24	604.30
322+00.00	51.26	603.88


6S2 - NORTHBOUND SIDEWALK
TOP OF CURB

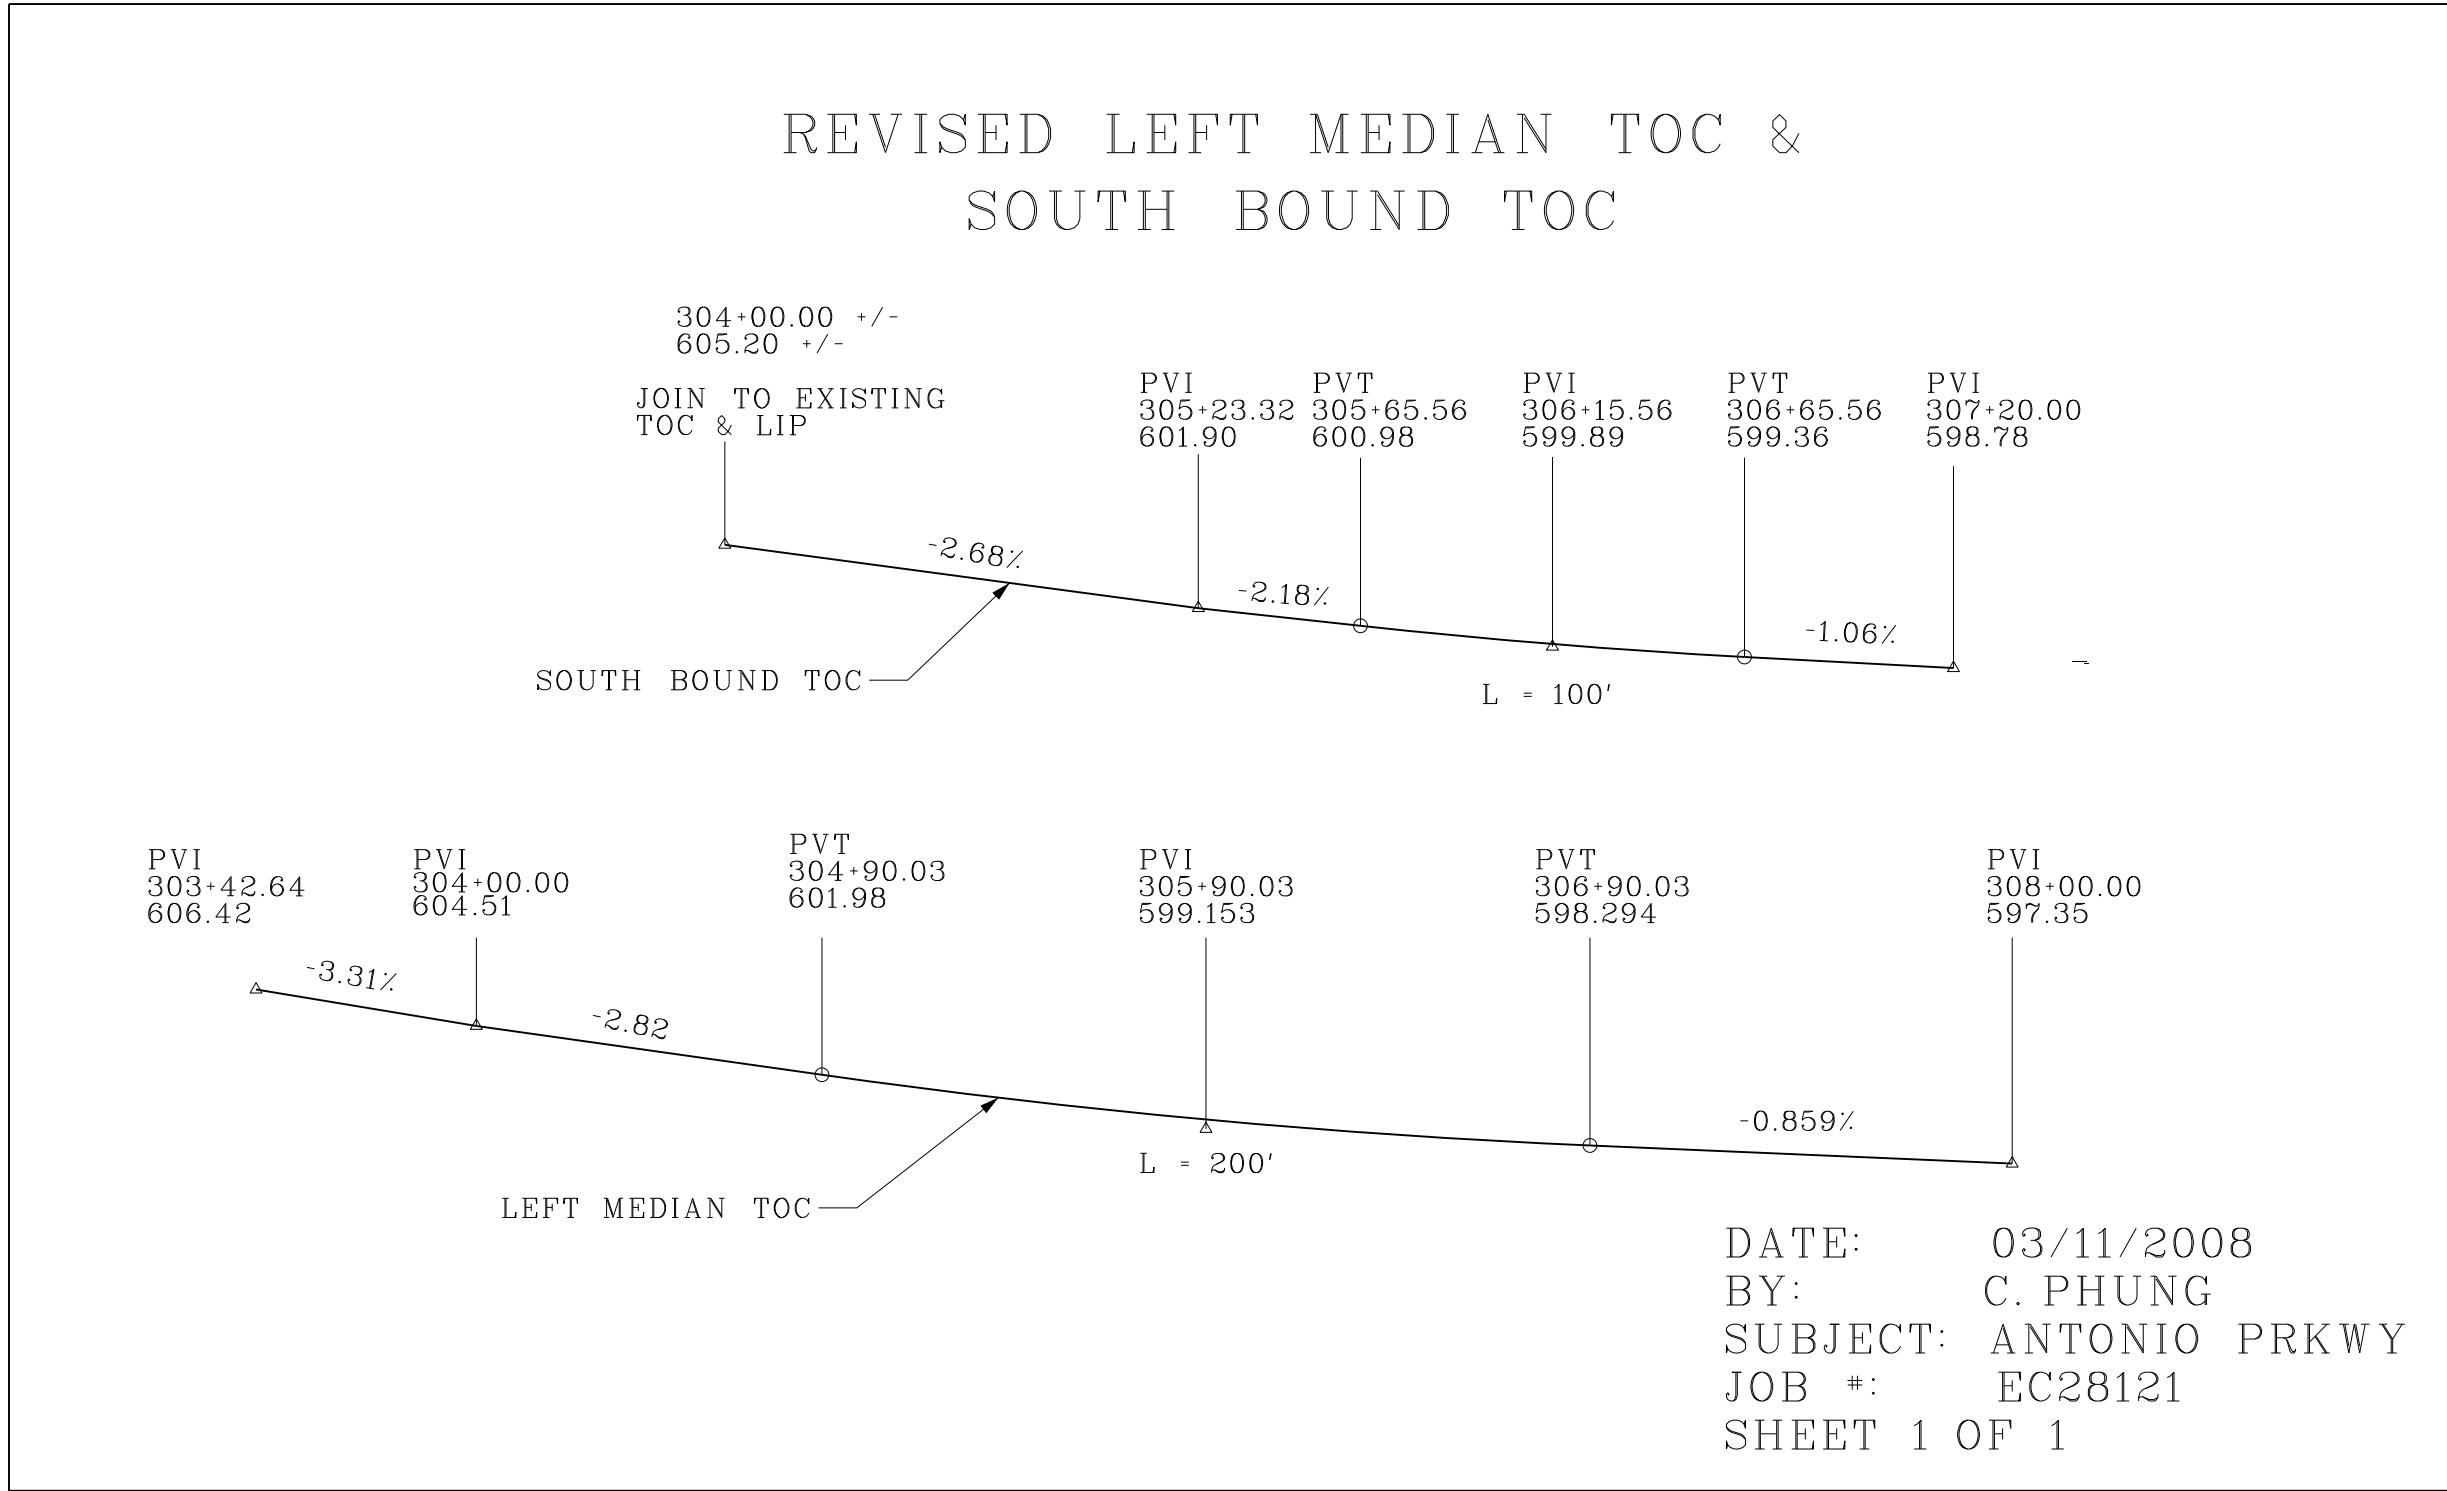

6S1 - SOUTHBOUND MEDIAN
AND SIDEWALK TOP OF CURB

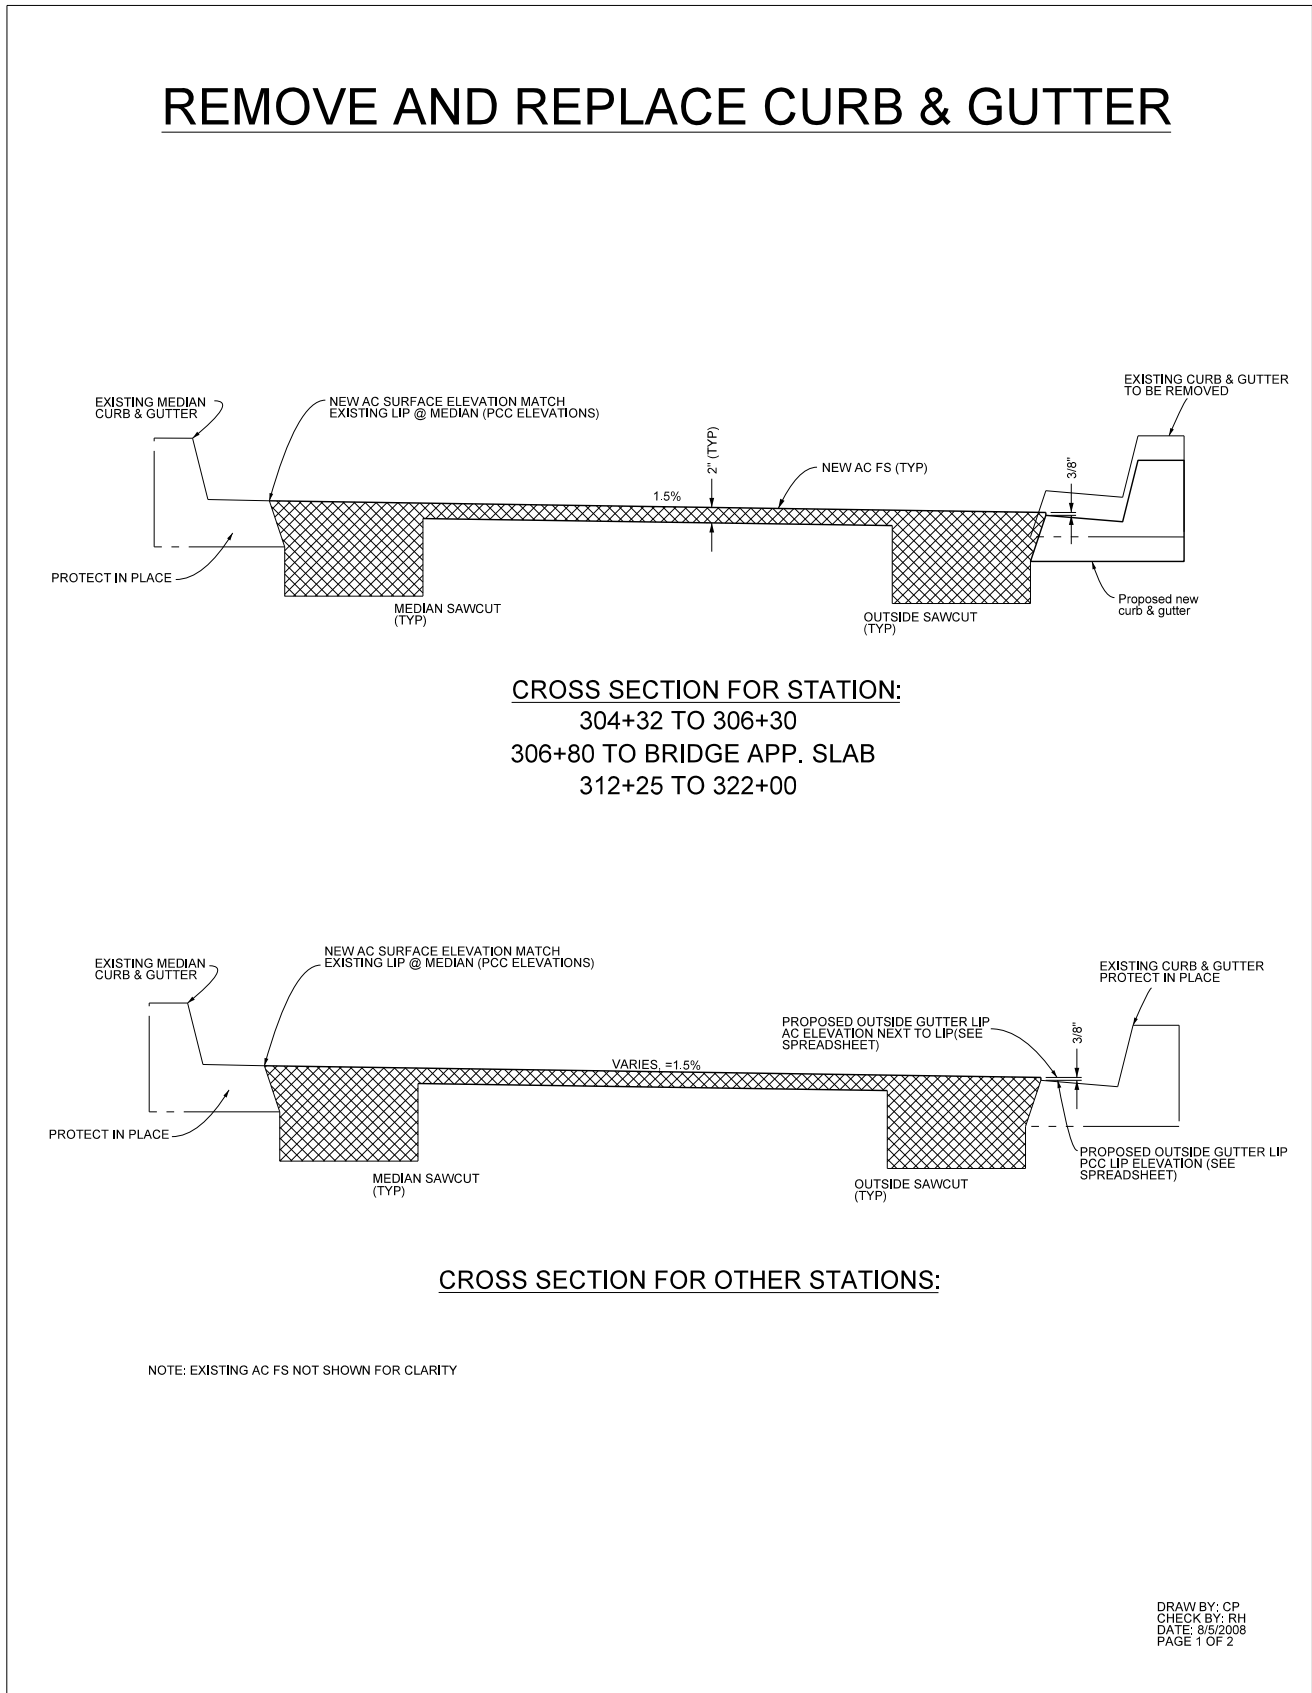

6S3 - NORTHBOUND GRIDNING

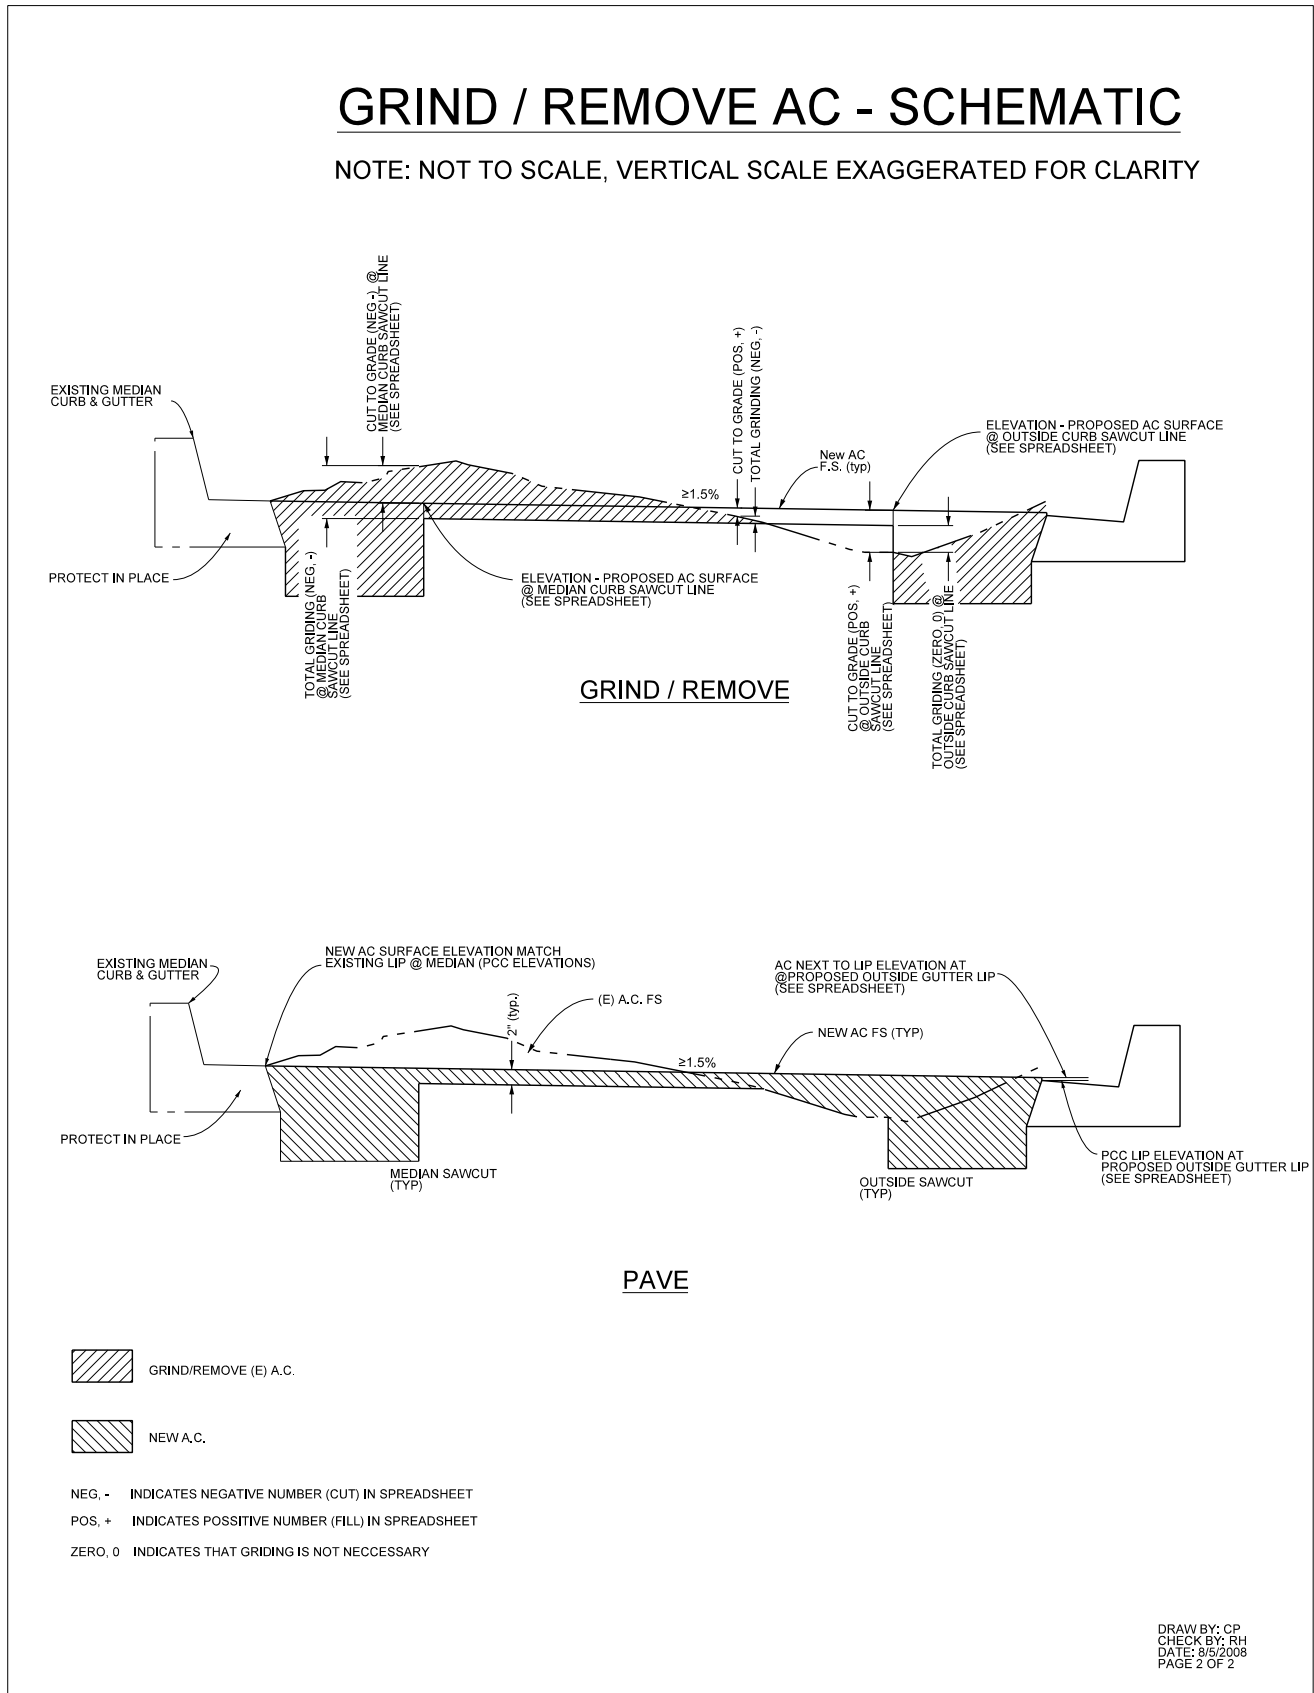

AS BUILT

CORRECTION BY: MN

CONTRACT NO.: EC28121

DATE: 12/30/2009

PLAN 1"=		ORANGE COUNTY PUBLIC FACILITIES AND RESOURCES DEPARTMENT	
		ANTONIO PARKWAY WILDLIFE UNDERCROSSING (WIDEN)	
		PLAN & PROFILE L-2	
MARK	DATE	DESCRIPTION	
REVISIONS			
PREPARED UNDER RESPONSIBLE CHARGE OF:			
DESIGNED		CHECKED	
DRAWN		DATE	
SCALE AS SHOWN		DRAWING NO.	
SHEET 6S		OF 72	

Date Plotted:

File Name: