

PROFILE  
HORIZ. 1" = 40'  
VERT. 1" = 4'

#### NOTE


THE PROPOSED VERTICAL ALIGNMENT AND SUPERELEVATION OF ANTONIO PARKWAY IS BASED ON THE EXISTING ROADWAY. THE PROFILE AND SUPERELEVATION DIAGRAM OF THE EXISTING ROADWAY WAS CONSTRUCTED FROM THAT OF THE "ANTONIO PARKWAY PHASE III" PROJECT, WHICH IS INCLUDED AS A REFERENCE IN APPENDIX 7 OF THE PROJECT SPECIFICATIONS

## AS BUILT

CORRECTION BY:         MN          
CONTRACT NO.:         EC28121          
DATE:         12/30/2009        

#### CONSTRUCTION NOTES

- 1 CONSTRUCT P.C.C. CURB & GUTTER TYPE A2-8 PER RDMD STD. PLAN 120-0-0C.
- 2 CONSTRUCT P.C.C. CURB & GUTTER TYPE A3-8 PER RDMD STD. PLAN 120-0-0C.
- 3 CONSTRUCT P.C.C. CURB & GUTTER TYPE A2-8, W=12" PER RDMD STD. PLAN 120-0-0C.
- 4 CONSTRUCT PCC CURB & GUTTER TYPE A3-8, W=12", PER RDMD STD PLAN 120-0-0C.
- 5 CONSTRUCT 14" A.C.
- 6 CONSTRUCT PCC SIDEWALK PER RDMD STD PLAN 1205
- 9 COLD PLANE 2" AND RESURFACE A.C. PAVEMENT 2" MINIMUM.
- 12 CONSTRUCT PATTERN-STAMPED MEDIAN PAVING PER RDMD STD PLAN 1807. STA 305+00 TO 325+48.
- 13 REMOVE EXISTING AC DIKE.
- 15 CONCRETE BARRIER (TYPE 25B) SEE SHEET 63 FOR DETAIL
- 16 REMOVE ASPHALT CONCRETE SURFACING
- 17 EXISTING OAK TREE PROTECT IN PLACE.
- 18 EXISTING DRAINAGE FEATURES PROTECT IN PLACE.
- 22 CONCRETE MEDIAN SEE SHEET 70 RAISED MEDIAN DETAIL ON BRIDGE
- 23 REMOVE TREE
- 25 REMOVE EXISTING A.C. SHOULDER AND CONSTRUCT 14" A.C.

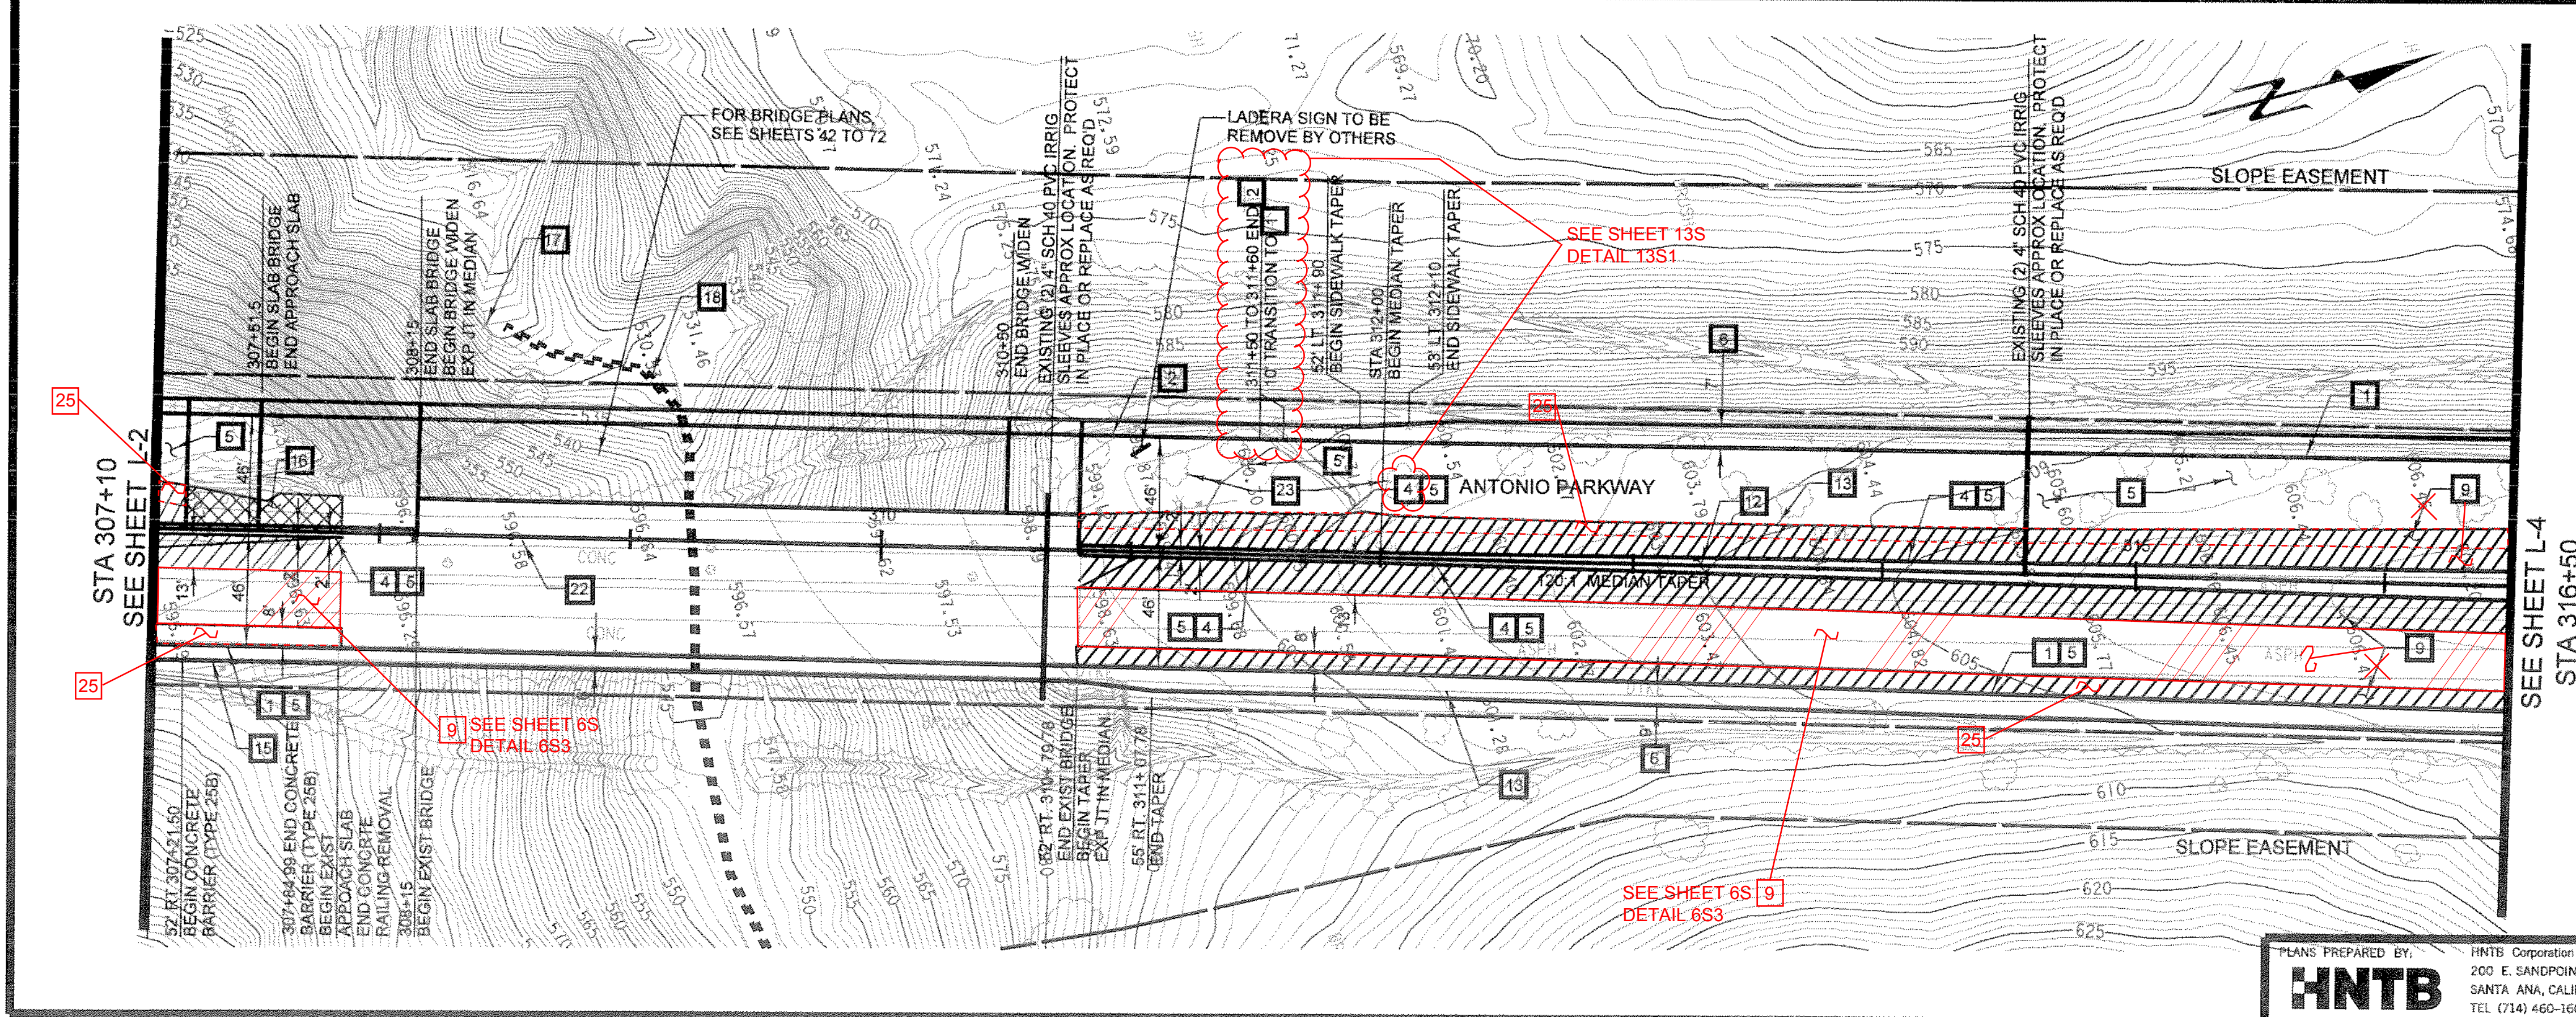

PLANS PREPARED BY:  
**HNTB**  
HNTB Corporation  
200 E. SANDPOINTE AVENUE, SUITE 200  
SANTA ANA, CALIFORNIA 92707  
TEL (714) 460-1600 FAX (714) 460-1610

PLAN 1" = 40'	
MARK	DATE
DESCRIPTION	
REVISIONS	
PREPARED UNDER RESPONSIBLE CHARGE OF:	
DESIGNED: R. NIESE	
DRAWN: N. BUMA	
CHECKED: S. STRON	
SCALE: AS SHOWN	
DATE: 11/16/05	
DRAWING NO. xxx	
SHEET 7 OF 72	

ORANGE COUNTY  
RESOURCES & DEVELOPMENT MANAGEMENT DEPT  
ANTONIO PARKWAY  
WILDLIFE  
IMPROVEMENT PLANS  
STA 307+10 TO 316+50  
PLAN & PROFILE  
L-3

DESIGNED: R. NIESE  
DRAWN: N. BUMA  
CHECKED: S. STRON  
SCALE: AS SHOWN  
DATE: 11/16/05  
DRAWING NO. xxx  
SHEET 7 OF 72

Date Plotted: dd-mm-yyyy hh:mm

File Name: SDGN-FILE-NAMES