


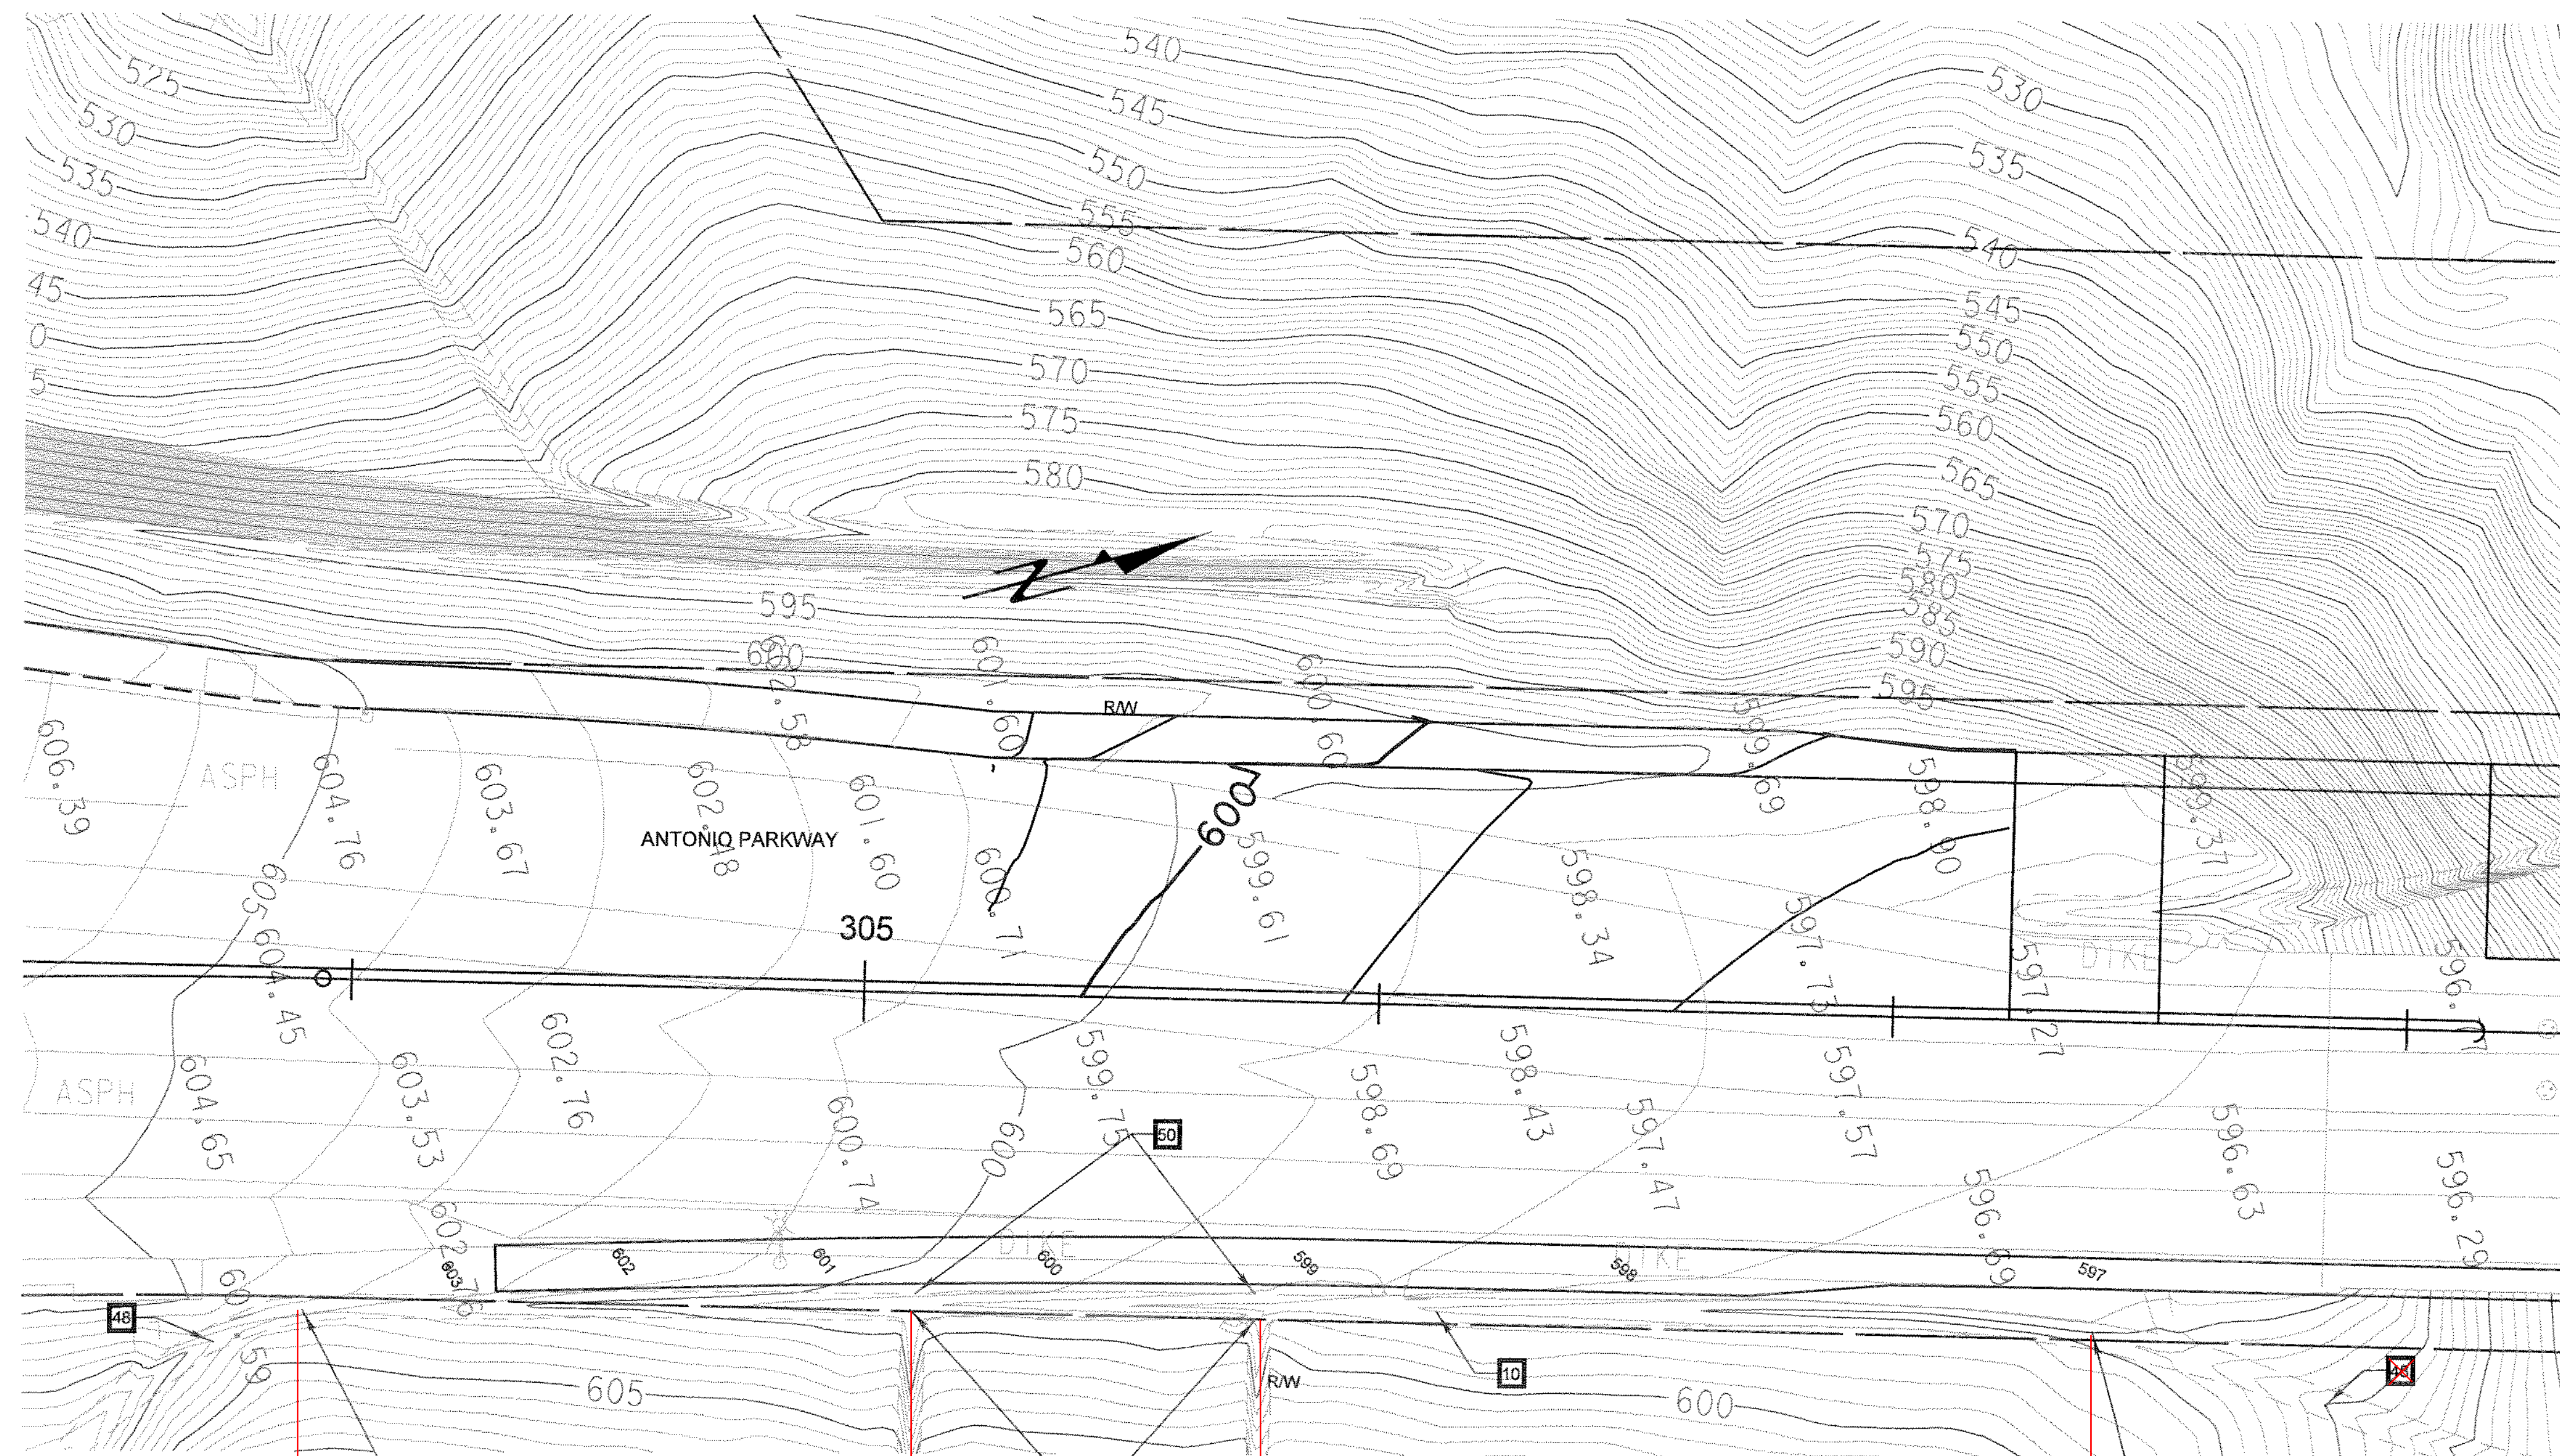

CONSTRUCTION NOTES

- 10 TERRACE DRAIN PER RDMD STD. PLAN 1321.
- 24 REMOVE EXISTING TERRACE DRAIN.
- 48 PROTECT-IN-PLACE EXISTING TERRACE DRAIN.
- 50 REMOVE INTERFERING PORTION OF EXISTING DOWN DRAIN. CUT TO CLEAN LINE.

10 BEGIN TERRACE DRAIN
JOIN EXISTING
24 BEGIN REMOVE EXISTING
TERRACE DRAIN

303+92, 64' RT

TIE INTO EXISTING
DOWN DRAINS
INSTALL SPLASH WALL PER
RDMD STD PLAN 1321

305+78, 62' RT

10 END TERRACE DRAIN
JOIN EXISTING
24 END REMOVE EXISTING
TERRACE DRAIN

307+44, 62' RT

AS BUILT

CORRECTION BY: MN

CONTRACT NO.: EC28121

DATE: 12/30/2009

PLANS PREPARED BY:
HNTB
HNTB Corporation
200 E. SANDPOINT AVENUE, SUITE 200
SANTA ANA, CALIFORNIA 92707
TEL (714) 460-1600 FAX (714) 460-1610

PLAN		1" = 20'	
MARK	DATE	DESCRIPTION	
REVISIONS			
PREPARED UNDER RESPONSIBLE CHARGE OF:			
DESIGNED: J. NIEME			
DRAWN: N. BUNA			
CHECKED: S. STRICH			
SCALE: AS SHOWN			
DATE: 11/18/05			
DRAWING NO. 100			
SHEET 9 OF 72			

ORANGE COUNTY
RESOURCES & DEVELOPMENT MANAGEMENT DEPT
ANTONIO PARKWAY
WILDLIFE
IMPROVEMENT PLANS
STA 300+00 TO 307+10
CONTOUR GRADING PLAN
G-1

DESIGNED: J. NIEME
DRAWN: N. BUNA
CHECKED: S. STRICH
SCALE: AS SHOWN
DATE: 11/18/05
DRAWING NO. 100
SHEET 9 OF 72

Date Plotted: dd-mm-yyyy hh:mm

File Name: SDGN-FILE-NAMES