


AS BUILT

CORRECTION BY: MN
 CONTRACT NO.: EC28121
 DATE: 12/30/2009

PLANS PREPARED BY:
HNTB
 HNTB Corporation
 200 E. SANDPOINTE AVENUE, SUITE 200
 SANTA ANA, CALIFORNIA 92707
 TEL (714) 460-1600 FAX (714) 460-1610

STEVEN B. STROH
 RCE C 59687 (EXP. 12-31-11)

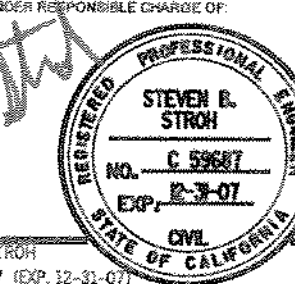

ORANGE COUNTY
 RESOURCES & DEVELOPMENT MANAGEMENT DEPT
 ANTONIO PARKWAY
 WILDLIFE
 IMPROVEMENT PLANS
**CROSS SECTIONS FOR
 CONTOUR GRADING PLAN
 G-2**

DESIGNED: S. STROH SHEET
 DRAWN: S. STROH CHECKED: S. STROH **10**
 SCALE: AS SHOWN DATE: 11/18/05 DRAWING NO.: xxx OF 72

Date Plotted: dd-mmm-yyyy hh:mm

File Name: SDGN-FILE-NAMES

Border sheet last modified 03-Nov-1999