


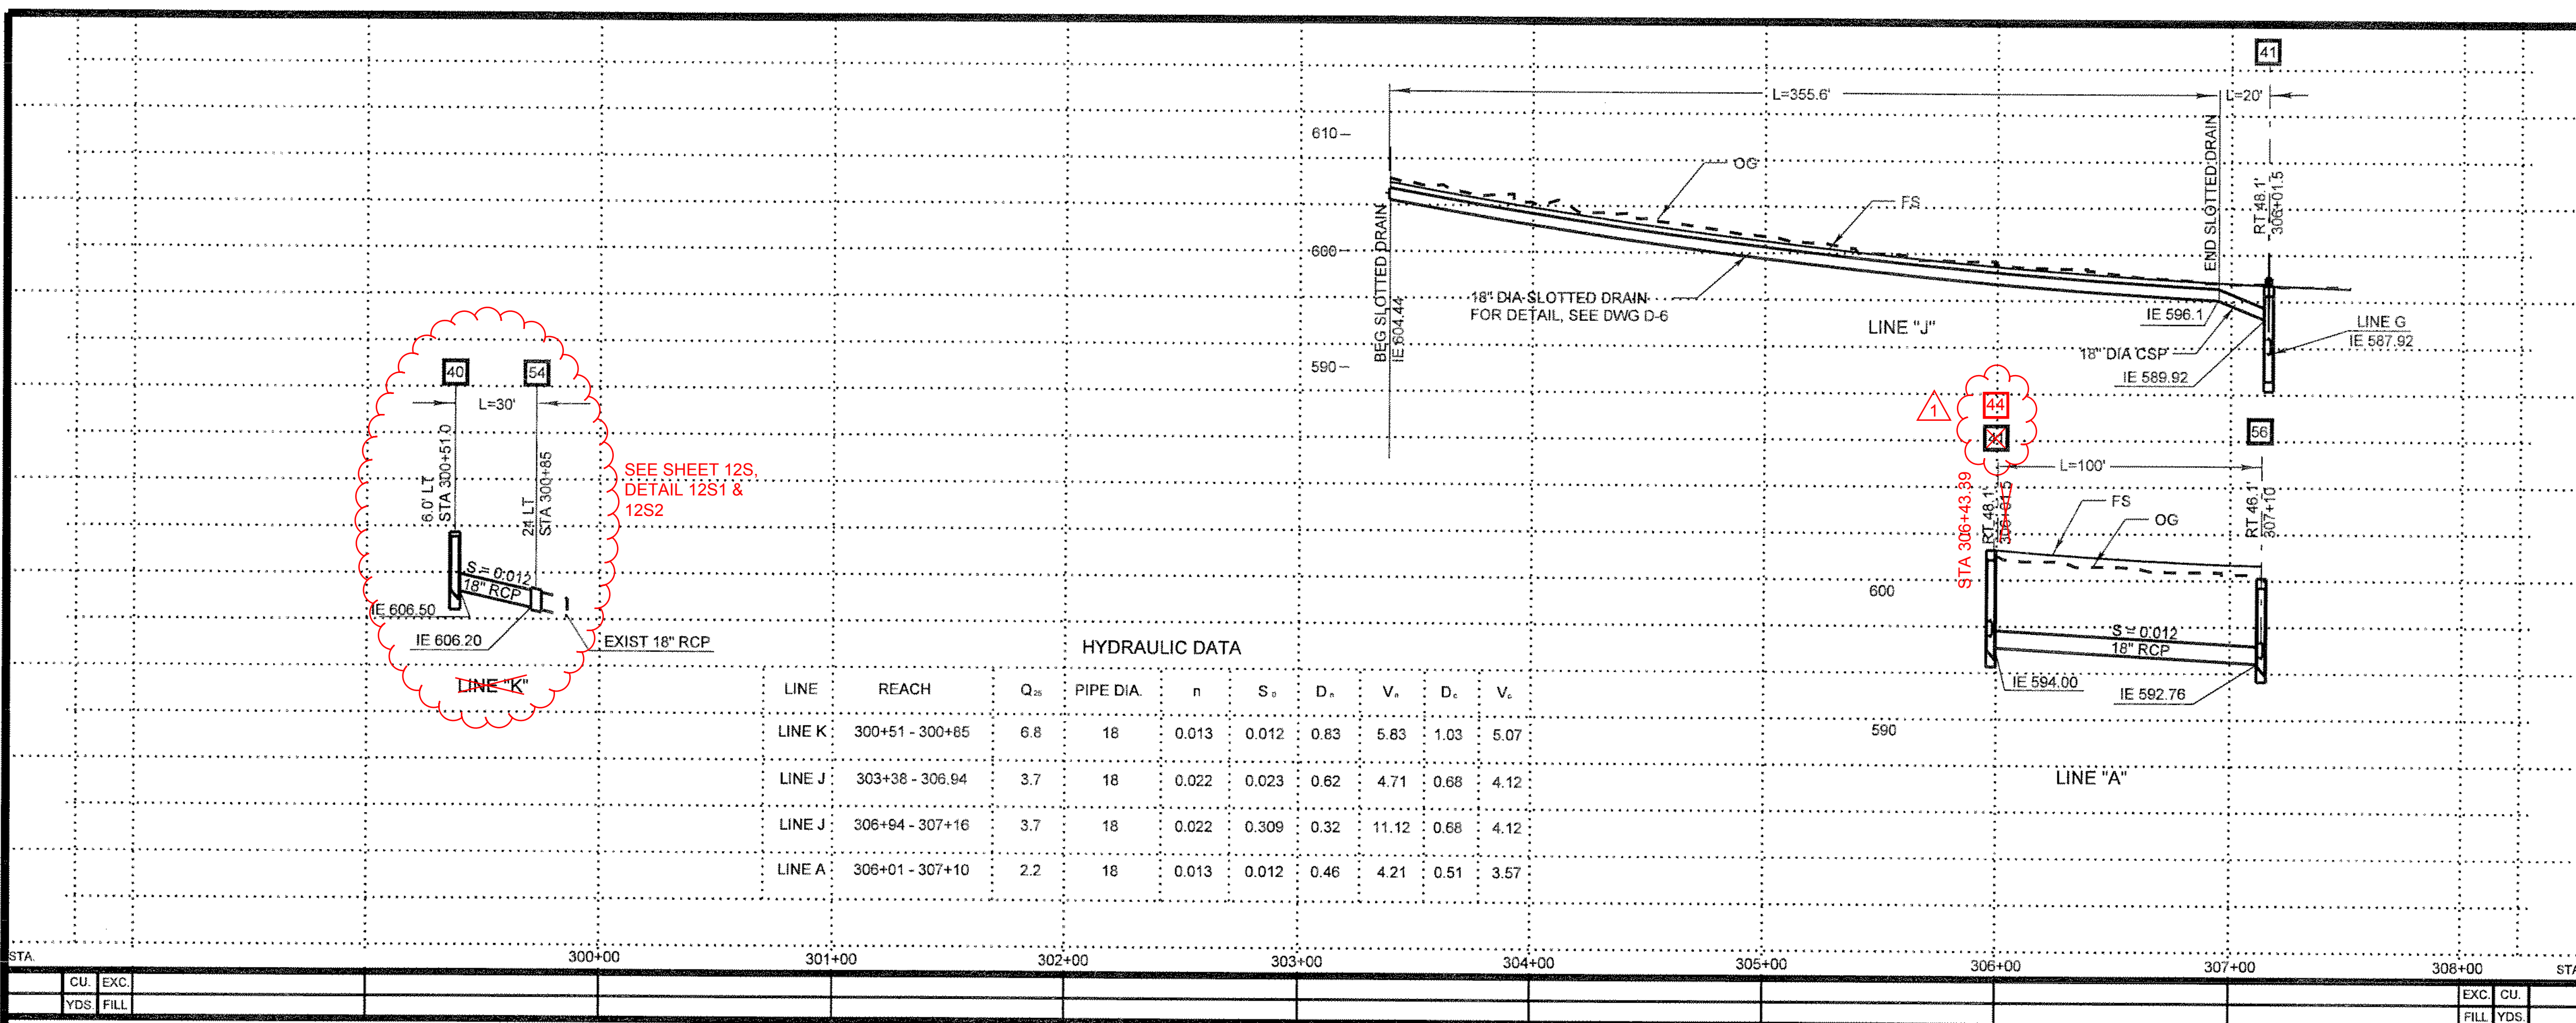

PROFILE
HORIZ. 1" = 40'
VERT. 1" = 8'

D-RATING


Line(s)	RCP Size	D-Rating
A, K	18"	1600
D, E	18"	2500
C, F, G, H	24"	1600

AS BUILT

CORRECTION BY: MN

CONTRACT NO.: ER28121

DATE: 12/30/2009

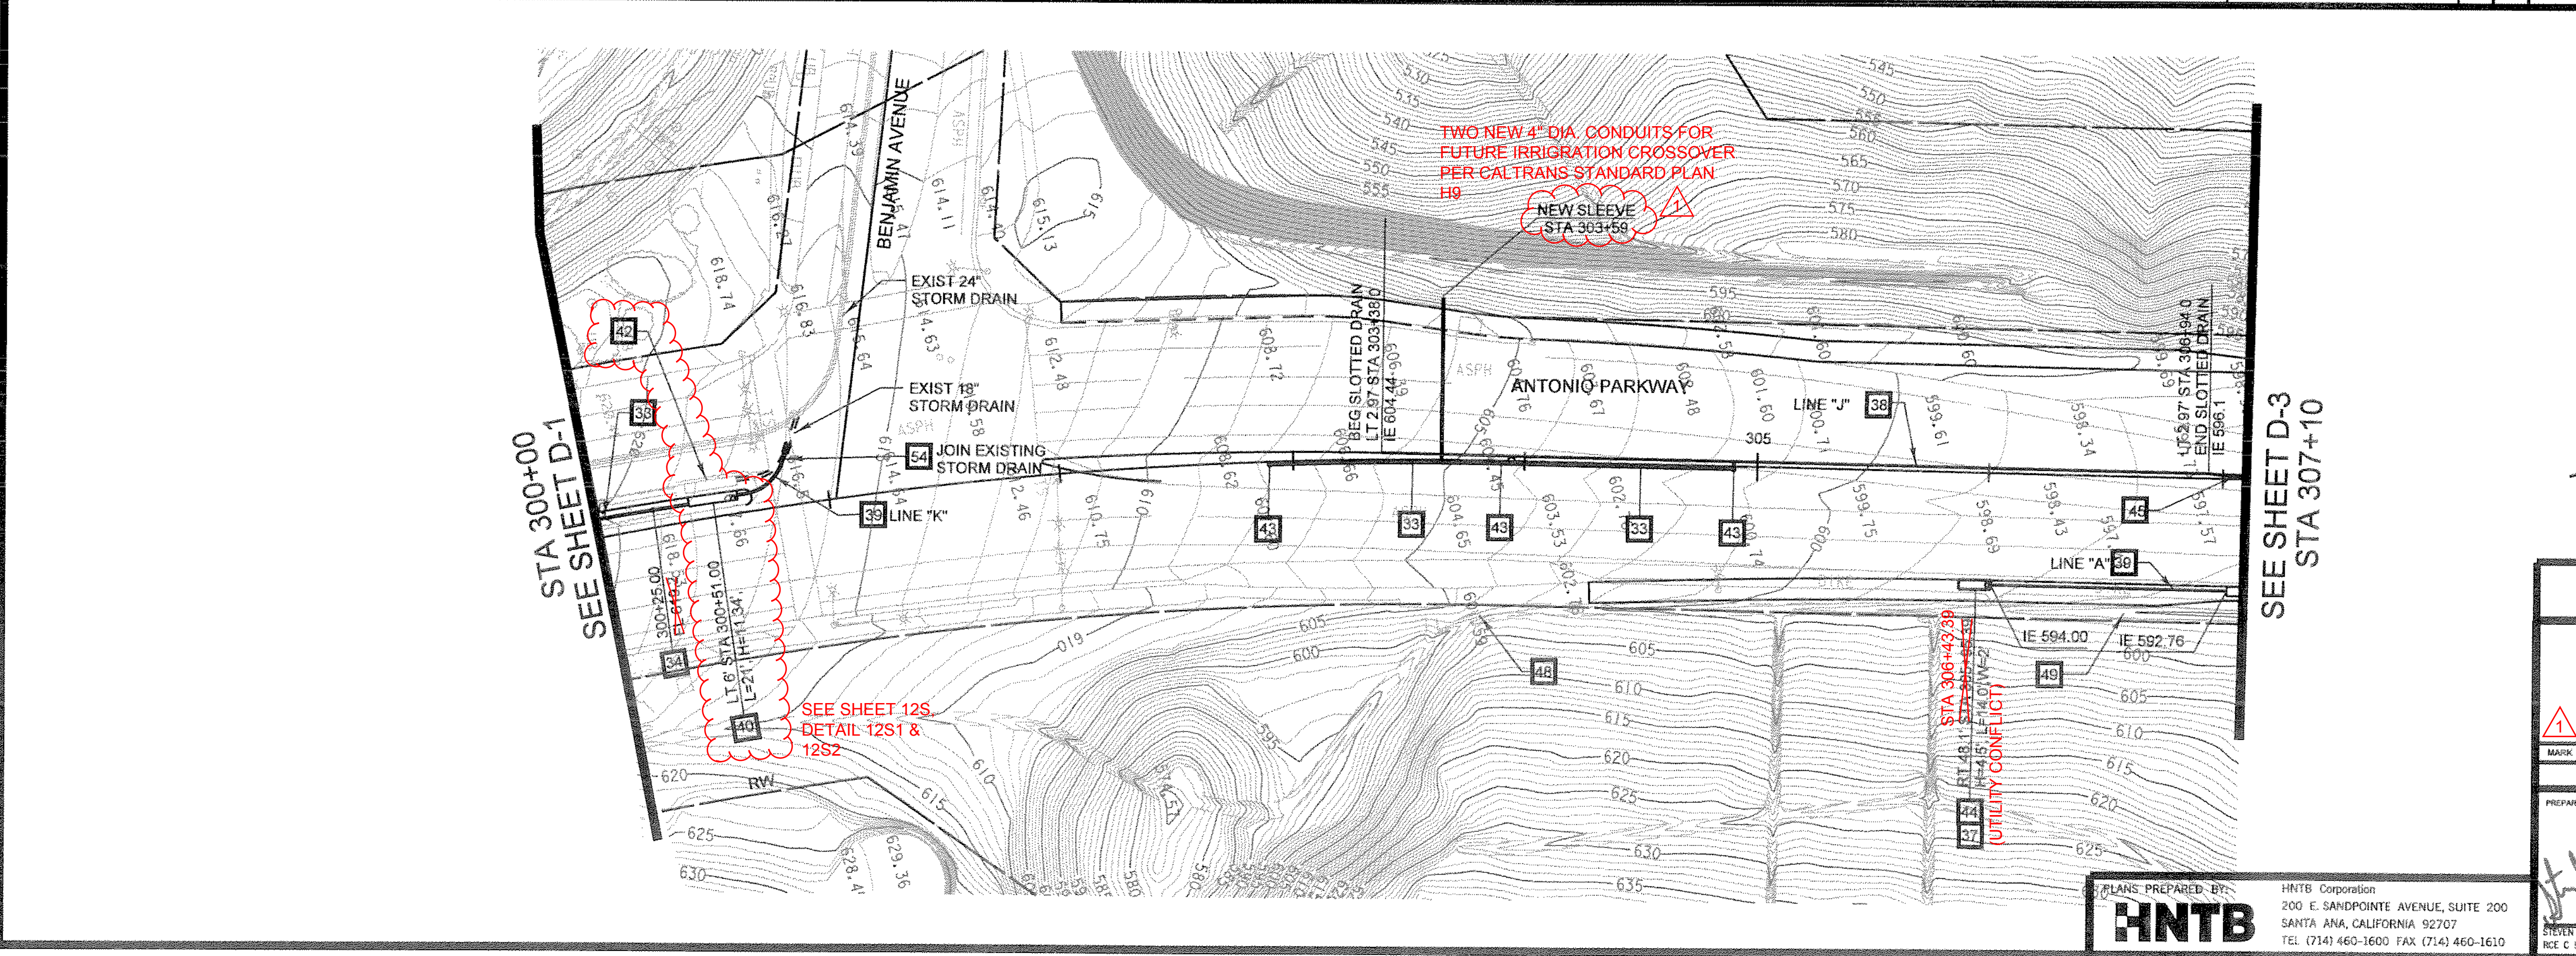

CONSTRUCTION NOTES

- 33 INSTALL 8" PVC
- 34 INSTALL MEDIAN GRATE INLET, SEE DETAIL A, SHT D-5
- 37 INSTALL MODIFIED LOCAL DEPRESSION. SEE SHEET D-5.
- 38 INSTALL SLOTTED DRAIN. SEE DETAILS ON D-6
- 39 INSTALL 18" RCP
- 40 CONSTRUCT INLET TYPE II PER R.D.M.D. STD PLAN 1302
- 41 CONSTRUCT JUNCTION STRUCTURE TYPE I PER R.D.M.D. STD PLAN 1310 (FIELD VERIFY H)
- 42 REMOVE EXIST CB
- 43 INSTALL MEDIAN GRATE INLET, SEE DETAIL B, SHT D-5
- 44 CONSTRUCT MODIFIED TYPE II INLET WITH WATER QUALITY EQUIPMENT PER DETAIL ON SHEET D-7
- 45 INSTALL 18" CSP (10 GAGE) WITH 10 GAGE TAPERED SPACER
- 48 PROTECT-IN-PLACE EXIST TERRACE DRAIN
- 49 REMOVE EXISTING TERRACE DRAIN
- 54 CONSTRUCT CONCRETE COLLAR PER RDMD STD PLAN 1317

PLAN
1" = 40'

1/23/07 BULLETIN #1

REVISIONS

PREPARED UNDER RESPONSIBLE CHARGE OF:

STEVEN B. STROH
C 59887
12-3-07
CIVIL
STATE OF CALIFORNIA

ORANGE COUNTY
RESOURCES & DEVELOPMENT MANAGEMENT DEPT

ANTONIO PARKWAY
WILDLIFE
IMPROVEMENT PLANS

STA 300+00 TO 307+10
DRAINAGE PLAN
D-2

DESIGNED: R. NIEBE
DRAWN: N. RUNDA
CHECKED: S. STROH

SCALE: AS SHOWN
DATE: 11/16/05
DRAWING NO.:
SHEET: 12 OF 72

Date Plotted: dd-mm-yyyy hh:mm File Name: \$DCN-FILE-NAME\$