


12S-1 - STRUCTURE INLET AT STA 300+51

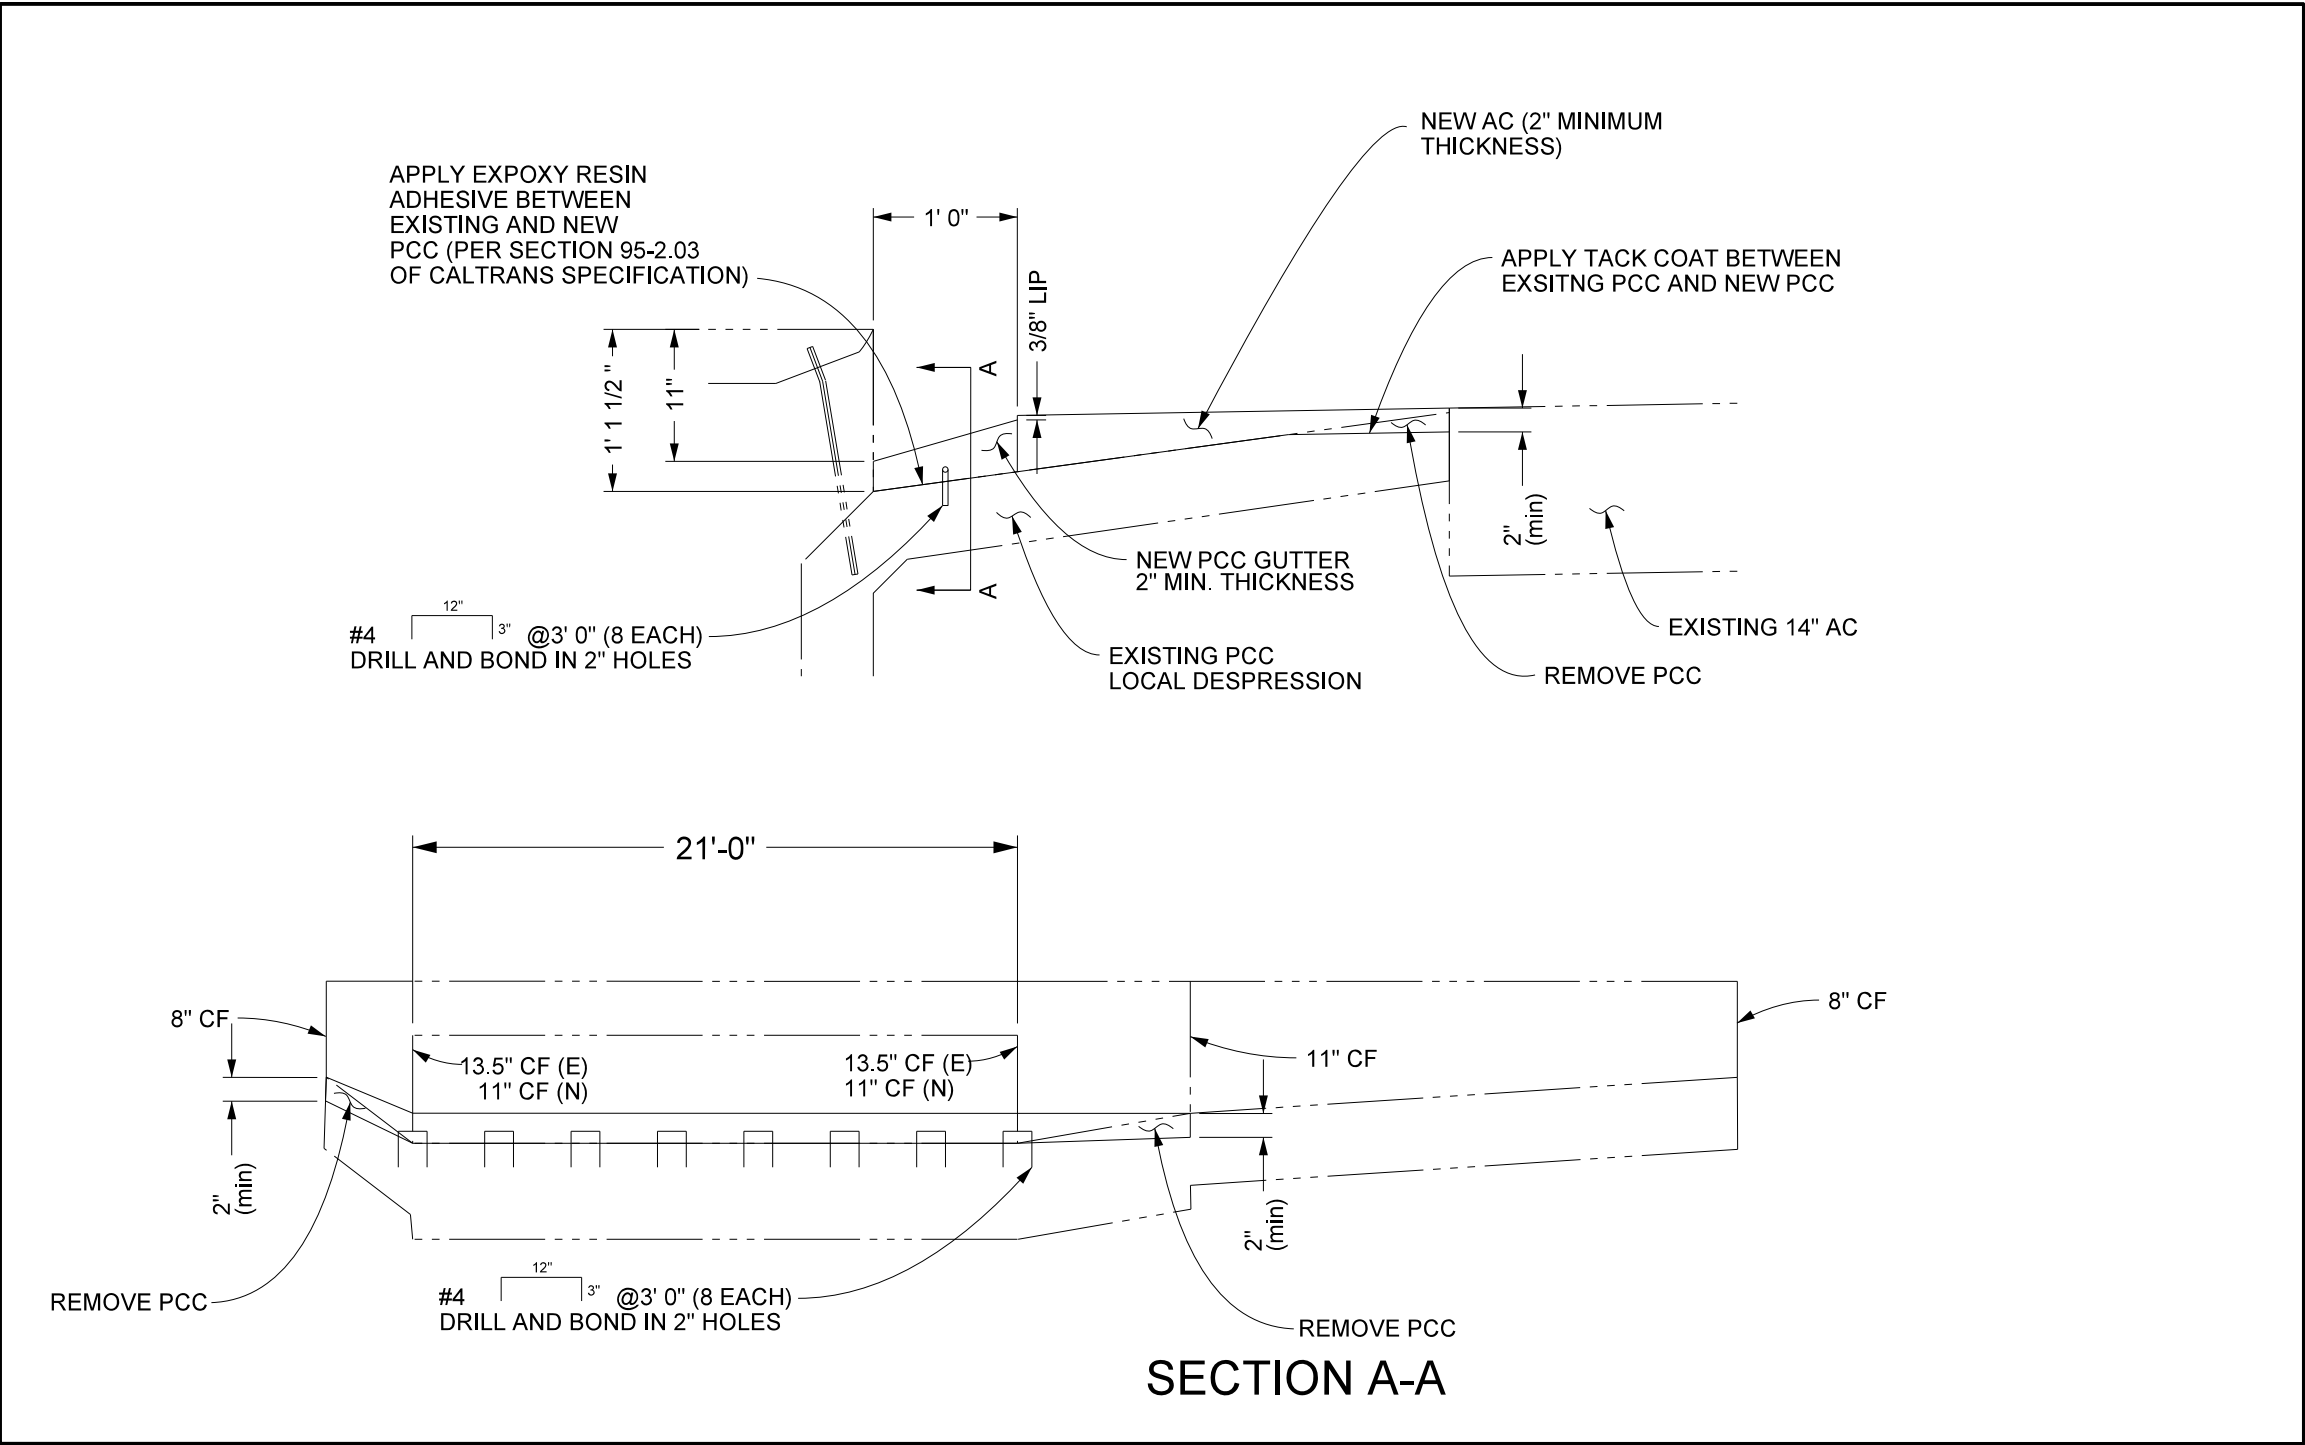

12S-2 - LOCAL DEPRESSION AT 300+51

**AS BUILT**  
CORRECTION BY:           MN            
CONTRACT NO.:           ER28121            
DATE:           12/30/2009          

PLAN 1" =			ORANGE COUNTY PUBLIC FACILITIES AND RESOURCES DEPARTMENT		
			ANTONIO PARKWAY WILDLIFE UNDERCROSSING (WIDEN)		
			STA 300+00 TO 307+10 DRAINAGE PLAN D-2		
REVISIONS			DESIGNED _____		SHEET
			DRAWN _____		12S
			SCALE AS SHOWN	DATE	DRAWING NO.
PREPARED UNDER RESPONSIBLE CHARGE OF:					OF 72