


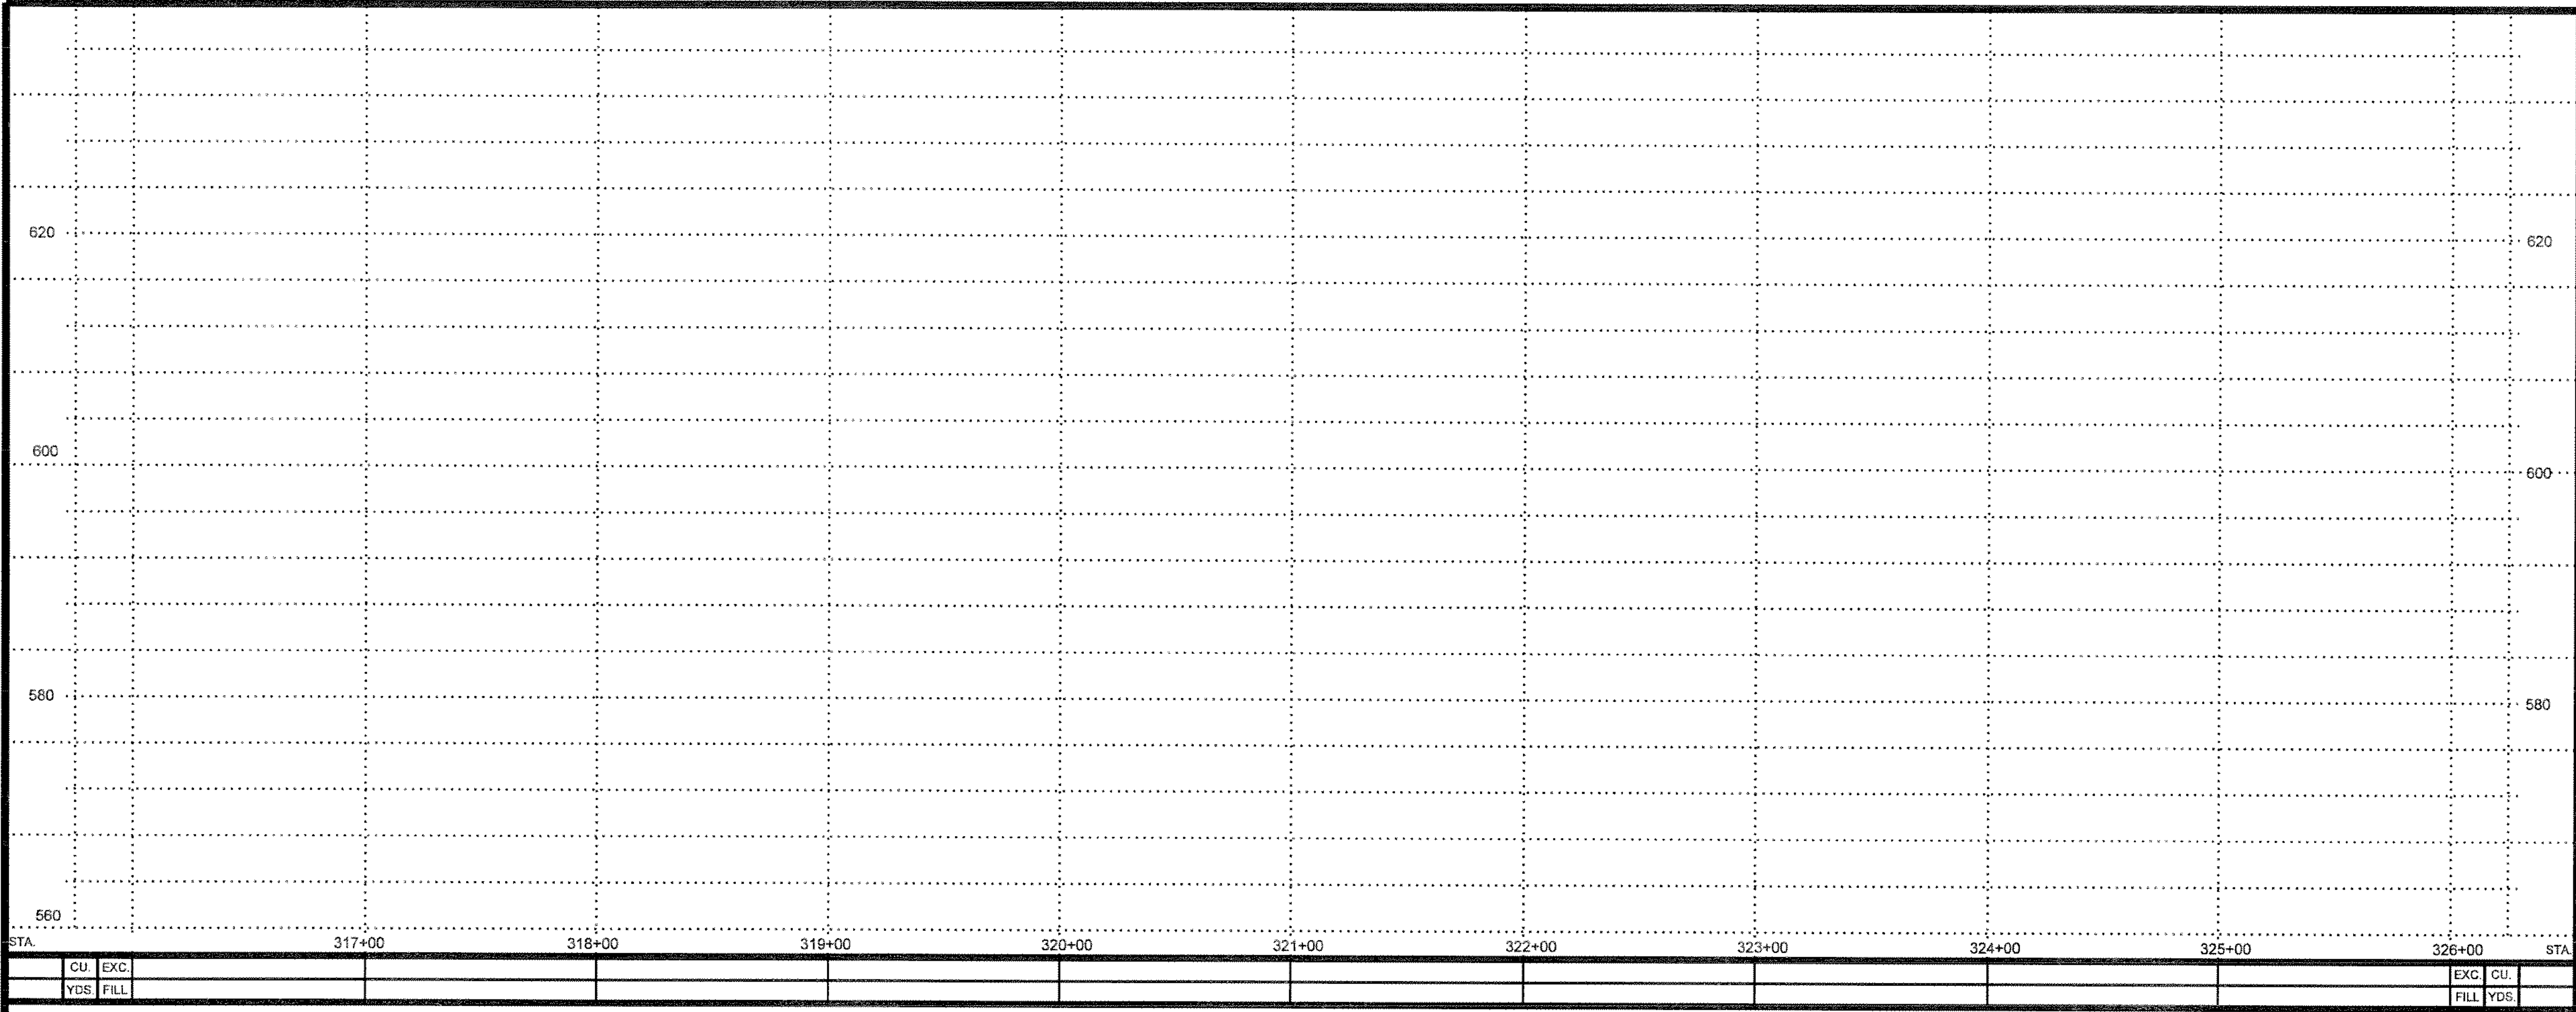

PROFILE
HORIZ. 1" = 40'
VERT. 1" = 4'


NO AS BUILT CHANGES

AS BUILT

CORRECTION BY: MN
CONTRACT NO.: EC28121
DATE: 12/30/2009


CONSTRUCTION NOTES

- 48 PROTECT-IN-PLACE EXISTING TERRACE DRAIN
- 49 REMOVE EXISTING TERRACE DRAIN
- 50 REMOVE INTERFERING PORTION OF EXISTING DOWN DRAIN. CUT TO CLEAN LINE.

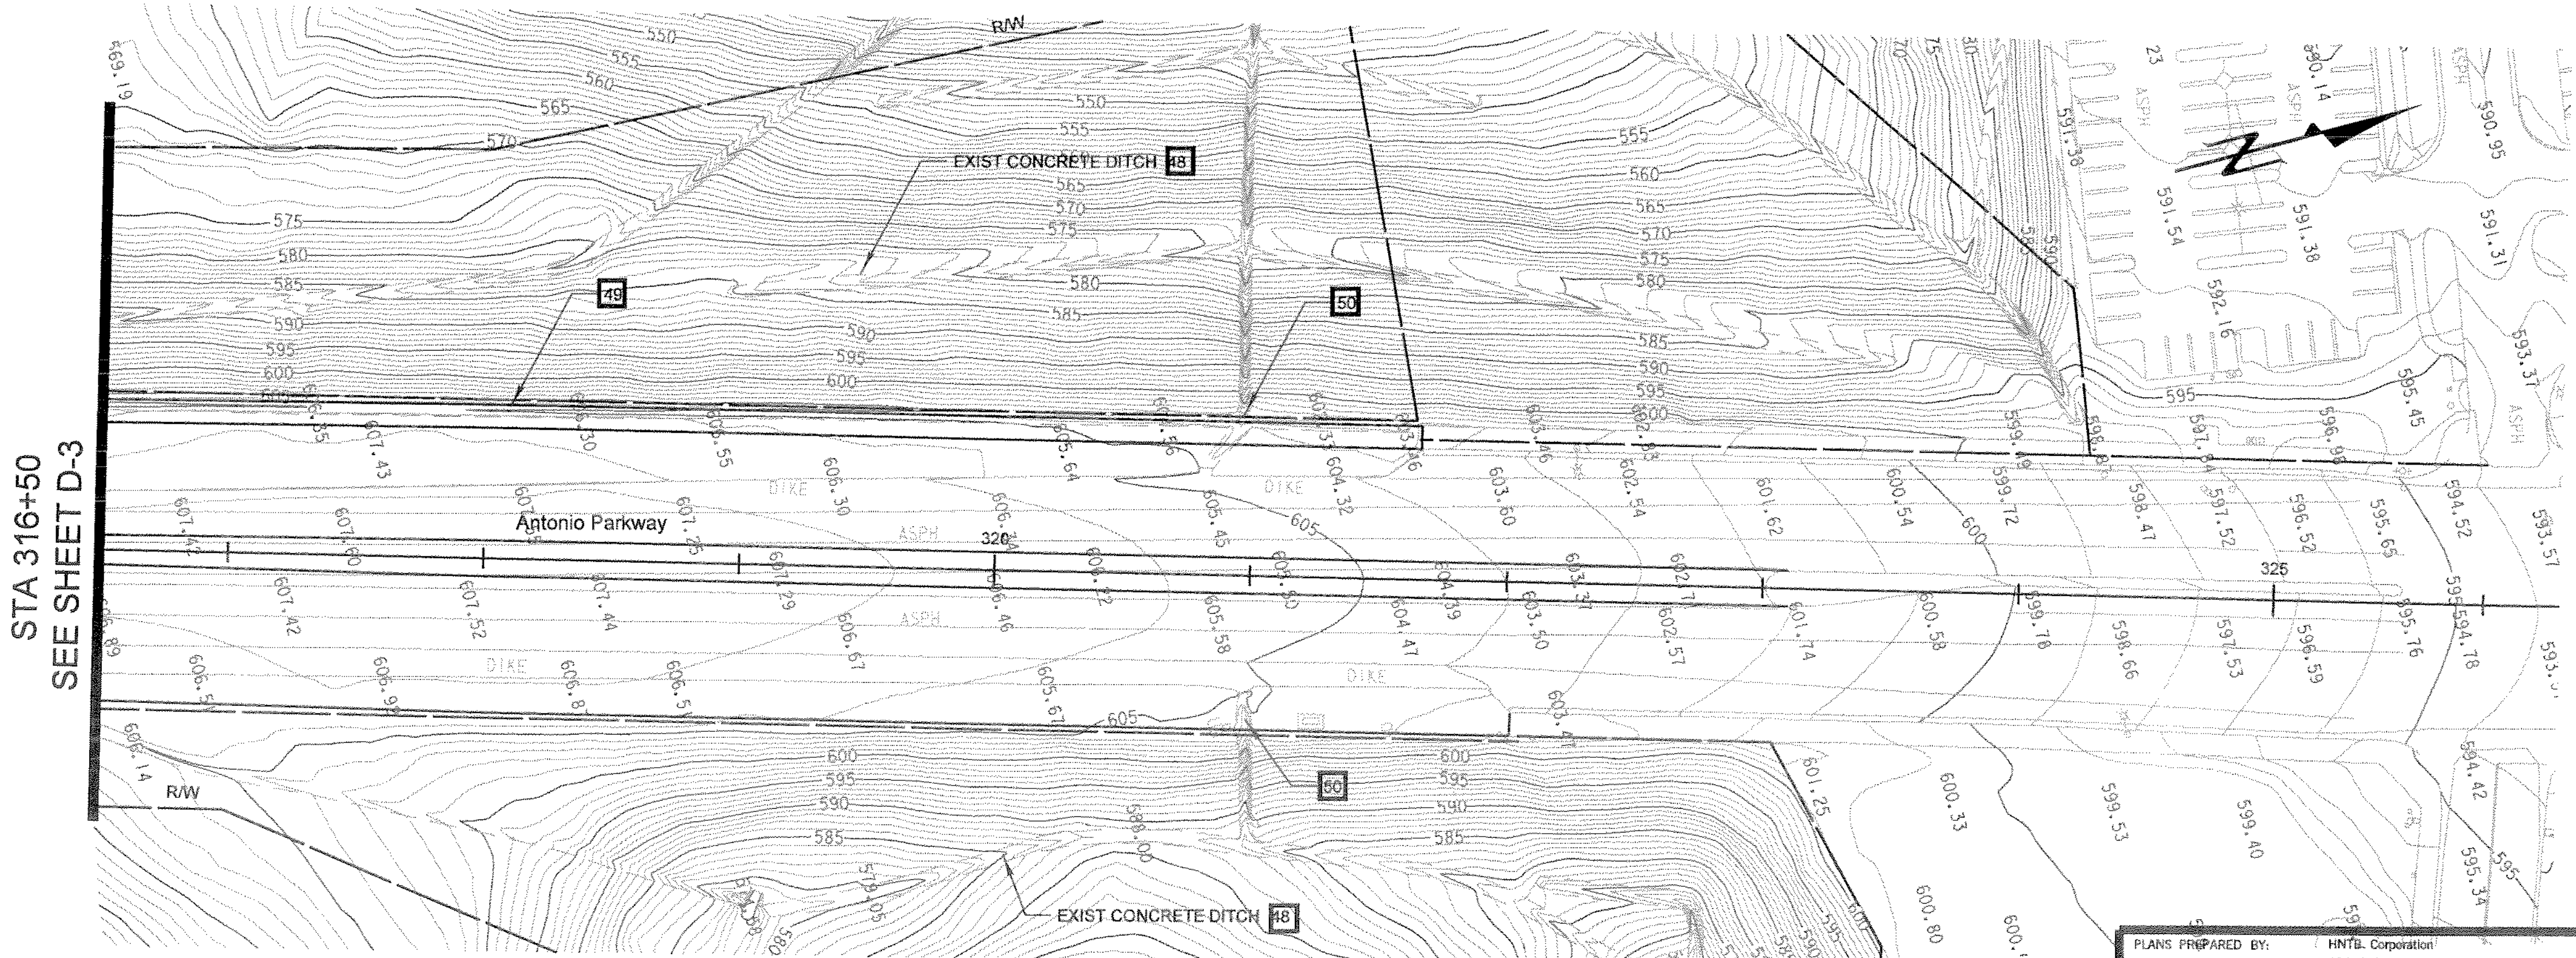

PLAN 1" = 40'		ORANGE COUNTY RESOURCES & DEVELOPMENT MANAGEMENT DEPT	
ANTONIO PARKWAY WILDLIFE IMPROVEMENT PLANS STA 316+50 TO 321+65 DRAINAGE PLAN D-4		SHEET 14 OF 72	
DESIGNED: J. NIEBE		CHECKED: S. STRON	
DRAWN: N. BUDA		DATE: 11/18/09	
SCALE: AS SHOWN		DRAWING NO. 100	
DATE: 11/18/09		FILE NAME: SDGN-FILE-NAMES	

PLANS PREPARED BY:
HNTB
HNTB Corporation
200 E. SANDPOINT AVENUE, SUITE 200
SANTA ANA, CALIFORNIA 92707
TEL (714) 460-1600 FAX (714) 460-1610

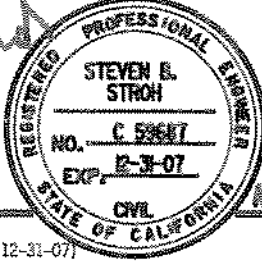

Date Plotted: dd-mmm-yyyy hh:mm