


CONSTRUCTION NOTES:

- [61] INSTALL 2" CONDUIT AND NO.6 PULLBOXES TO OSO PKWY, WITH 300' MAX SPACING BETWEEN PULLBOXES.
- [62] ABANDON EXISTING LOOP, INSTALL NEW DETECTORS AS SHOWN
- [63] INSTALL ADDITIONAL ADVANCE LOOP AND CONNECT TO EXISTING DLC SPLICE AT PB
- [64] INSTALL 12 PR #22 IC IN 2" CONDUIT. PULL CABLE INTO EXIST CONTROLLER CABINET AT OSO PKWY. APPROXIMATE DISTANCE IS 3400' BETWEEN CONTROLLERS
- [65] RELOCATE EXISTING FLASHING BEACON
- [66] EXIST CONTROLLER CABINET. PROVIDE AND INSTALL DETECTOR UNITS AS REQUIRED FOR NEW DETECTION ZONES. MODIFY CABINET AS REQUIRED FOR NEW DETECTOR OPERATIONS.
- [67] PROTECT IN PLACE ALL EXISTING LOOPS

GENERAL NOTES:

1. SEE LEGEND & ABBREVIATION ON ES-1A CALTRANS STD PLAN, 1992.
2. WORK SHALL COMFORM TO CALTRANS STD PLAN & SPECIFICATION.
3. REFER TO ASBUILT (DATED 2/10/99) FOR SIGNAL PHASE AND CONDUCTOR SCHEDULE.
4. PROTECT EXISTING SIGNAL DEVICES IN PLACE.
5. INSTALL CABLE IN 2" CONDUIT PROVIDED IN NEW BRIDGE SIDEWALK

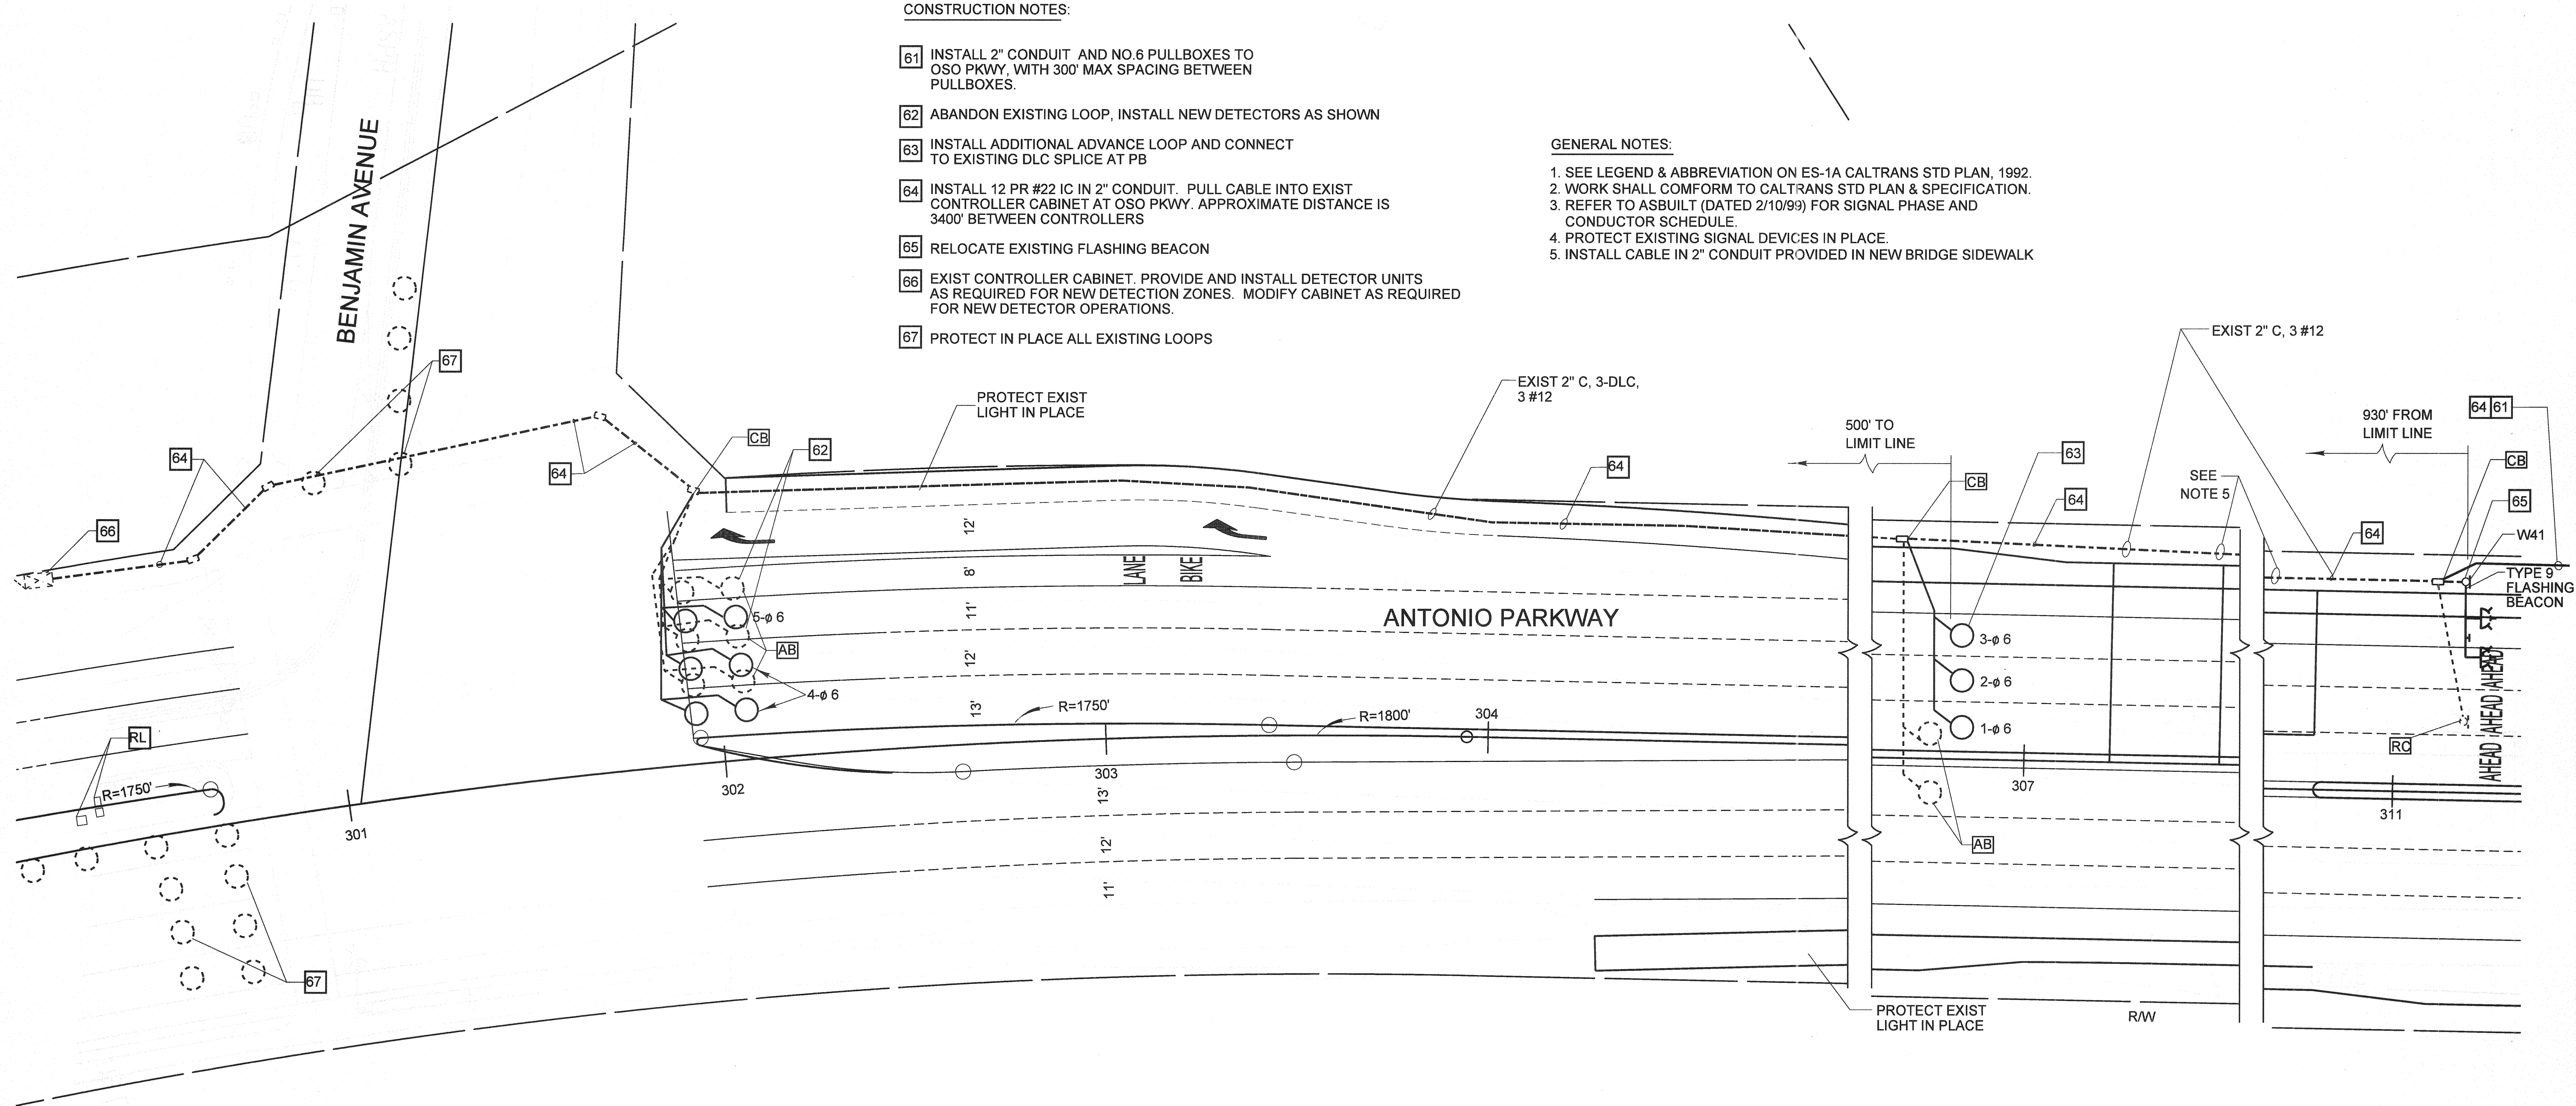

SEE SHEET 21S FOR STREET LIGHTING & TRAFFIC SIGNAL, FLASHING BEACON SYSTEM AND INTERCONNECT SYSTEM INSTALLATIONS.

AS BUILT

CORRECTION BY: MN
 CONTRACT NO.: ER28121
 DATE: 12/30/2009

PLANS PREPARED BY: **HNTB**
 HNTB Corporation
 200 E. SANDPOINTE AVENUE, SUITE 200
 SANTA ANA, CALIFORNIA 92707
 TEL (714) 460-1600 FAX (714) 460-1610

PLAN 1" = 20'		ORANGE COUNTY RESOURCES & DEVELOPMENT MANAGEMENT DEPT	
		ANTONIO PARKWAY WILDLIFE IMPROVEMENTS PLANS	
		TRAFFIC SIGNAL MODIFICATION PLAN	
DESIGNED: R. NIERE	DRAWN: N. RUMIA	CHECKED: S. STROH	SHEET 21 OF 72
DATE: 11/18/05	SCALE: AS SHOWN	DRAWING NO.: XXX	

MARK	DATE	DESCRIPTION
REVISIONS		
PREPARED UNDER RESPONSIBLE CHARGE OF:		
STEVEN B. STROH CIVIL STATE OF CALIFORNIA RCE C 59687 (EXP. 12-31-07)		

Date Plotted: 27 October, 2008 01:44

File Name: J:\34082\CADD\Hwy\Sheets\Traffic\mod.dgn
 Pen Table Used: \\nw00\cadd\lib\mstr\workspace\agency\orange\colpi

Border sheet last modified 09-Nov-1999