
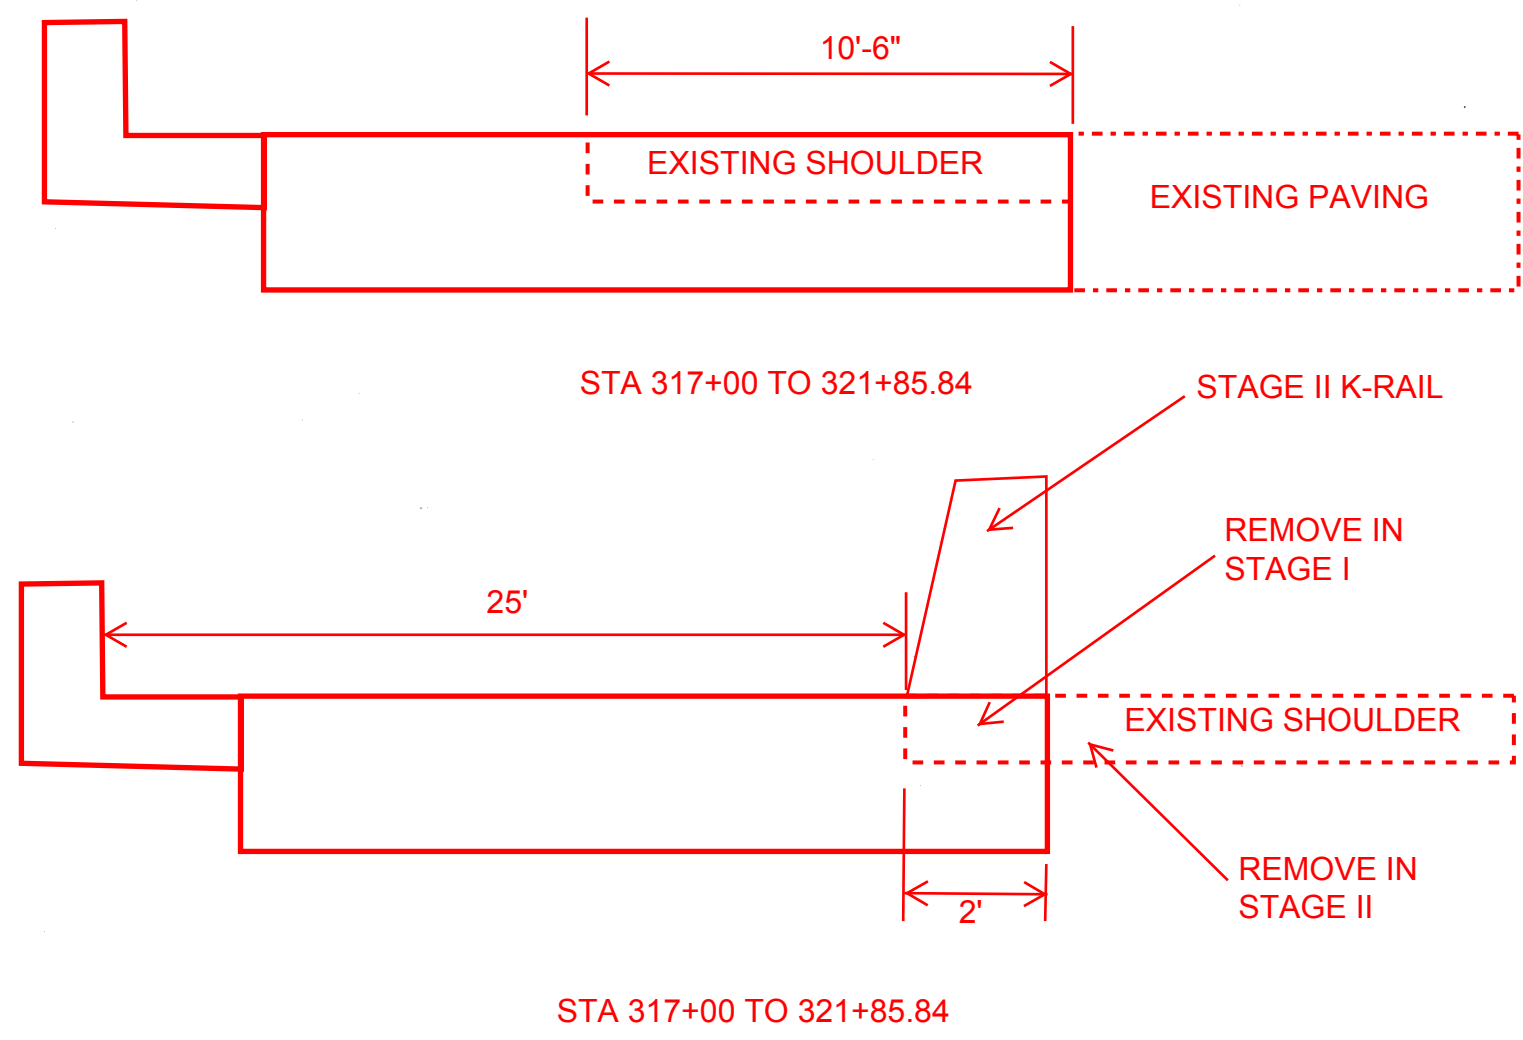


CONSTRUCTION STAGES

- PHASE 1 - CONSTRUCT SOUTHBOUND BRIDGE AND ROADWAY WIDENING
- PHASE 2 - CONSTRUCT MEDIAN NORTH OF BENJAMIN DRIVE AND NORTHBOUND SIDEWALK AND ROADWAY
- PHASE 3 - CONSTRUCT MEDIAN SOUTH OF BENJAMIN DRIVE, NORTHBOUND PAVEMENT, CURB, GUTTER, SIDEWALK AND CONCRETE BARRIER.

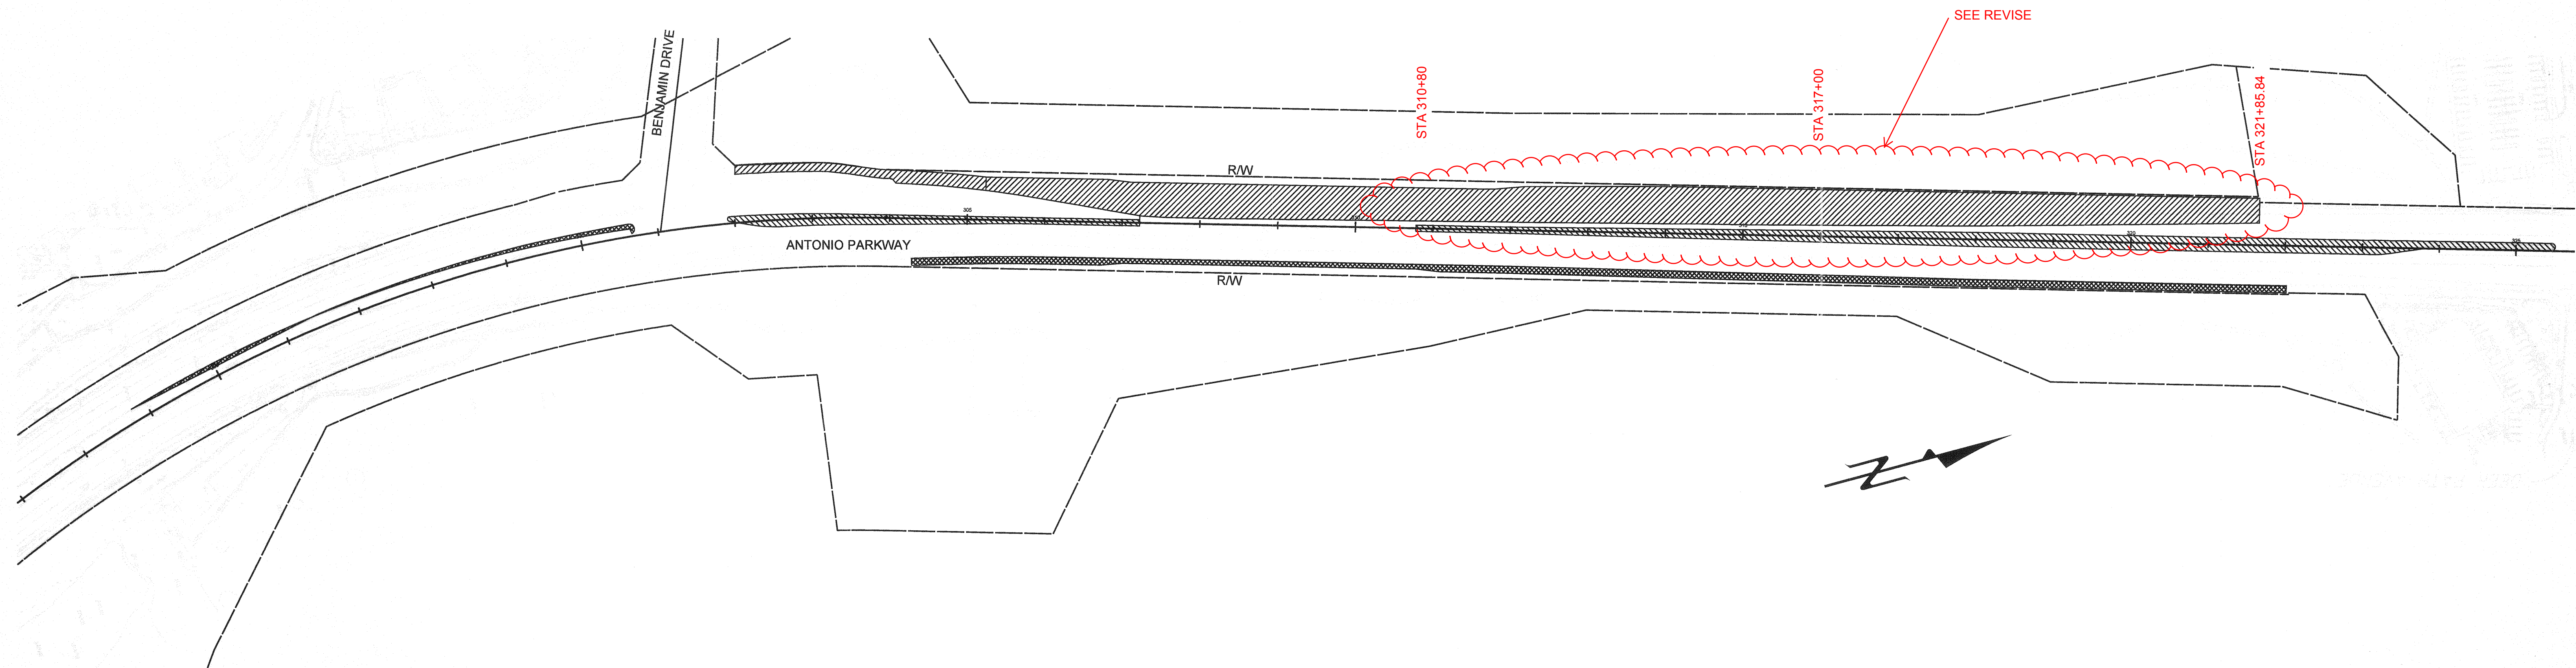

AS BUILT
CORRECTION BY: MN
CONTRACT NO.: ER28121
DATE: 12/30/2009

PLANS PREPARED BY: **HNTB**
HNTB Corporation
200 E. SANDPOINTE AVENUE, SUITE 200
SANTA ANA, CALIFORNIA 92707
TEL (714) 460-1600 FAX (714) 460-1610

ORANGE COUNTY RESOURCES & DEVELOPMENT MANAGEMENT DEPT	
ANTONIO PARKWAY WILDLIFE IMPROVEMENT PLANS	
STAGE CONSTRUCTION INDEX	
DESIGNED <u>R. NIERE</u>	SHEET 22 OF 72
DRAWN <u>N. BUNIA</u>	CHECKED <u>S. STROH</u>
SCALE AS SHOWN	DATE 11/19/05
DRAWING NO. xxx	

MARK	DATE	DESCRIPTION
REVISIONS		
PREPARED UNDER RESPONSIBLE CHARGE OF:		
STEVEN B. STROH RCE C 59687 (EXP. 12-31-07)		