


TYPICAL SECTION - PHASE I

1"= 5'


NOTE:

FOR PLACEMENT OF CLOSURE POUR, SEE SHEET 58 "TYPICAL SECTION".

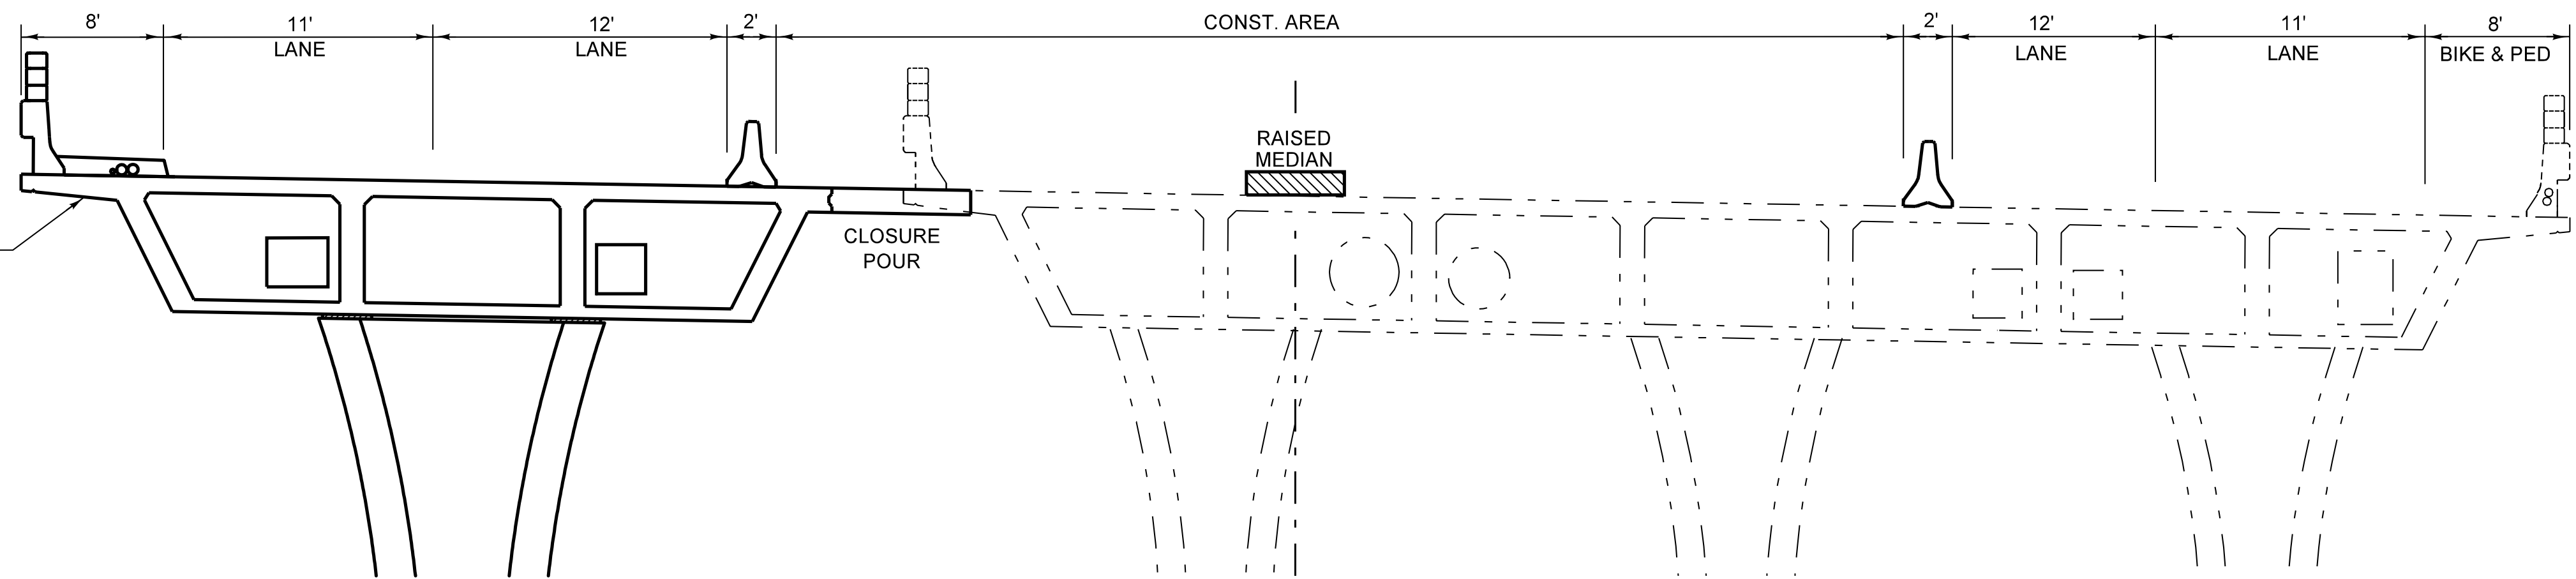

TYPICAL SECTION - PHASE II

1"= 5'

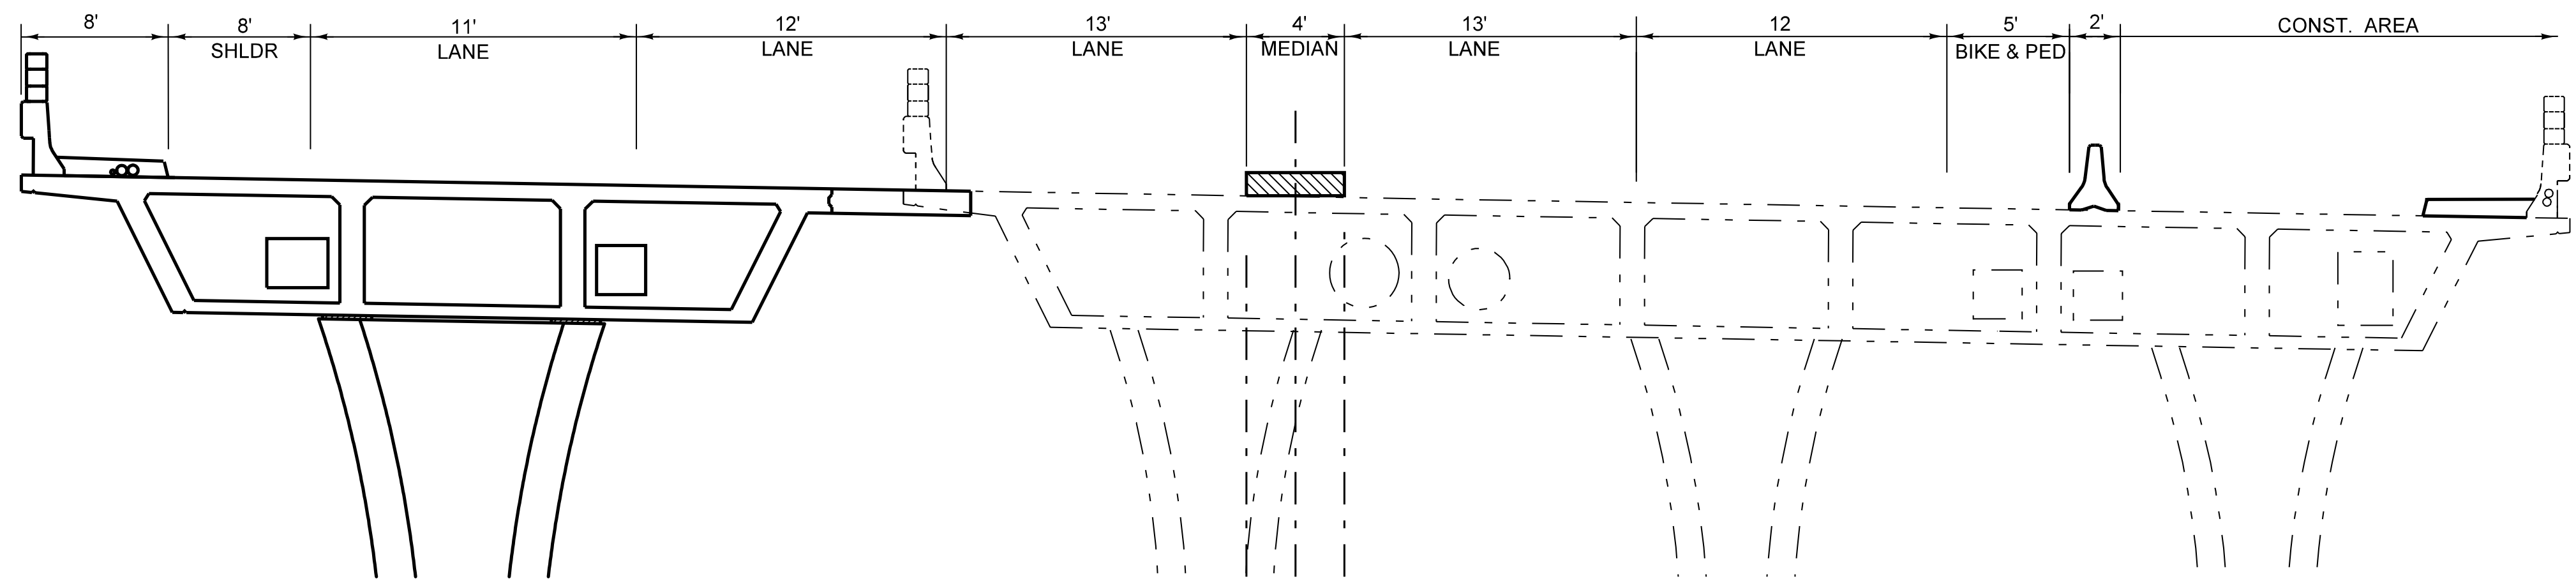

TYPICAL SECTION - PHASE III

1"= 5'

THIS SHEET REPLACES SHEET 23 OF 72 OF THE CONTRACT PLANS

AS BUILT

CORRECTION BY: MN
CONTRACT NO.: ER28121
DATE: 12/30/2009

PLANS PREPARED BY: HNTB Corporation
200 E. SANDPOINTE AVENUE, SUITE 200
SANTA ANA, CALIFORNIA 92707
TEL (714) 460-1600 FAX (714) 460-1610

HNTB

PLAN
1"= 5'

REVISIONS

PREPARED UNDER RESPONSIBLE CHARGE OF:



ORANGE COUNTY
RESOURCES & DEVELOPMENT MANAGEMENT DEPT

ANTONIO PARKWAY
WILDLIFE
IMPROVEMENT PLANS

STAGE CONSTRUCTION
TRAFFIC CONTROL PLAN
SECTIONS
SC-1

DESIGNED: R. NIERRE
DRAWN: N. BUNIA CHECKED: S. STROTH
SCALE: AS SHOWN DATE: 11/18/05 DRAWING NO.: NOV 18, 2005

SHEET
23R
OF 72