


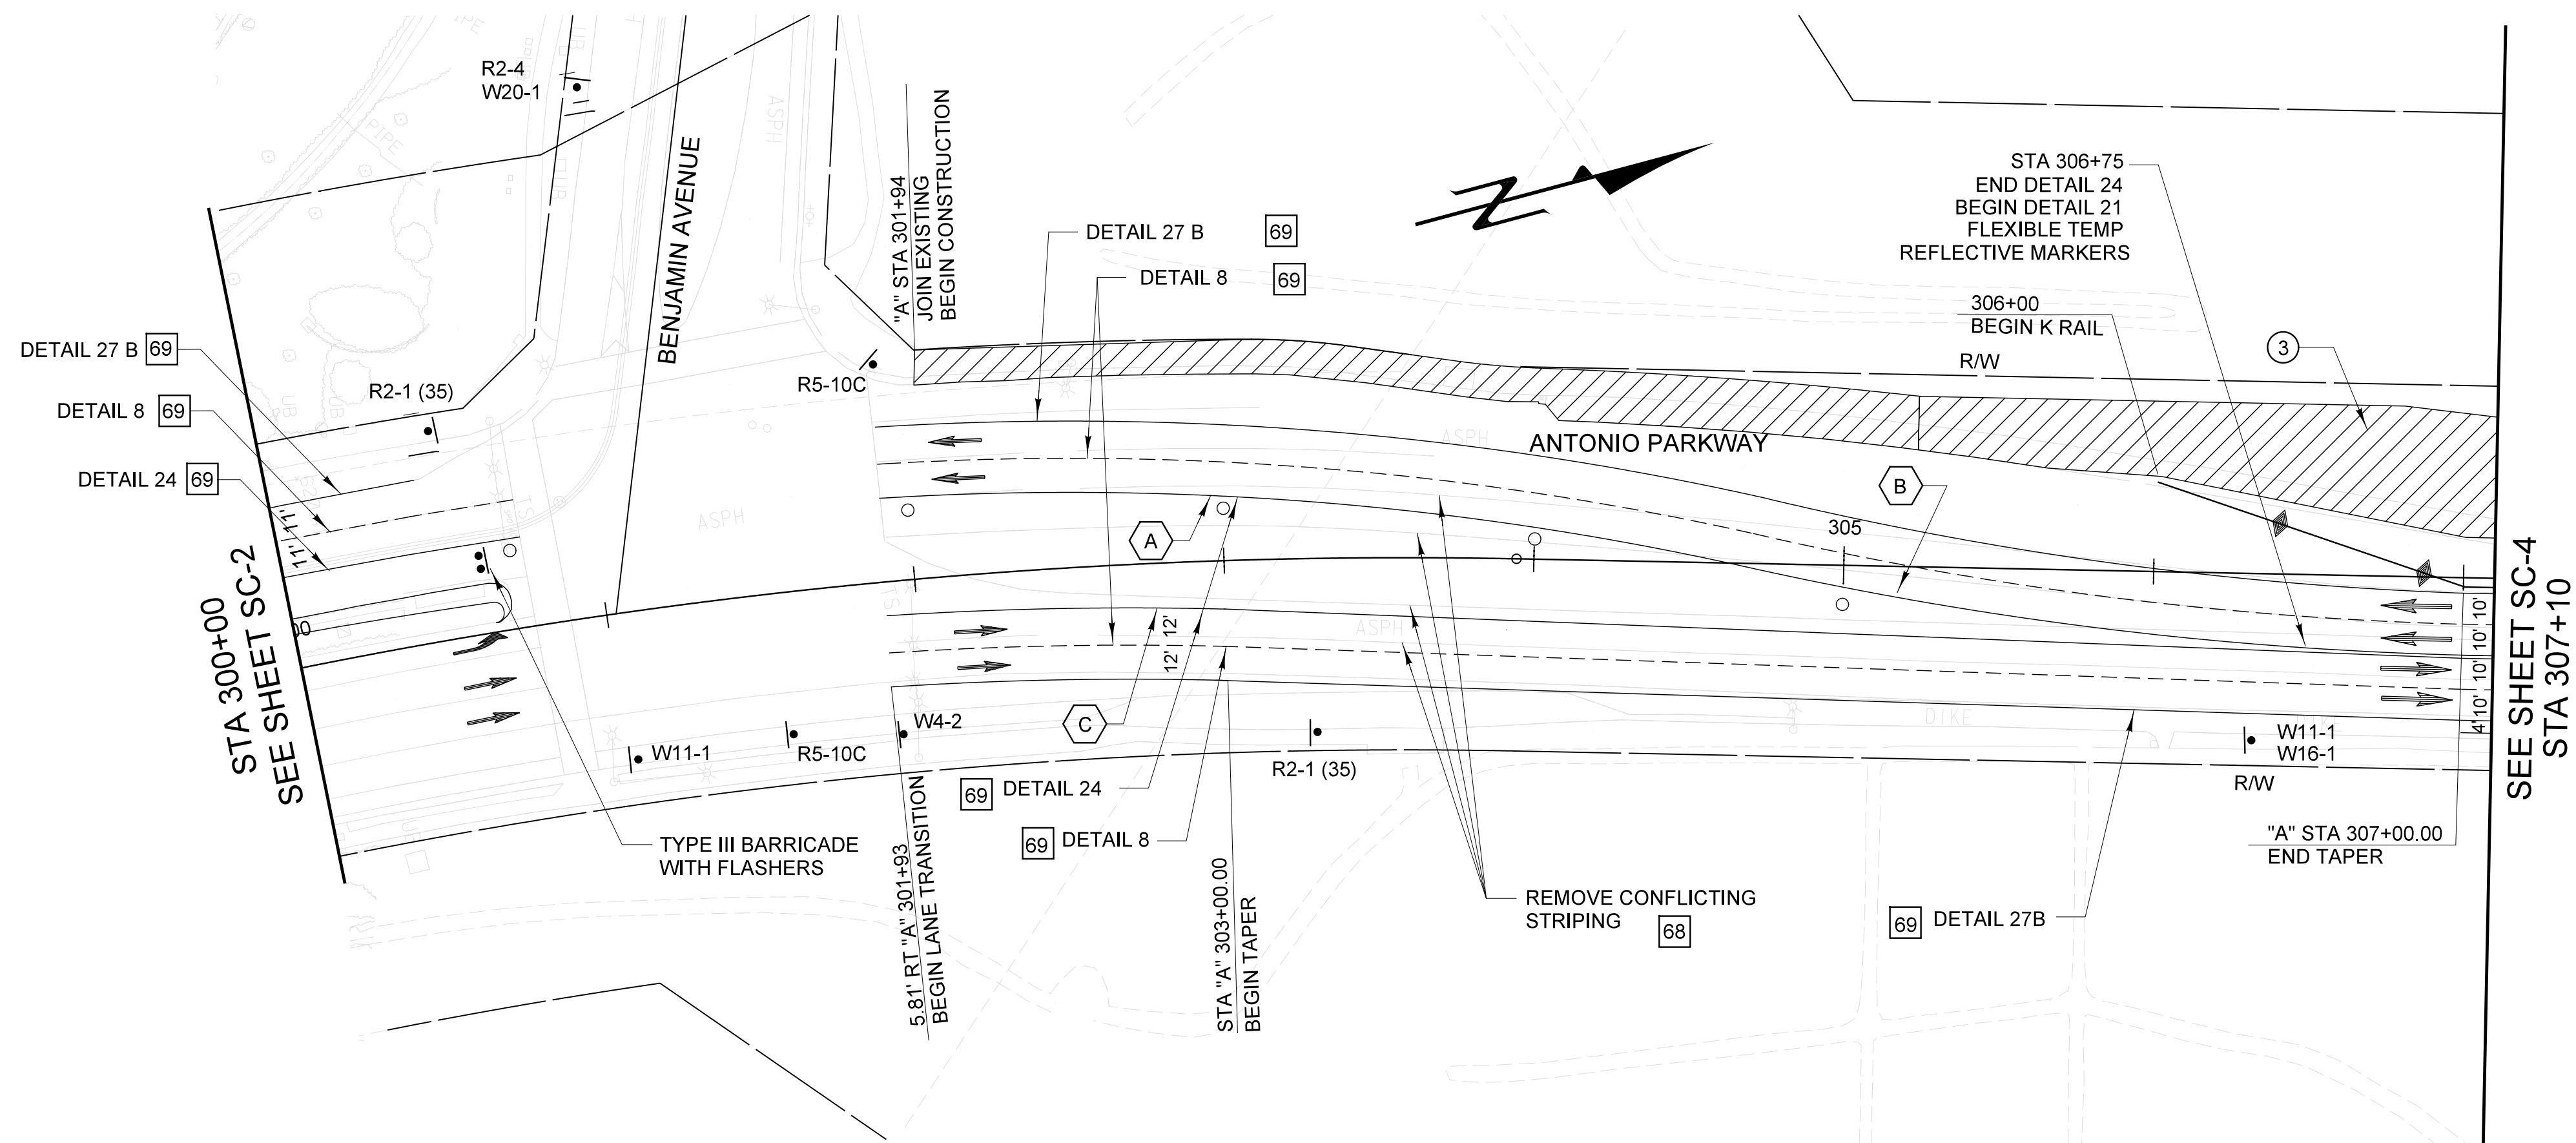

PHASE 1 – ANTONIO PKWY

- 1 CONSTRUCT SIDEWALK AND ROADWAY
301+94 TO 307+51
- 2 CONSTRUCT BRIDGE
- 3 CONSTRUCT ROADWAY 310+50 TO 311+65

LEGEND

- ← VEHICLE TRAVEL
- ▨ PHASE 1 CONSTRUCTION
- DELINEATORS AT 100' O.C.
- ◆ K RAIL

CURVE DATA

- A $\Delta = 15^\circ 58' 46''$
R = 1000.00'
L = 278.89'
T = 140.36'
- B $\Delta = 11^\circ 26' 50''$
R = 1200.00'
L = 239.75'
T = 120.28'
- C $\Delta = 05^\circ 07' 31''$
R = 1221.93'
L = 109.30'
T = 54.69'

CONSTRUCTION NOTES

- 68 SANDBLAST CONFLICTING STRIPING
- 69 PAINT

THIS SHEET REPLACES SHEET 24 OF 72 OF THE
CONTRACT PLANS

AS BUILT

CORRECTION BY: MN
CONTRACT NO.: ER28121
DATE: 12/30/2009

PLANS PREPARED BY:
HNTB
HNTB Corporation
200 E. SANDPOINTE AVENUE, SUITE 200
SANTA ANA, CALIFORNIA 92707
TEL (714) 460-1600 FAX (714) 460-1610

PLAN
1" = 40'

MARK DATE DESCRIPTION
REVISIONS

PREPARED UNDER RESPONSIBLE CHARGE OF:

STEVEN B. STROH
NO. C 59687
EXP. 12-31-07
REGISTERED PROFESSIONAL ENGINEER
STATE OF CALIFORNIA
CIVIL
STEVEN B. STROH
RCE C 59687 (EXP. 12-31-07)

ORANGE COUNTY
RESOURCES & DEVELOPMENT MANAGEMENT DEPT

ANTONIO PARKWAY
WILDLIFE
IMPROVEMENT PLANS

STAGE CONSTRUCTION
TRAFFIC CONTROL PLAN
PHASE I
SC-3

DESIGNED R. NIERE

DRAWN N. BUNIA CHECKED S. STROH

SCALE DATE DRAWING NO.
AS SHOWN 11/18/05 xxx

SHEET
25
OF 72

Date Plotted: 29 May 2007 04:09

File Name: \\irvw00\jobs\34092\CADD\Hwy\Sheets\SC2.dgn

Border sheet last modified 09-Nov-1999