


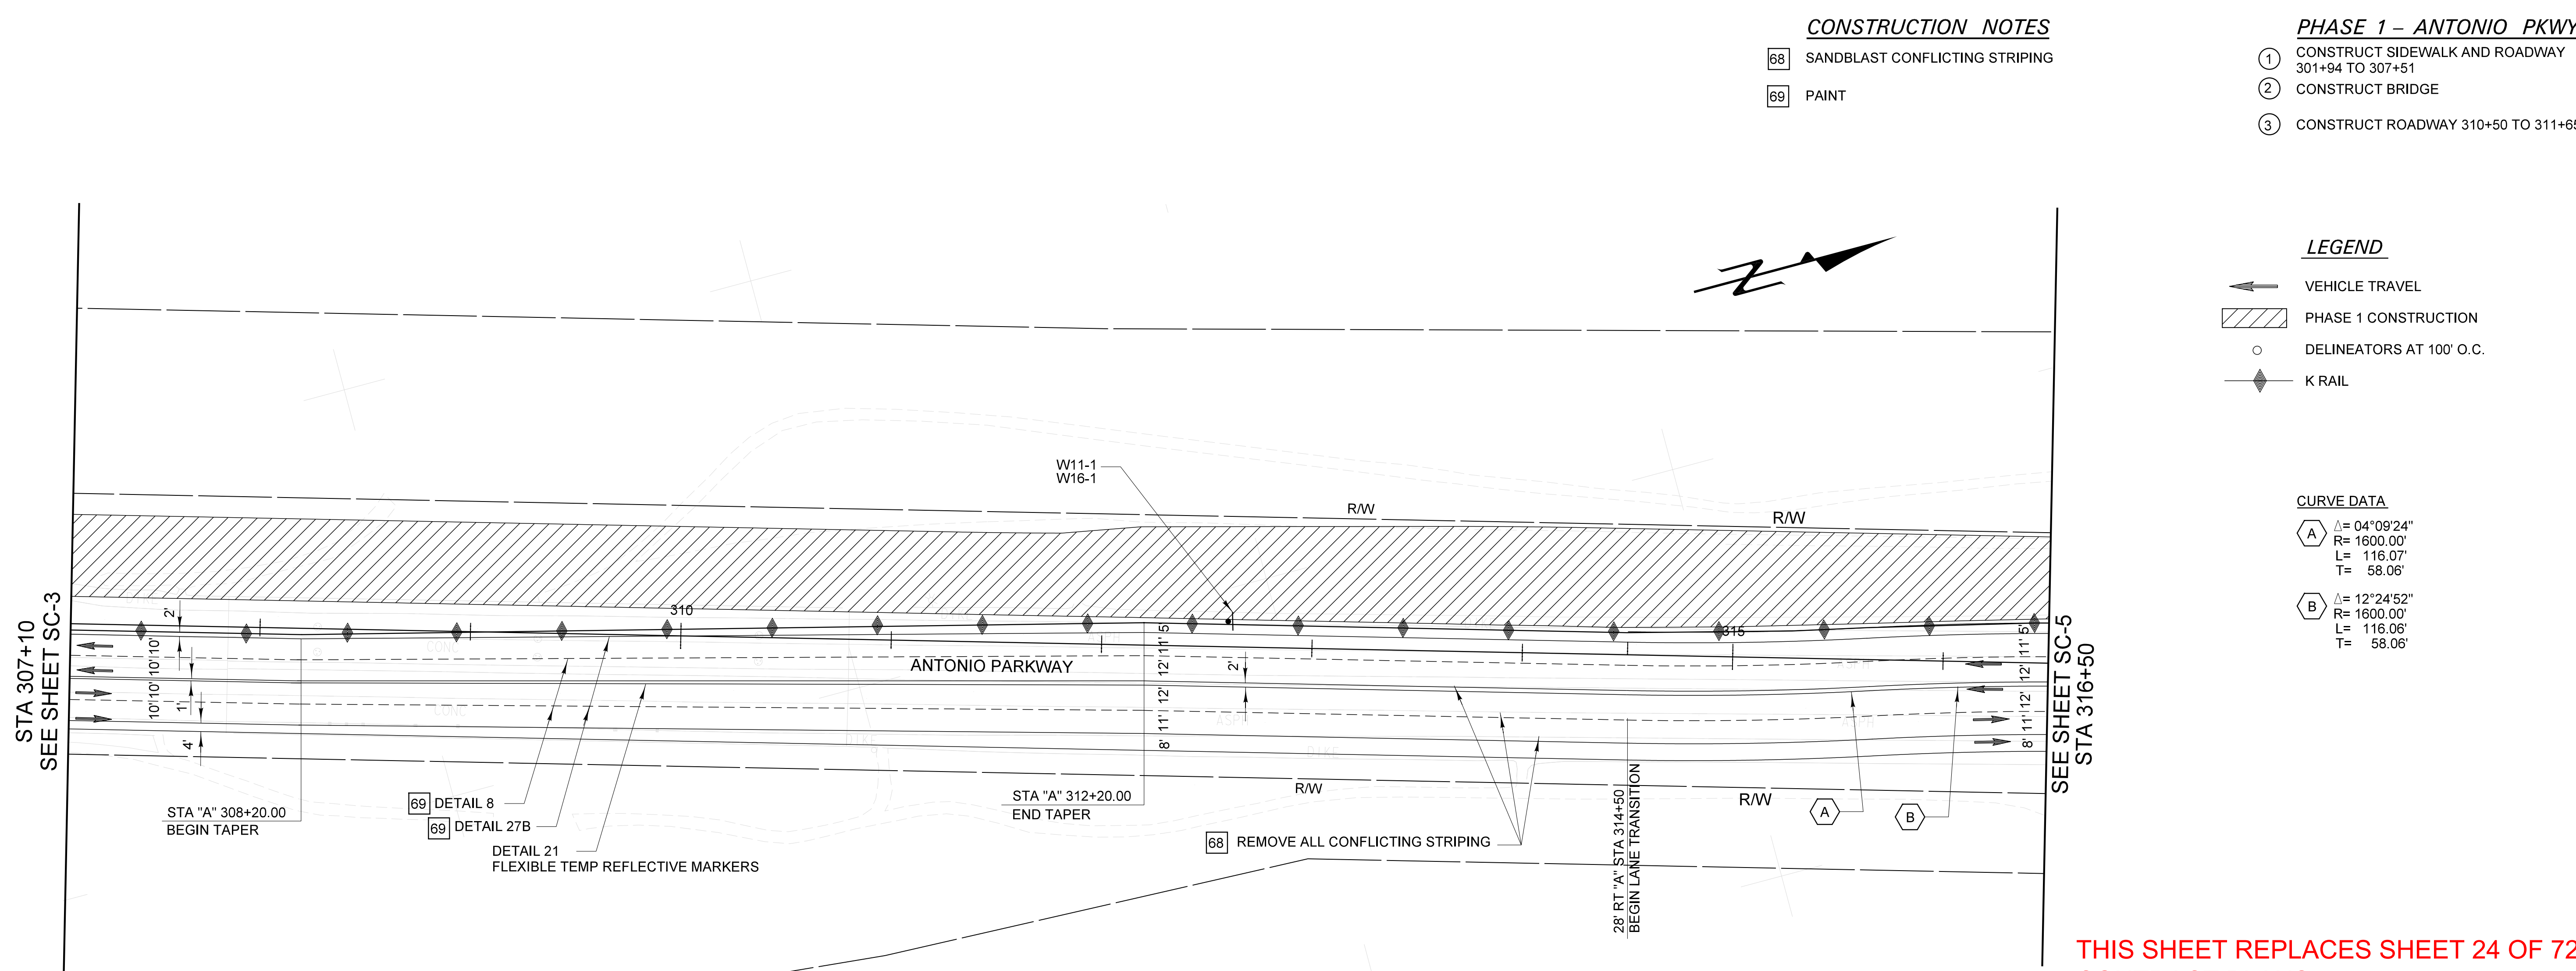

THIS SHEET REPLACES SHEET 24 OF 72 OF THE CONTRACT PLANS

AS BUILT

CORRECTION BY: MN

CONTRACT NO.: ER28121

DATE: 12/30/2009

PLANS PREPARED BY:

HNTB

HNTB Corporation
200 E. SANDPOINTE AVENUE, SUITE 200
SANTA ANA, CALIFORNIA 92707
TEL (714) 460-1600 FAX (714) 460-1610

PLAN 1" = . 40'		ORANGE COUNTY RESOURCES & DEVELOPMENT MANAGEMENT DEPT	
REVISIONS		ANTONIO PARKWAY WILDLIFE IMPROVEMENT PLANS	
		STAGE CONSTRUCTION TRAFFIC CONTROL PLAN PHASE I SC-4	
DESIGNED <u> R. NIERE </u>		SHEET	
DRAWN <u> N. BUNIA </u>		26R	
CHECKED <u> S. STROH </u>		OF 72	
SCALE		DRAWING NO.	
AS SHOWN		xxx	
DATE		11/18/05	
DATE		xxx	

PREPARED UNDER RESPONSIBLE CHARGE OF:

STEVEN B. STROH
RCE C 59687 (EXP. 12-31-07)

REGISTERED PROFESSIONAL ENGINEER
STATE OF CALIFORNIA
CIVIL

DATE

Border sheet last modified 06-Nov-1999