


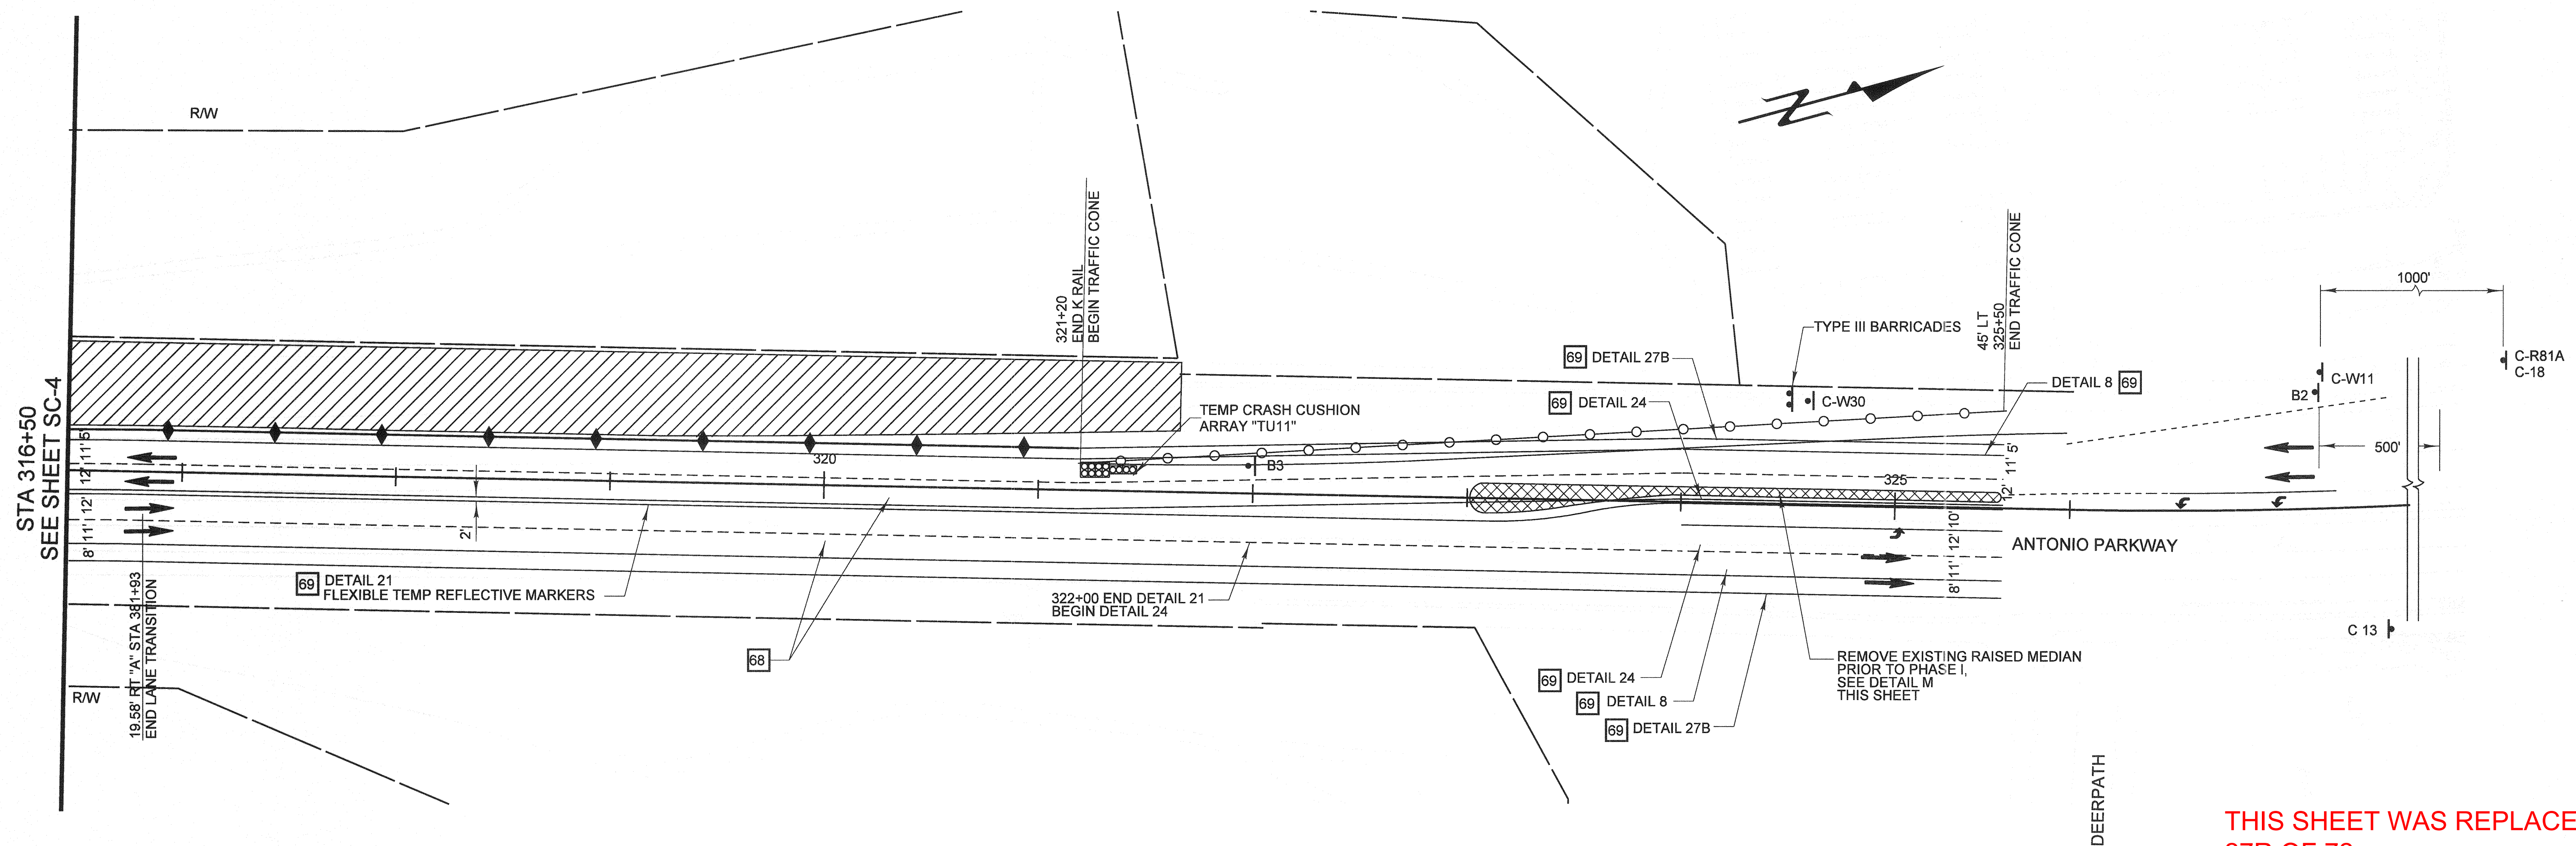

CONSTRUCTION NOTES


- 68 SANDBLAST CONFLICTING STRIPING
- 69 PAINT

PHASE I - ANTONIO PKWY

- 1 CONSTRUCT SIDEWALK AND ROADWAY 301+94 TO 307+51
- 2 CONSTRUCT BRIDGE
- 3 CONSTRUCT ROADWAY 310+50 TO 311+65

LEGEND

- ← VEHICLE TRAVEL
- ▨ PHASE 1 CONSTRUCTION
- DELINEATORS AT 100' O.C.
- ◆ K RAIL
- TRAFFIC CONE 20' SPACE
- ⚡ TYPE III BARRICADES

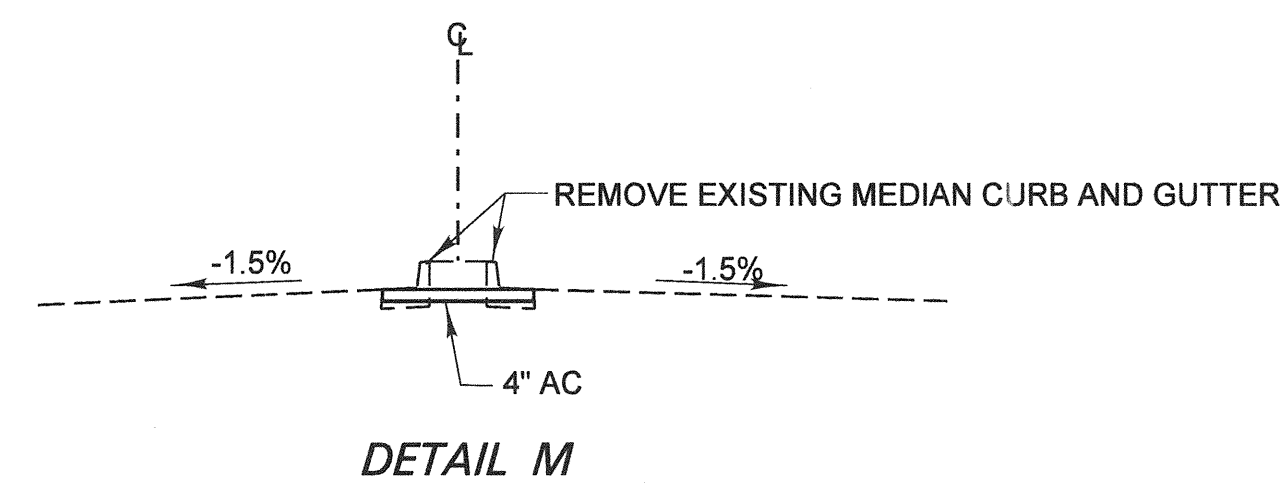

THIS SHEET WAS REPLACED BY SHEET 27R OF 72.

AS BUILT

CORRECTION BY: MN
 CONTRACT NO.: ER28121
 DATE: 12/30/2009

PLAN 1" = 40'		ORANGE COUNTY RESOURCES & DEVELOPMENT MANAGEMENT DEPT	
		ANTONIO PARKWAY WILDLIFE IMPROVEMENT PLANS	
		STAGE CONSTRUCTION TRAFFIC CONTROL PLAN PHASE I SC-5	
MARK	DATE	DESIGNED <u>R. NIERE</u>	SHEET
REVISIONS		CHECKED <u>S. STROH</u>	27
PREPARED UNDER RESPONSIBLE CHARGE OF:		SCALE <u>AS SHOWN</u>	DATE <u>11/18/05</u>
		DRAWING NO. <u>xxx</u>	OF 72
PLANS PREPARED BY: HNTB HNTB Corporation 200 E. SANDPOINTE AVENUE, SUITE 200 SANTA ANA, CALIFORNIA 92707 TEL (714) 460-1600 FAX (714) 460-1610		Date Plotted: 20 October, 2006 05:38 File Name: J:\34092\CADD\Hwy\Sheets\SC4.dgn	