


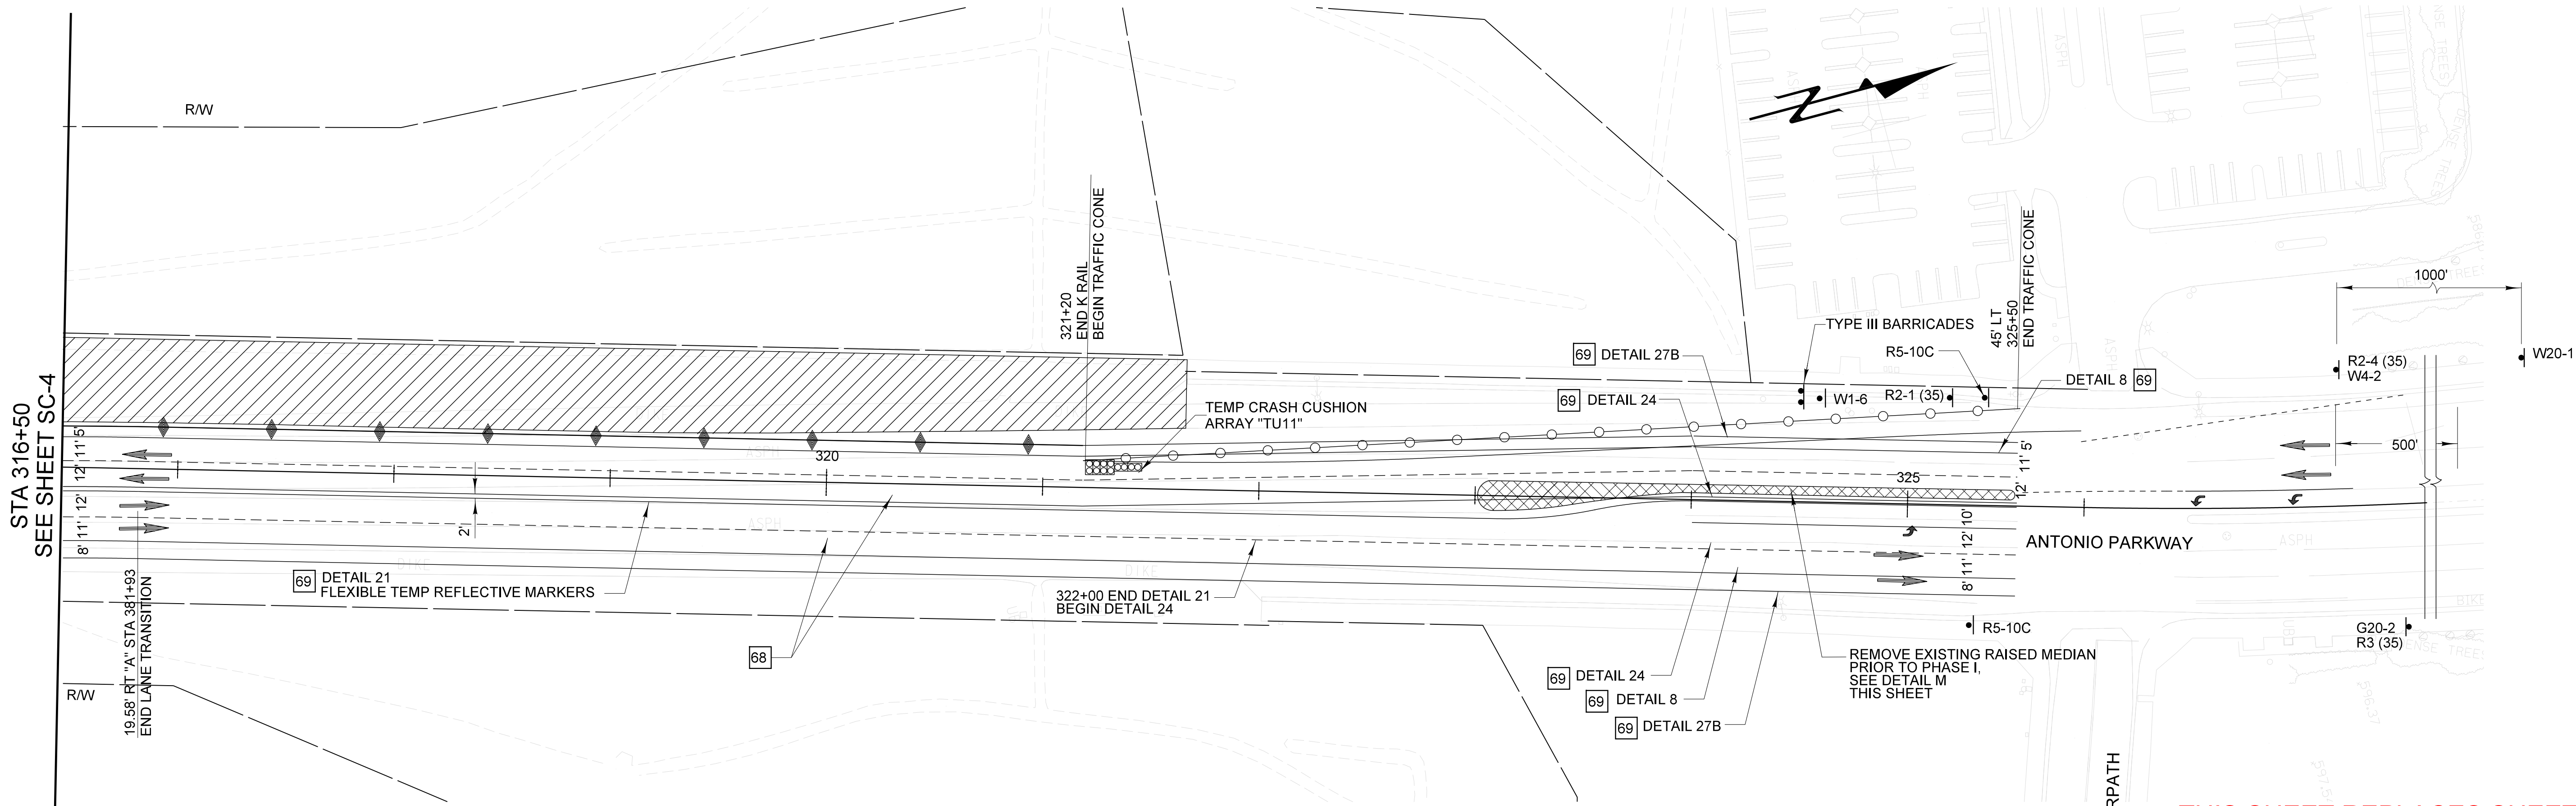


THIS SHEET REPLACES SHEET 24 OF 72 OF THE CONTRACT PLANS

- CONSTRUCTION NOTES**
- 68 SANDBLAST CONFLICTING STRIPING
 - 69 PAINT

- PHASE I - ANTONIO PKWY**
- 1 CONSTRUCT SIDEWALK AND ROADWAY 301+94 TO 307+51
 - 2 CONSTRUCT BRIDGE
 - 3 CONSTRUCT ROADWAY 310+50 TO 311+65

- LEGEND**
- VEHICLE TRAVEL
 - PHASE 1 CONSTRUCTION
 - DELINEATORS AT 100' O.C.
 - K RAIL
 - TRAFFIC CONE 20' SPACE
 - TYPE III BARICADES

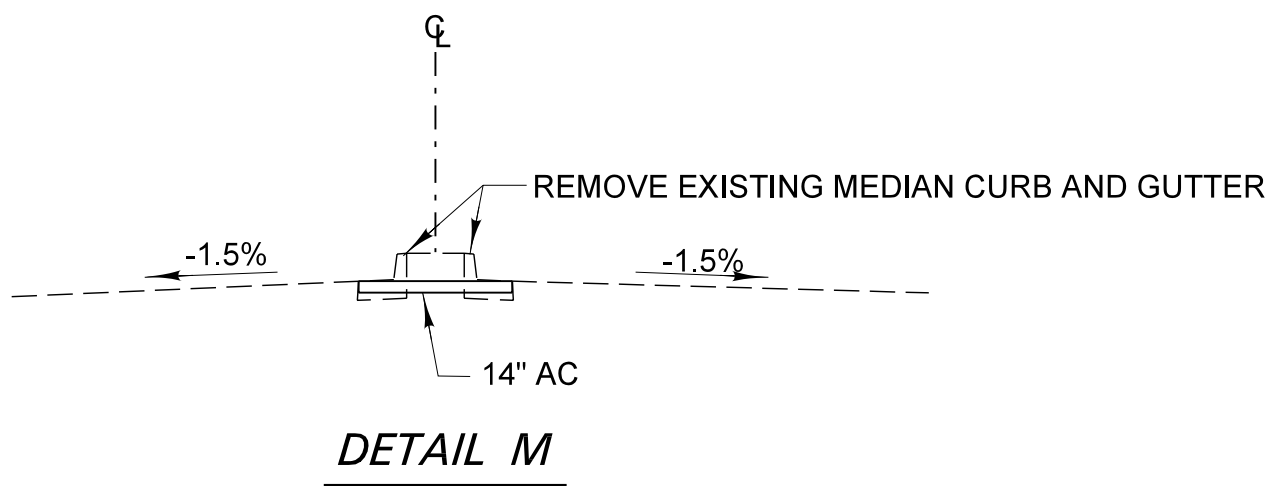

PLANS PREPARED BY:
HNTB
HNTB Corporation
200 E. SANDPOINTE AVENUE, SUITE 200
SANTA ANA, CALIFORNIA 92707
TEL (714) 460-1600 FAX (714) 460-1610

PLAN
1" = 40'

REVISIONS

MARK	DATE	DESCRIPTION
PREPARED UNDER RESPONSIBLE CHARGE OF:		
DESIGNED	R. NIERE	
DRAWN	N. BUNIA	CHECKED S. STROH
SCALE	DATE	DRAWING NO.
AS SHOWN	11/18/05	xxx

AS BUILT

CORRECTION BY: MN

CONTRACT NO.: ER28121

DATE: 12/30/2009

ORANGE COUNTY
RESOURCES & DEVELOPMENT MANAGEMENT DEPT

ANTONIO PARKWAY
WILDLIFE
IMPROVEMENT PLANS

**STAGE CONSTRUCTION
TRAFFIC CONTROL PLAN
PHASE I
SC-5**

DESIGNED R. NIERE

DRAWN N. BUNIA CHECKED S. STROH

SCALE AS SHOWN DATE 11/18/05 DRAWING NO. xxx

SHEET
27R
OF 72

Date Plotted: 29 May 2007 04:15

File Name: \\irvw00\jobs\34092\CADD\Hwy\Sheets\SC4.dgn

Border sheet last modified 06-Nov-1999