
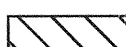

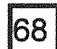
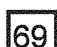


LEGEND

-  VEHICLE TRAVEL
-  PHASE 2 CONSTRUCTION
-  K RAIL

CONSTRUCTION NOTES

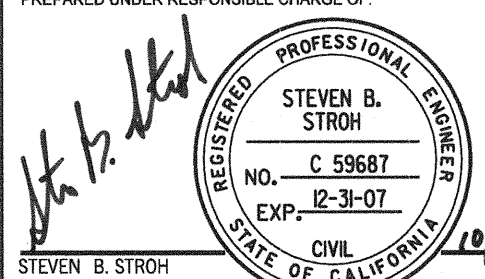
-  SANDBLAST CONFLICTING STRIPING
-  PAINT

AS BUILT

CORRECTION BY: MN
 CONTRACT NO.: ER28121
 DATE: 12/30/2009

PLANS PREPARED BY: **HNTB**
 HNTB Corporation
 200 E. SANDPOINTE AVENUE, SUITE 200
 SANTA ANA, CALIFORNIA 92707
 TEL (714) 460-1600 FAX (714) 460-1610

PLAN 1" = 40'		ORANGE COUNTY RESOURCES & DEVELOPMENT MANAGEMENT DEPT	
		ANTONIO PARKWAY WILDLIFE IMPROVEMENT PLANS	
		STAGE CONSTRUCTION TRAFFIC CONTROL PLAN PHASE II SC-8	
DESIGNED <u>R. NIERE</u>	SHEET		30 OF 72
DRAWN <u>N. BLUNA</u>	CHECKED <u>S. STROH</u>		
SCALE AS SHOWN	DATE 11/18/05	DRAWING NO. xxx	

MARK	DATE	DESCRIPTION
REVISIONS		
PREPARED UNDER RESPONSIBLE CHARGE OF:		
		
STEVEN B. STROH RCE C 59687 (EXP. 12-31-07)		