

- LEGEND**
- ← VEHICLE TRAVEL
  - ▨ STAGE 3 CONSTRUCTION
  - DELINEATORS AT 100' O.C.
  - ⊥ SIGN
  - ⋈ ARROW BOARD OR VMS AS INDICATED

**AS BUILT**

CORRECTION BY:         MN        

CONTRACT NO.:         ER28121        

DATE:         12/30/2009        


PLANS PREPARED BY: **HNTB** Corporation  
 200 E. SANDPOINTE AVENUE, SUITE 200  
 SANTA ANA, CALIFORNIA 92707  
 TEL (714) 460-1600 FAX (714) 460-1610

PLAN 1" = 40'		ORANGE COUNTY RESOURCES & DEVELOPMENT MANAGEMENT DEPT	
		ANTONIO PARKWAY WILDLIFE IMPROVEMENT PLANS	
		<b>STAGE CONSTRUCTION TRAFFIC CONTROL PLAN PHASE III SC-10</b>	
DESIGNED <u>R. NIERE</u>	CHECKED <u>S. STROH</u>	SHEET <b>32</b> OF 72	
DRAWN <u>N. BUNIA</u>	DATE <u>11/18/05</u>	DRAWING NO. <u>xxx</u>	
SCALE AS SHOWN			

PREPARED UNDER RESPONSIBLE CHARGE OF:

STEVEN B. STROH  
 RCE C 59681 (EXP. 12-31-07)



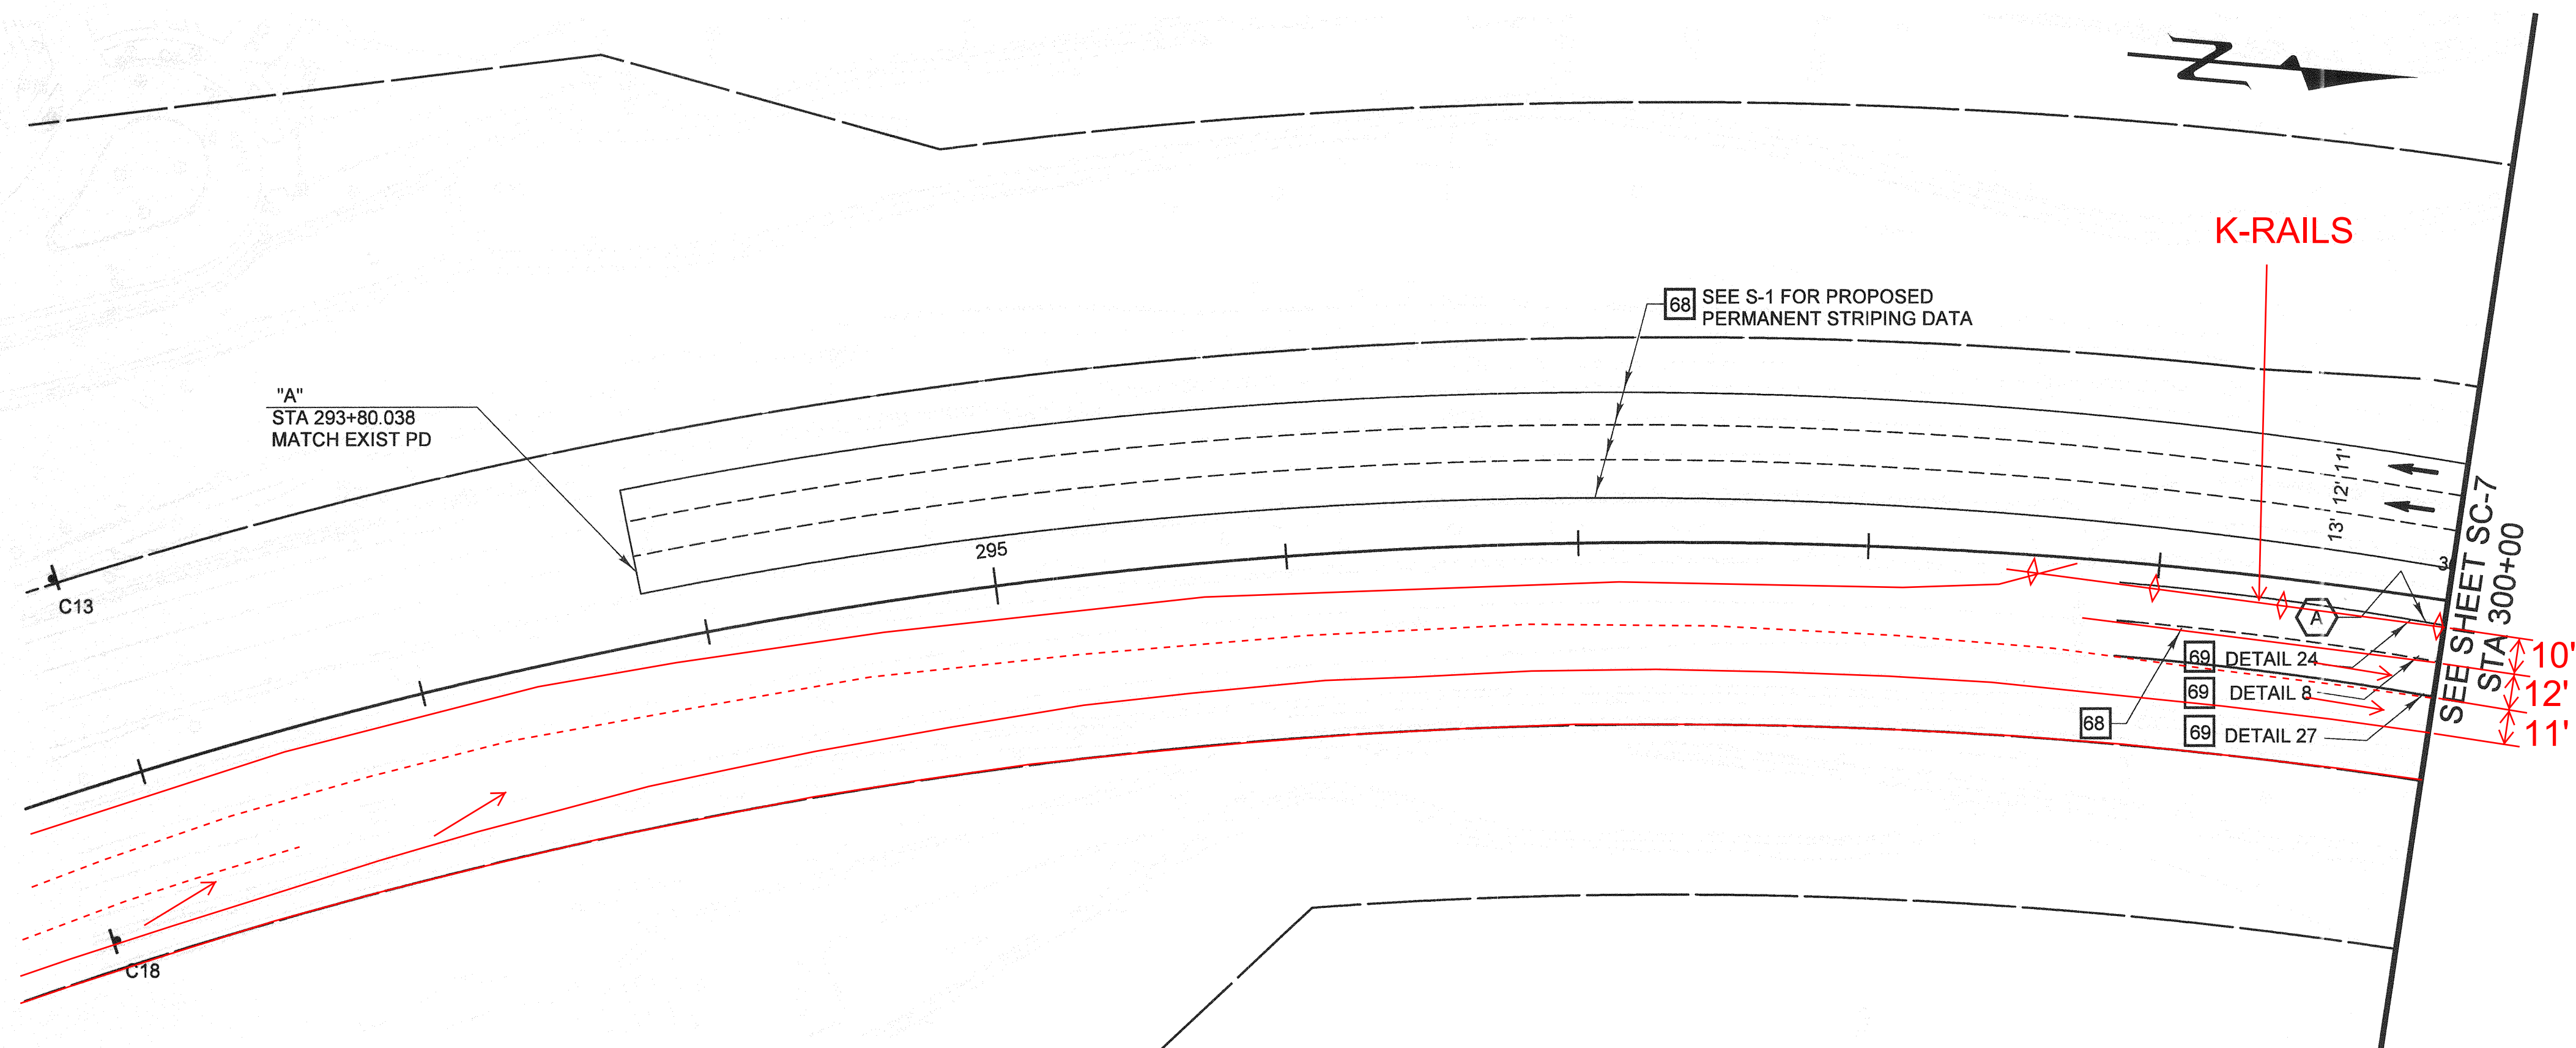

# **CONSTRUCTION NOTES**

- 68 SANDBLAST CONFLICTING STRIPING
- 69 PAINT

## **LEGEND**

- VEHICLE TRAVEL
- STAGE 1 CONSTRUCTION
- DELINEATORS AT 100' O.C.

## **CURVE DATA**

Δ = 09°22'25"  
R = 1000.00'  
L = 163.60'  
T = 81.98'

**AS BUILT**

CORRECTION BY: MN  
CONTRACT NO.: ER28121  
DATE: 12/30/2009

PLANS PREPARED BY: HNTB Corporation  
200 E. SANDPOINTE AVENUE, SUITE 200  
SANTA ANA, CALIFORNIA 92707  
TEL (714) 460-1600 FAX (714) 460-1610

PLAN 1" = 40'		ORANGE COUNTY RESOURCES & DEVELOPMENT MANAGEMENT DEPT	
		ANTONIO PARKWAY WILDLIFE IMPROVEMENT PLANS	
		STAGE CONSTRUCTION TRAFFIC CONTROL PLAN PHASE II SC-6	
MARK	DATE	DESCRIPTION	SHEET
REVISIONS			28
PREPARED UNDER RESPONSIBLE CHARGE OF:			OF 72
DESIGNED	R. NIEME	CHECKED	S. STROHM
DRAWN	N. BUNIA	DATE	11/18/05
SCALE	AS SHOWN	DRAWING NO.	xxx

Date Plotted: 20 October, 2006 05:38

File Name: J:\34092\CADD\Hwy\Sheets\SC5.dgn

Border sheet last modified 09-Nov-1999