


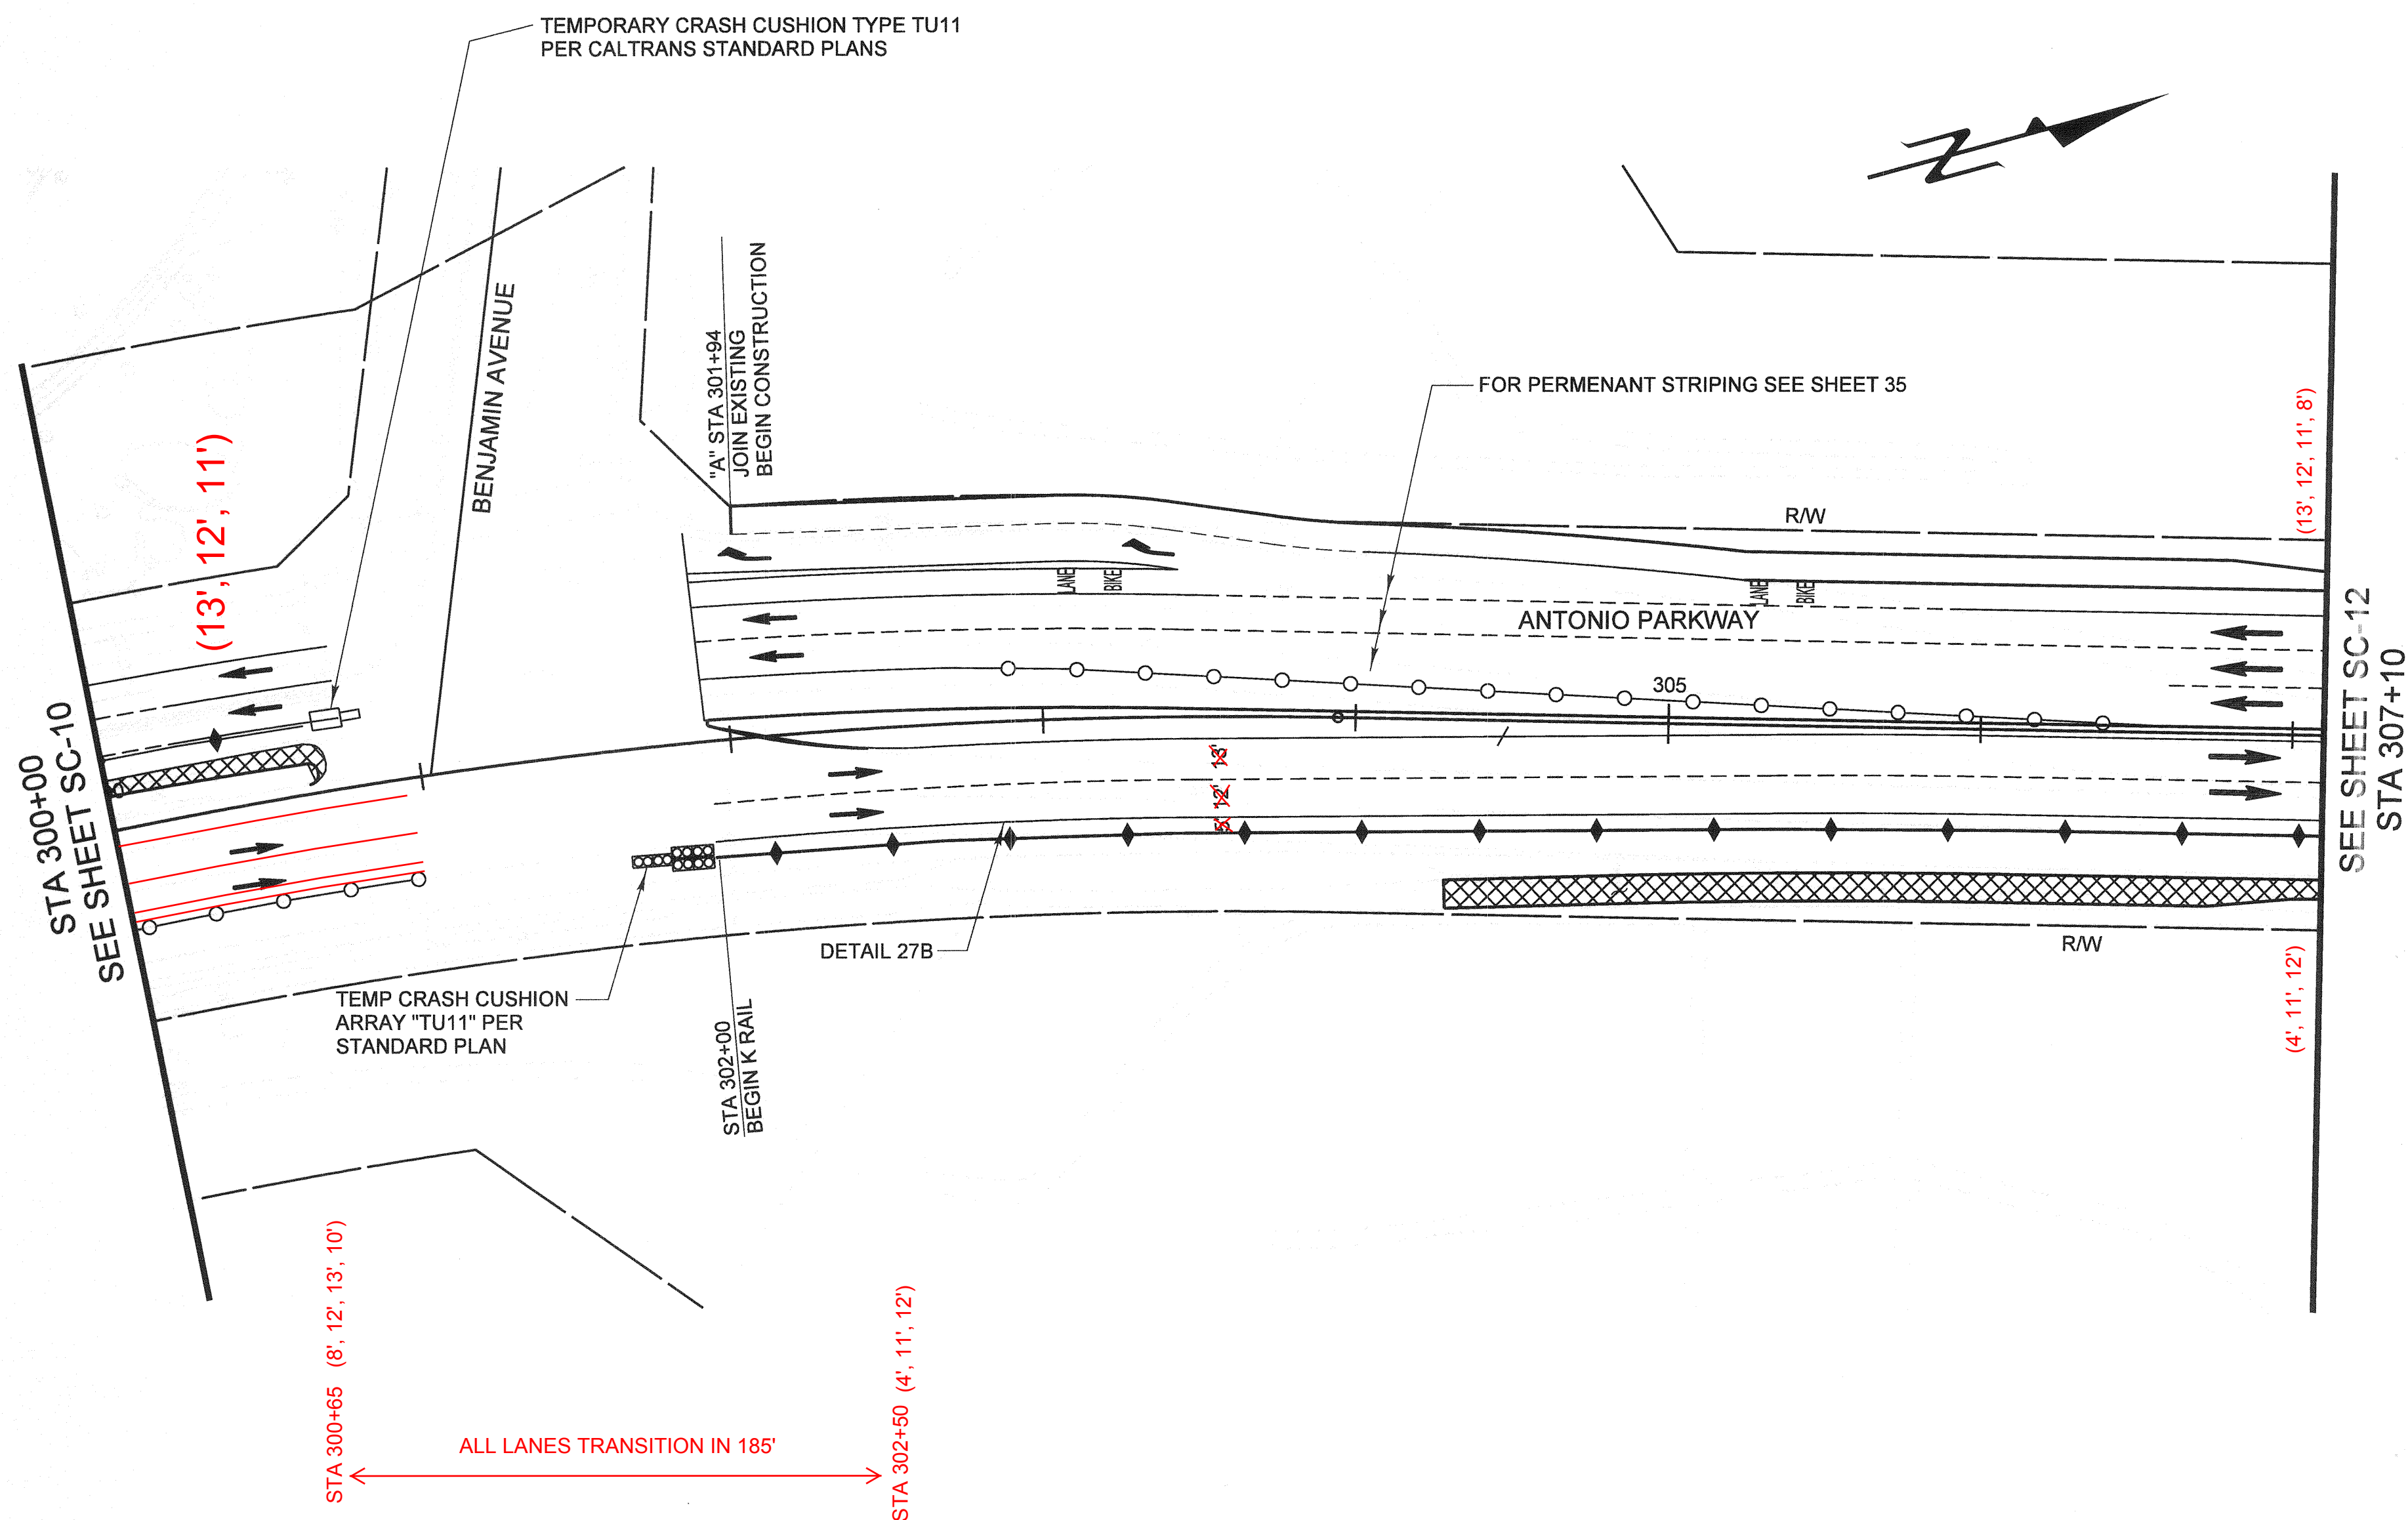

PHASE III - ANTONIO PKWY

- 1 CONSTRUCT SIDEWALK AND ROADWAY
304+29.45 TO 300+02.21

LEGEND

- ← VEHICLE TRAVEL
XXXX PHASE 3 CONSTRUCTION
○ DELINEATORS AT 100' O.C.
◆ K RAIL

CONSTRUCTION NOTES

- 61 SANDBLAST CONFLICTING STRIPING
62 PAINT

AS BUILT

CORRECTION BY: MN
CONTRACT NO.: ER28121
DATE: 12/30/2009

PLANS PREPARED BY: HNTB Corporation
200 E. SANDPOINTE AVENUE, SUITE 200
SANTA ANA, CALIFORNIA 92707
TEL (714) 460-1600 FAX (714) 460-1610

PLAN 1" = 40'		ORANGE COUNTY RESOURCES & DEVELOPMENT MANAGEMENT DEPT	
ANTONIO PARKWAY WILDLIFE IMPROVEMENT PLANS		STAGE CONSTRUCTION TRAFFIC CONTROL PLAN PHASE III SC-11	
DESIGNED: R. NIERE	DRAWN: N. BUNIA	CHECKED: S. STROH	SHEET 33 OF 72
SCALE: AS SHOWN	DATE: 11/18/05	DRAWING NO. XXX	

PREPARED UNDER RESPONSIBLE CHARGE OF:
STEVEN B. STROH
C 59687
EXP. 12-31-07
REGISTERED PROFESSIONAL ENGINEER
STATE OF CALIFORNIA

Date Plotted: 20 October, 2006 05:38

File Name: J:\34092\CADD\Hwy\Sheets\SC10.dgn