
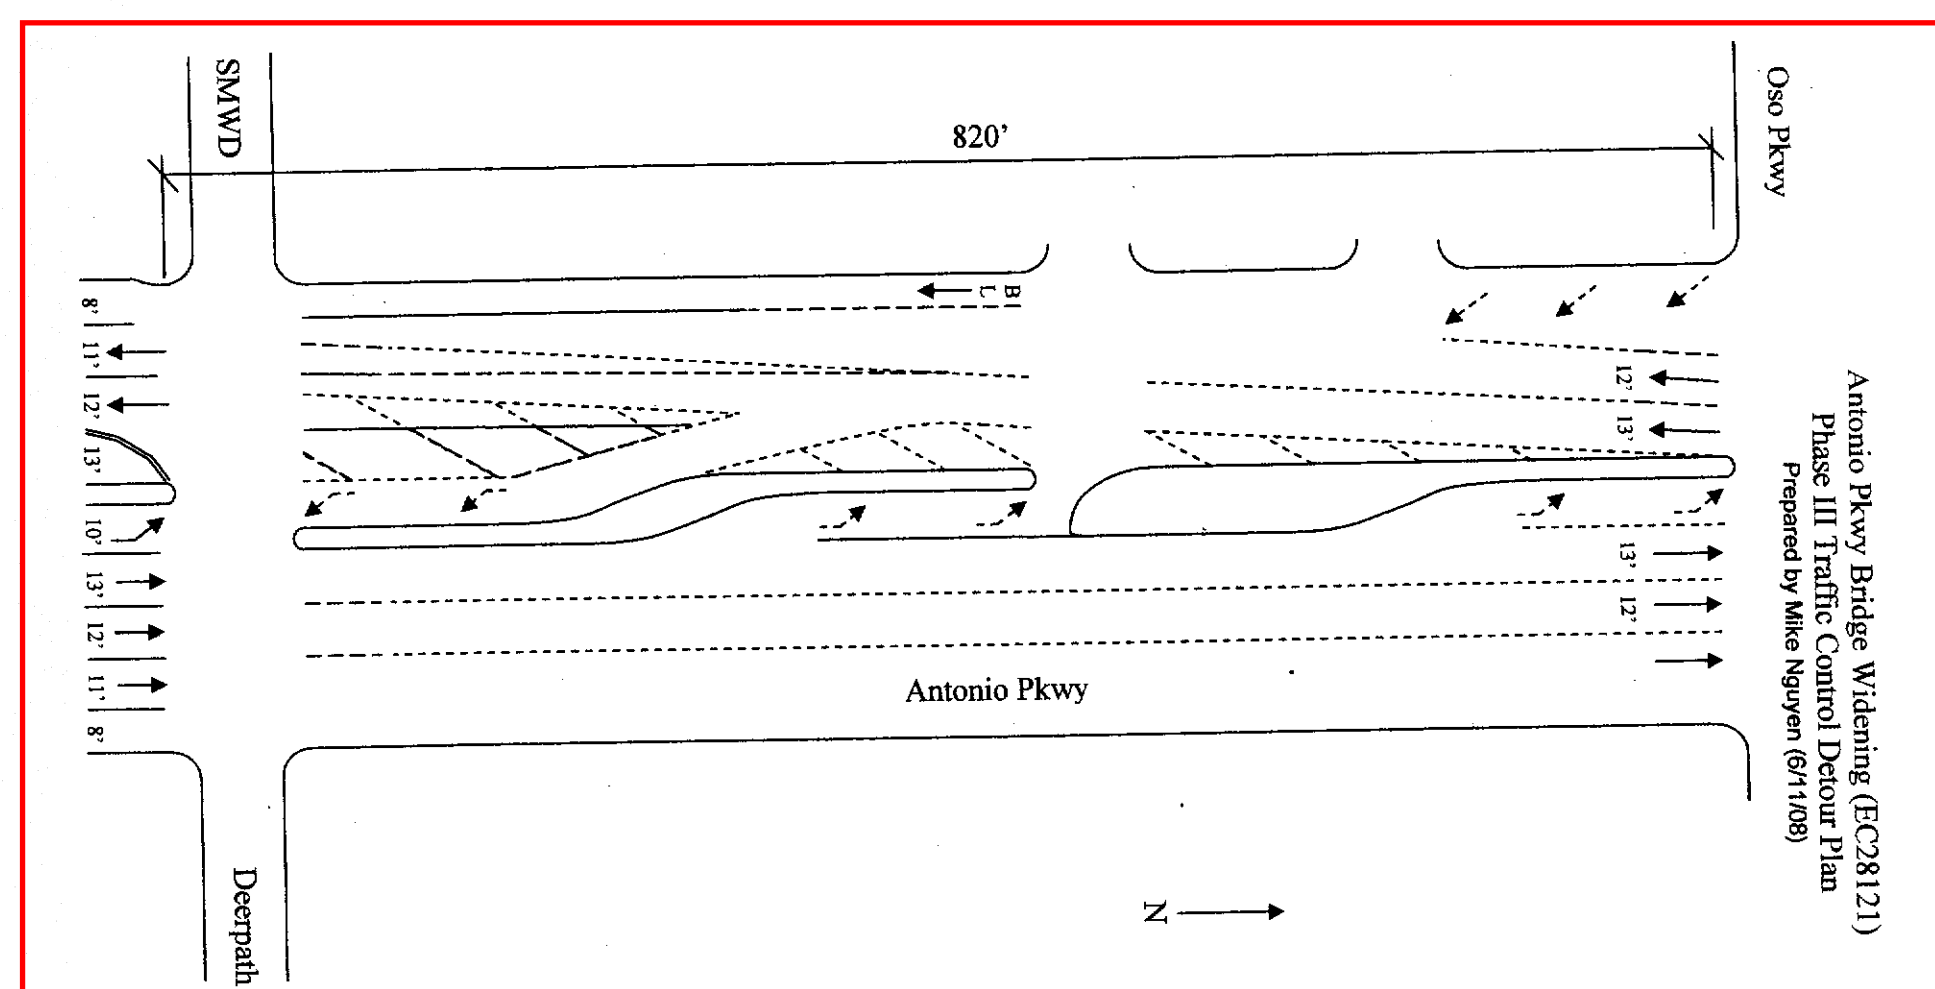


CONSTRUCTION NOTES

- 68 SANDBLAST CONFLICTING STRIPING
69 PAINT

LEGEND

- ← VEHICLE TRAVEL
▨ PHASE 3 CONSTRUCTION
○ DELINEATORS AT 100' O.C.
◆ K RAIL

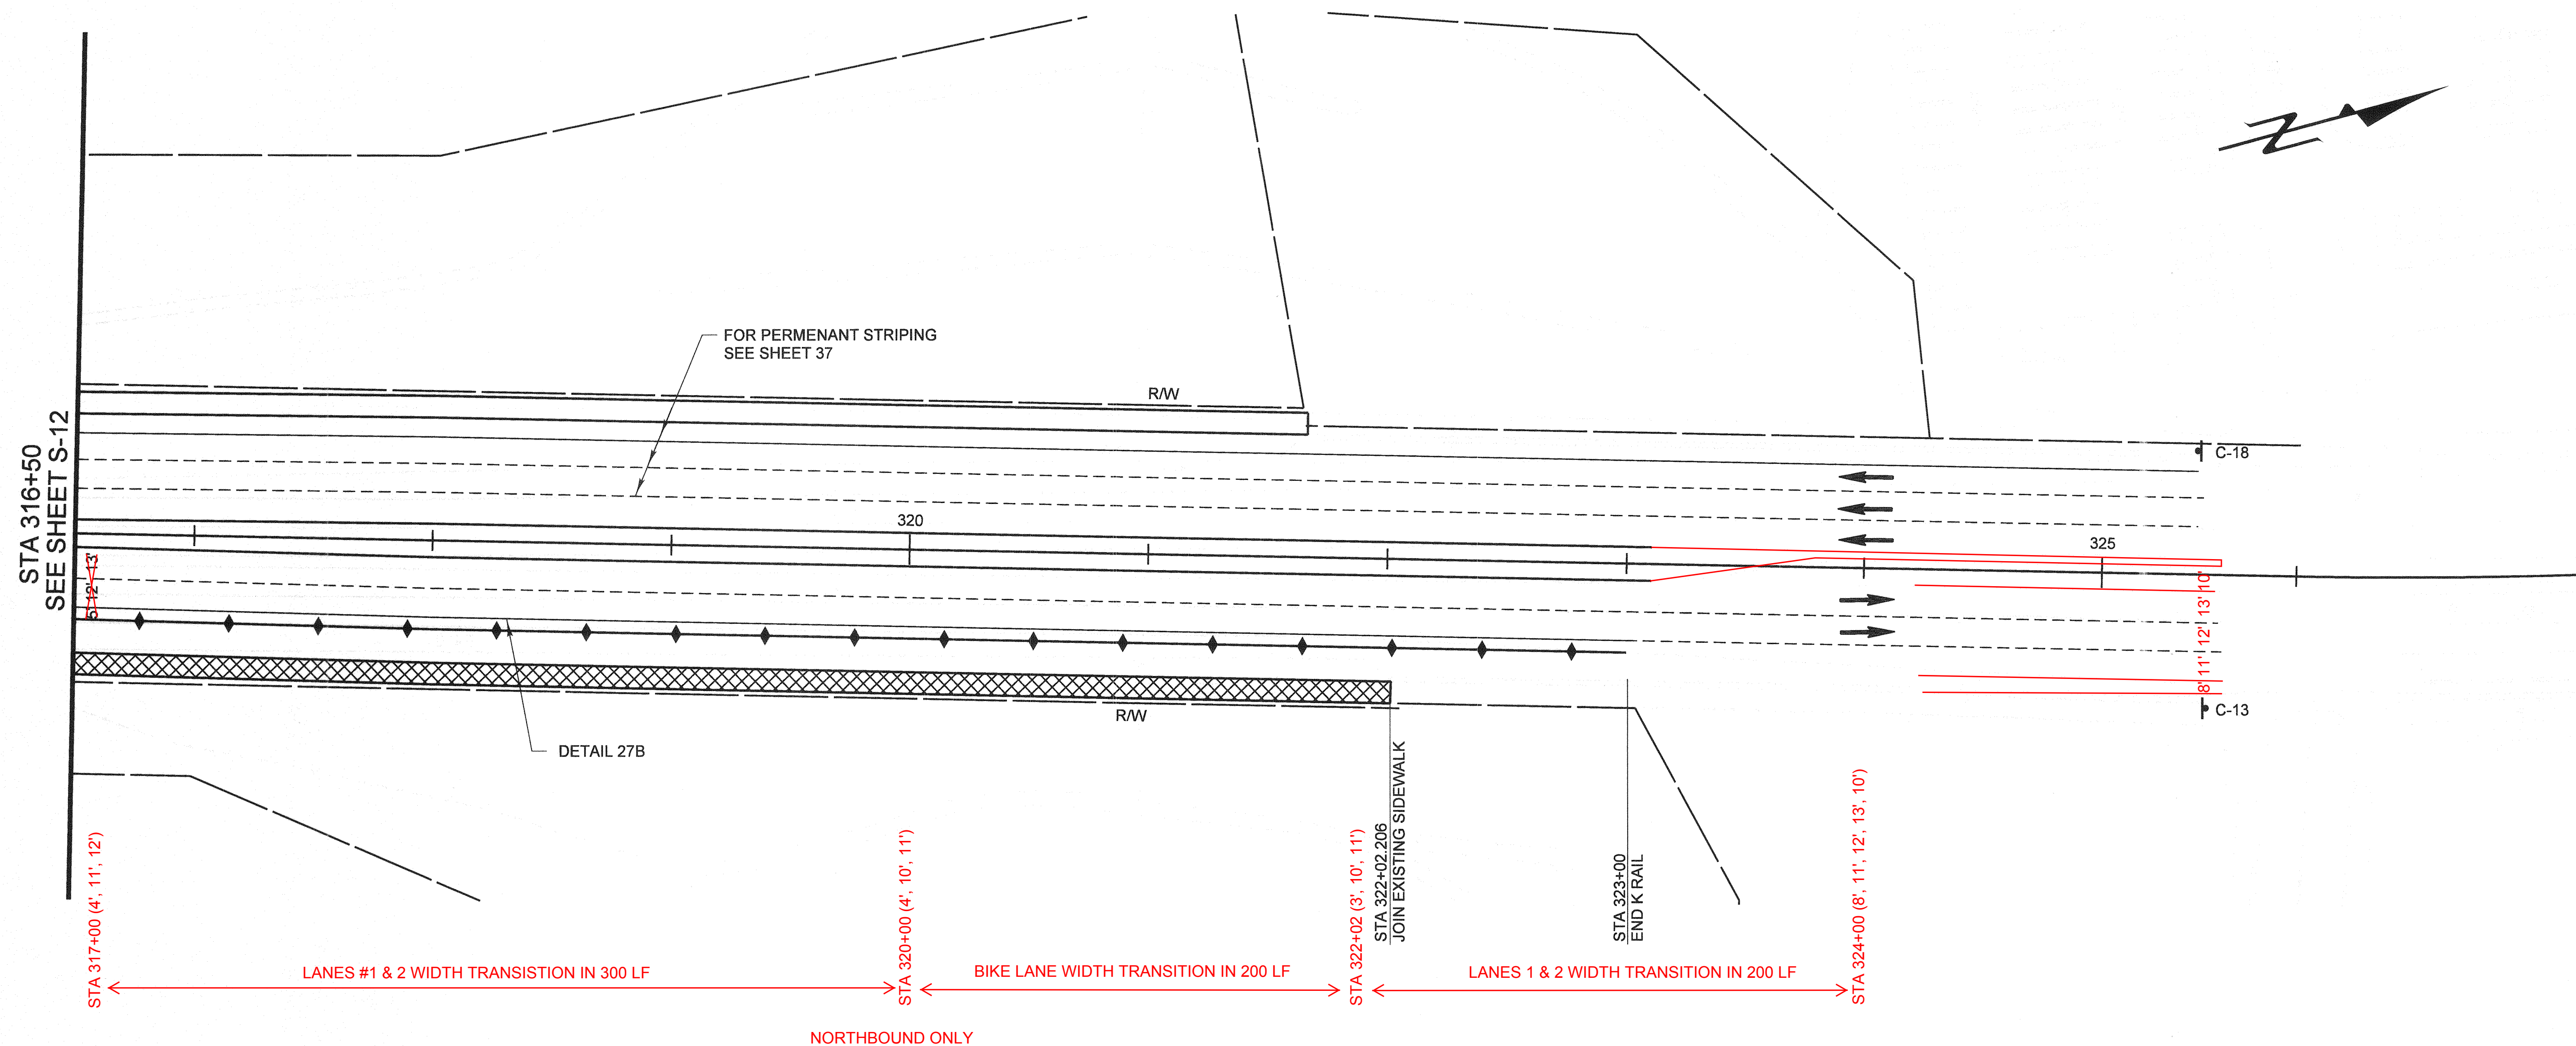

AS BUILT

CORRECTION BY: MN
CONTRACT NO.: ER28121
DATE: 12/30/2009

PLANS PREPARED BY: HNTB Corporation
200 E. SANDPOINTE AVENUE, SUITE 200
SANTA ANA, CALIFORNIA 92707
TEL (714) 460-1600 FAX (714) 460-1610

PLAN 1" = 40'		ORANGE COUNTY RESOURCES & DEVELOPMENT MANAGEMENT DEPT	
		ANTONIO PARKWAY WILDLIFE IMPROVEMENT PLANS	
		STAGE CONSTRUCTION TRAFFIC CONTROL PLAN PHASE III SC-13	
MARK	DATE	REVISIONS	
PREPARED UNDER RESPONSIBLE CHARGE OF:			
DESIGNED	R. NIERE	SHEET	
DRAWN	N. BUNIA	35	
SCALE	DATE	CHECKED	DRAWING NO.
AS SHOWN	11/18/06	S. STROHM	xxx

Date Plotted: 20 October, 2006 05:38

File Name: J:\34092\CADD\Hwy\Sheets\SC12.dgn

Border sheet last modified 09-Nov-1999