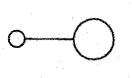




LEGEND

-  PROPOSED STREET LIGHT (TO BE INSTALLED BY SDG&E)
-  EXISTING STREET LIGHT

CONSTRUCTION NOTES

-  EXPANSION/DEFLECTION FITTING IS REQUIRED AT ALL JOINTS PER STD PLAN ES-9B DETAIL XY.

SEE SHEET 21S

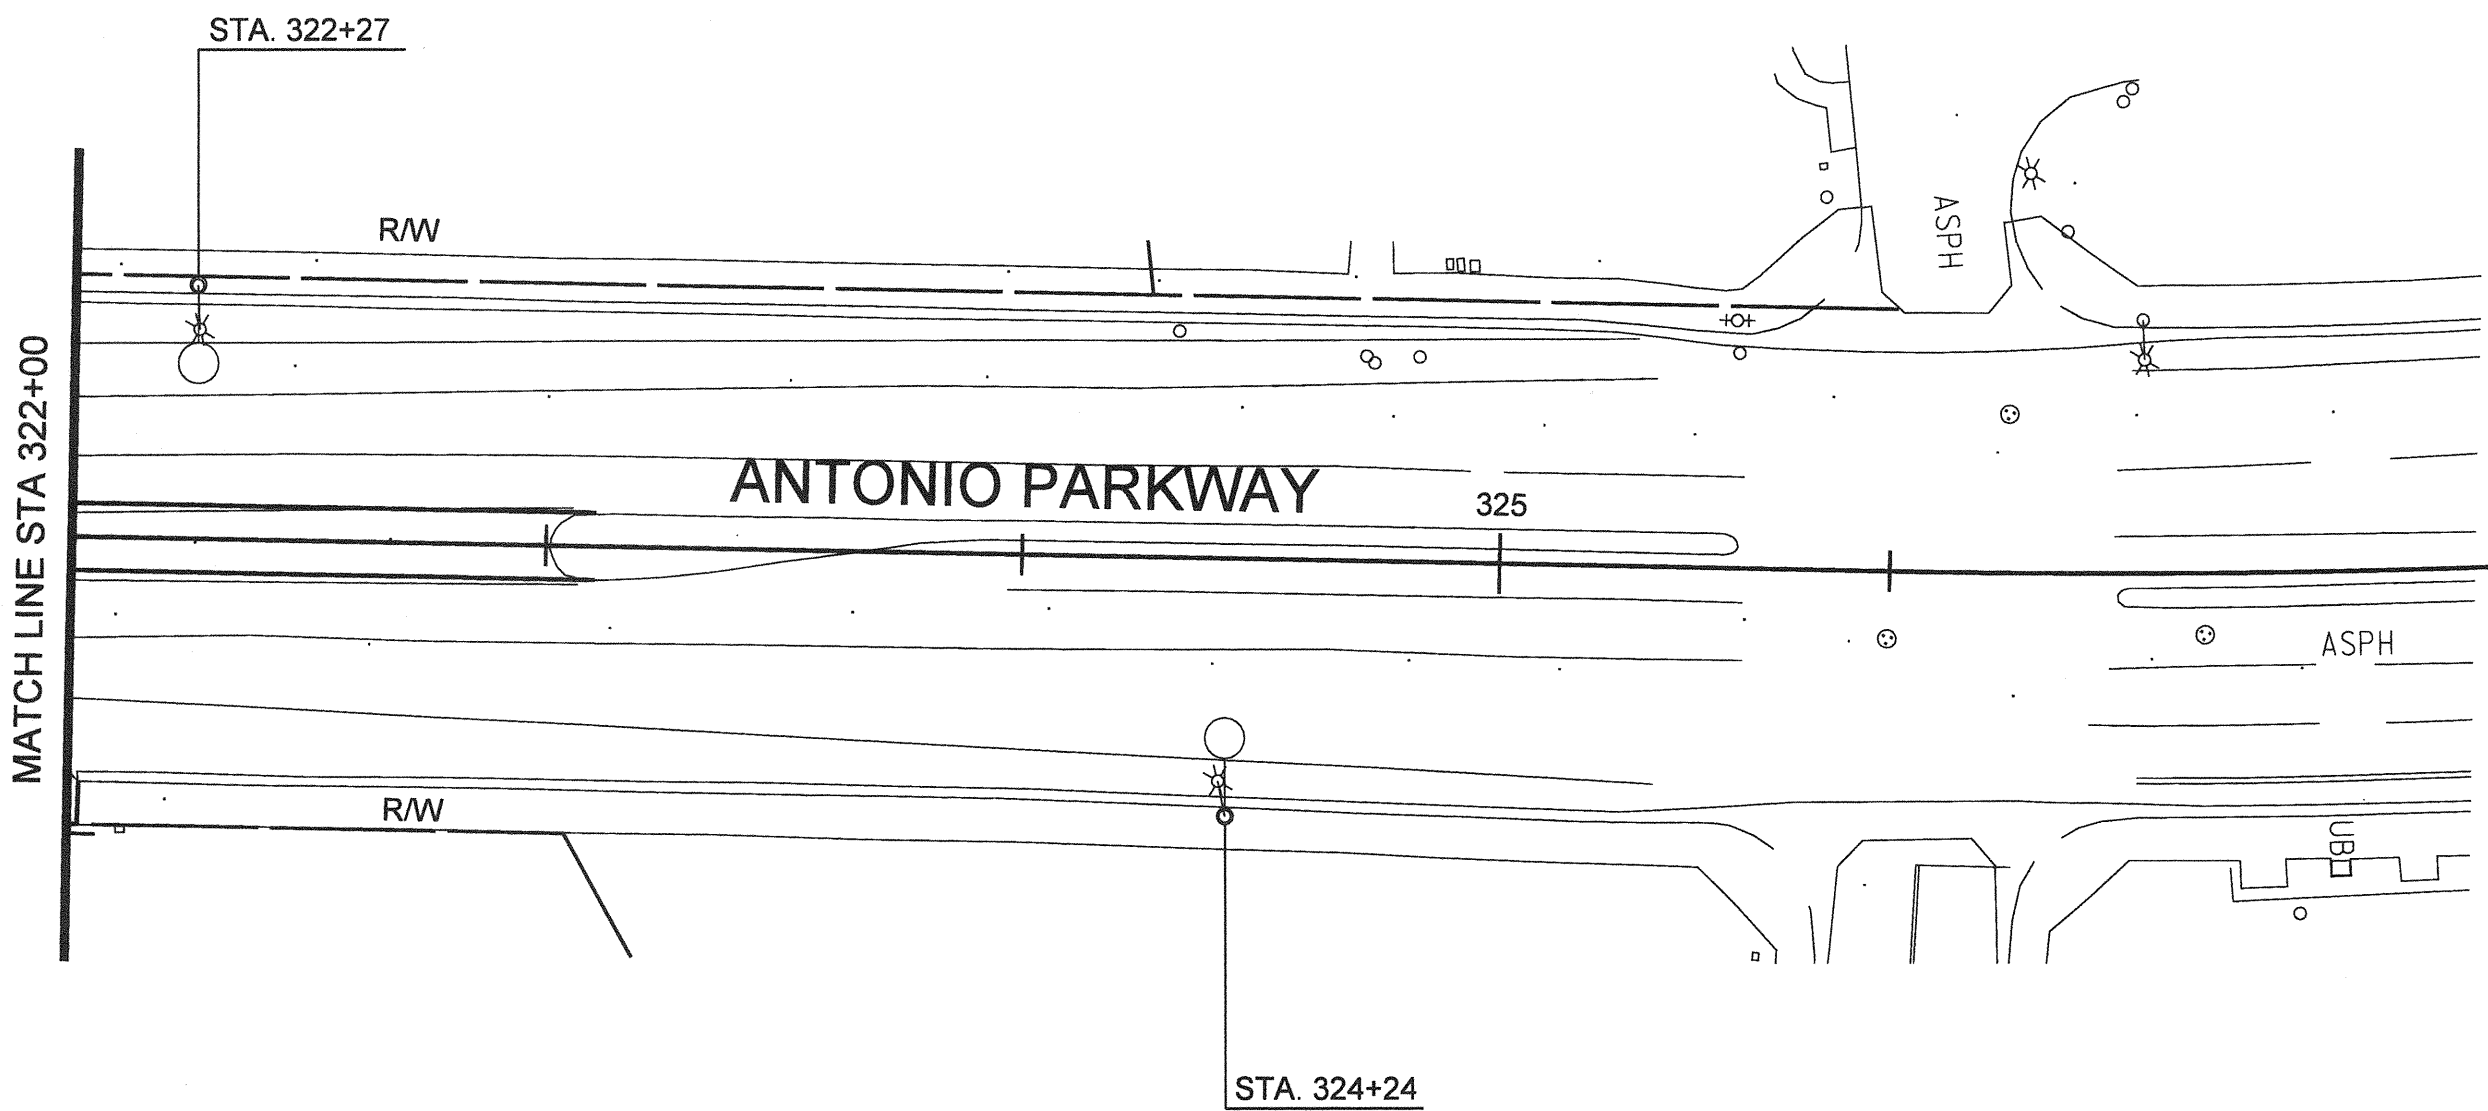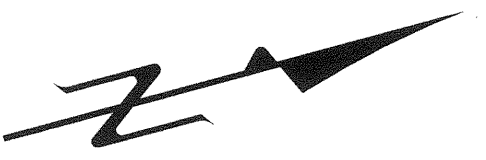

AS BUILT

CORRECTION BY: MN

CONTRACT NO.: ER28121

DATE: 12/30/2009

PLANS PREPARED BY:


FPL

FPL and Associates, Inc.

10 COPORATE PARK
SUITE 310
IRVINE, CALIFORNIA 92606

HNTB

200 E. SANDPOINTE AVENUE
SUITE 200
SANTA ANA, CALIFORNIA 92707

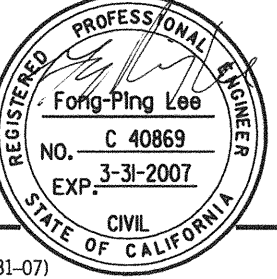PLAN		
1" = 40'		
MARK	DATE	DESCRIPTION
REVISIONS		
PREPARED UNDER RESPONSIBLE CHARGE OF:		
		
Fong-Ping Lee P.E. 40869 (EXP. 03-31-07)		

ORANGE COUNTY
RESOURCES & DEVELOPMENT MANAGEMENT DEPT

ANTONIO PARKWAY
WILDLIFE
IMPROVEMENT PLANS

**LIGHTING
PLAN
L-2**

DESIGNED <u>R. NIERE</u>	SHEET
DRAWN <u>N. BLUNA</u>	41
CHECKED <u>S. STROH</u>	OF 72
SCALE <u>AS SHOWN</u>	DRAWING NO. <u>xxx</u>