



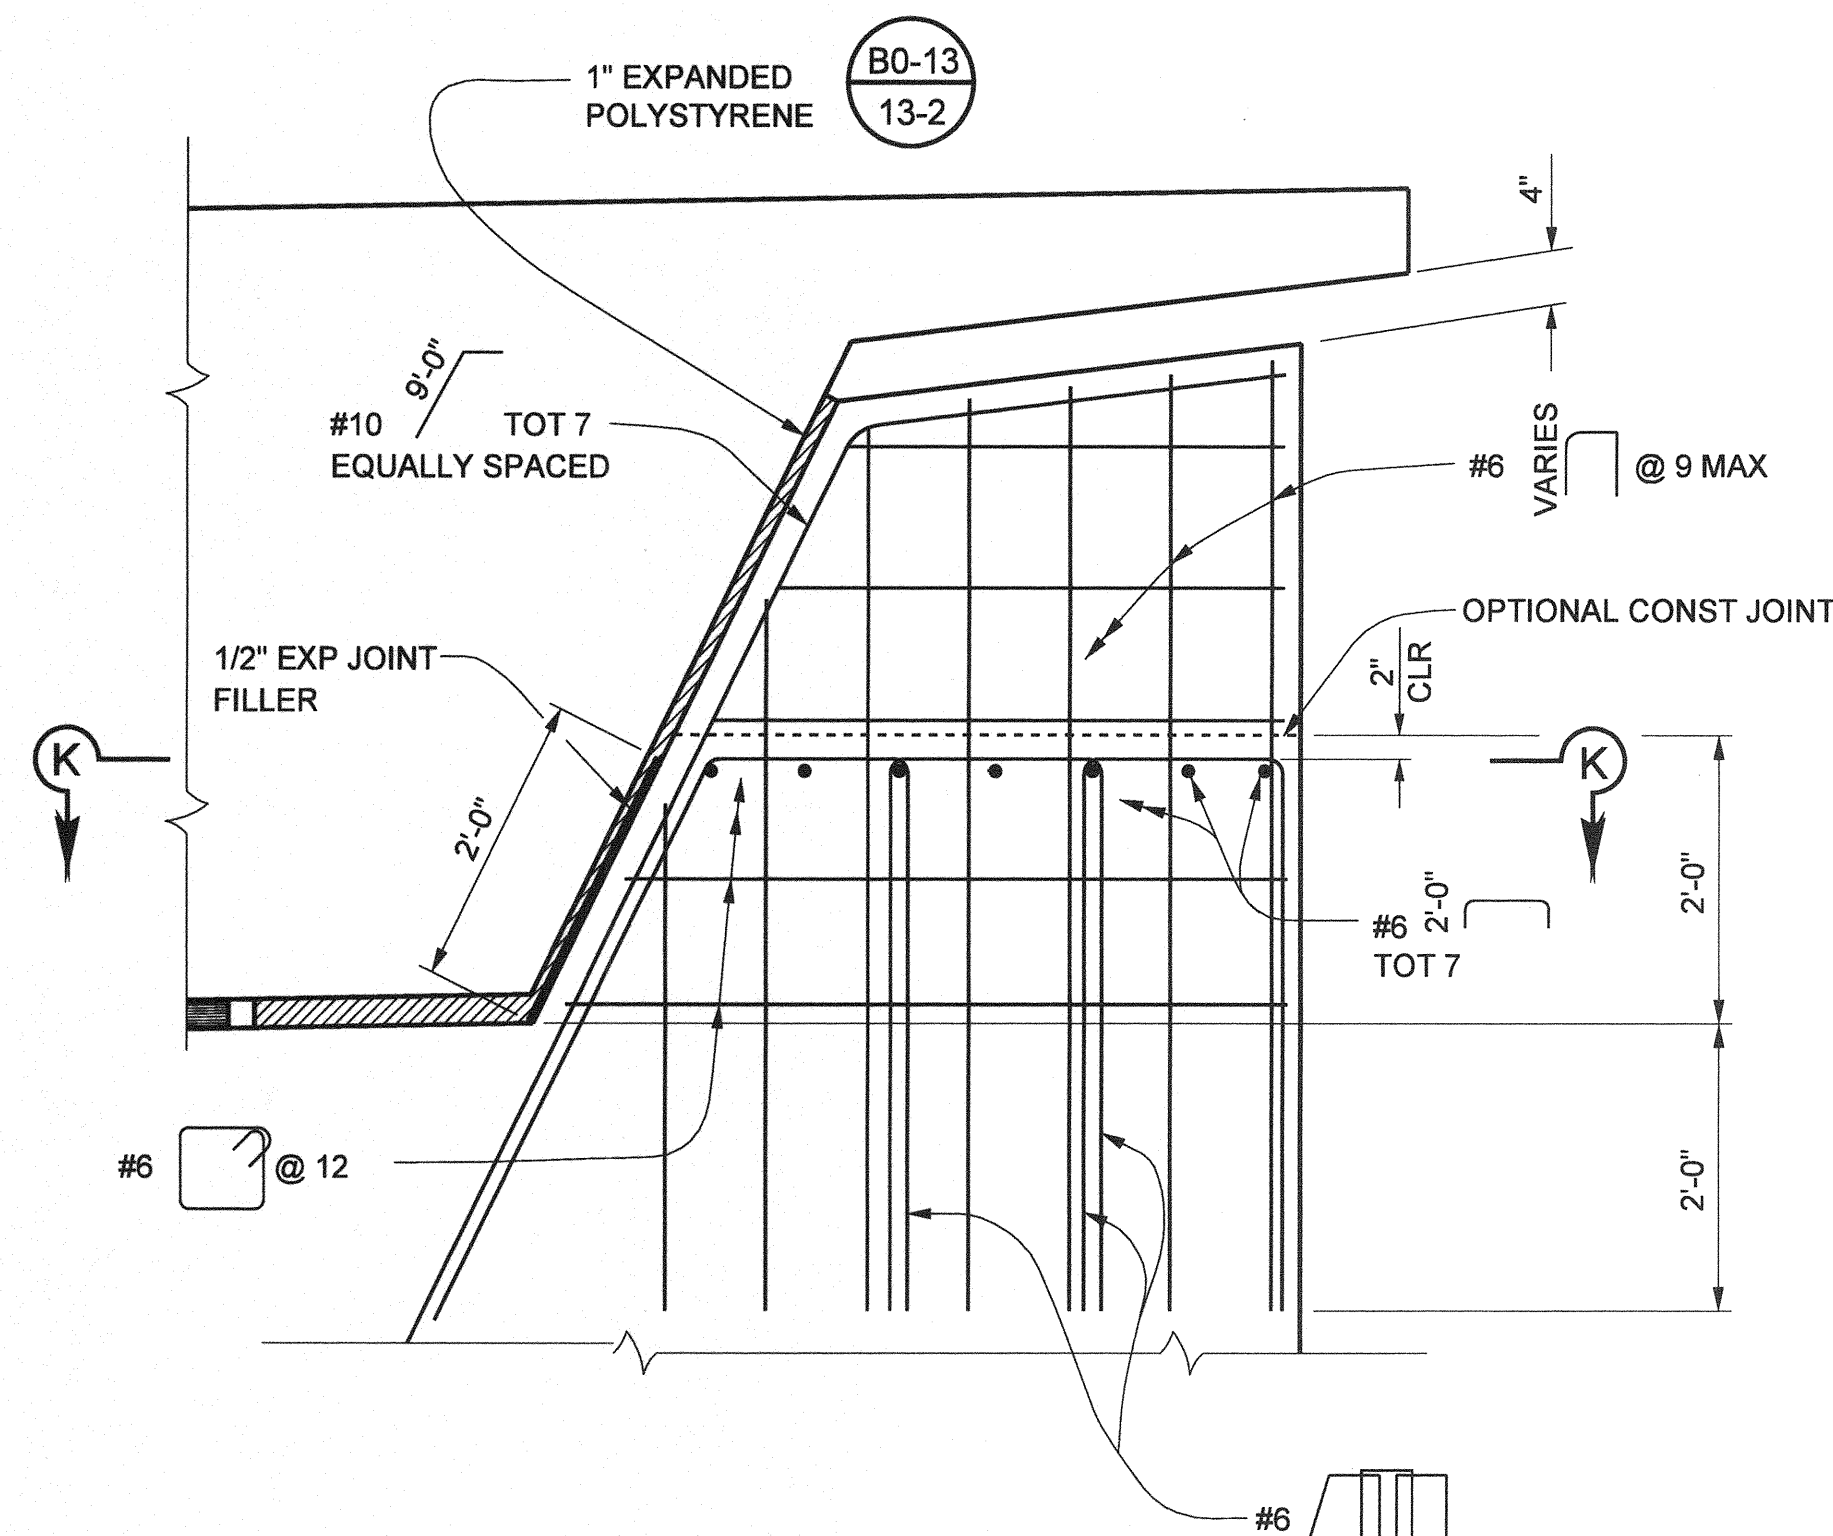

SHEAR KEY ELEVATION

3/4" = 1'-0"
NORTH SHEAR KEY SHOWN
SOUTH SHEAR KEY SIMILAR

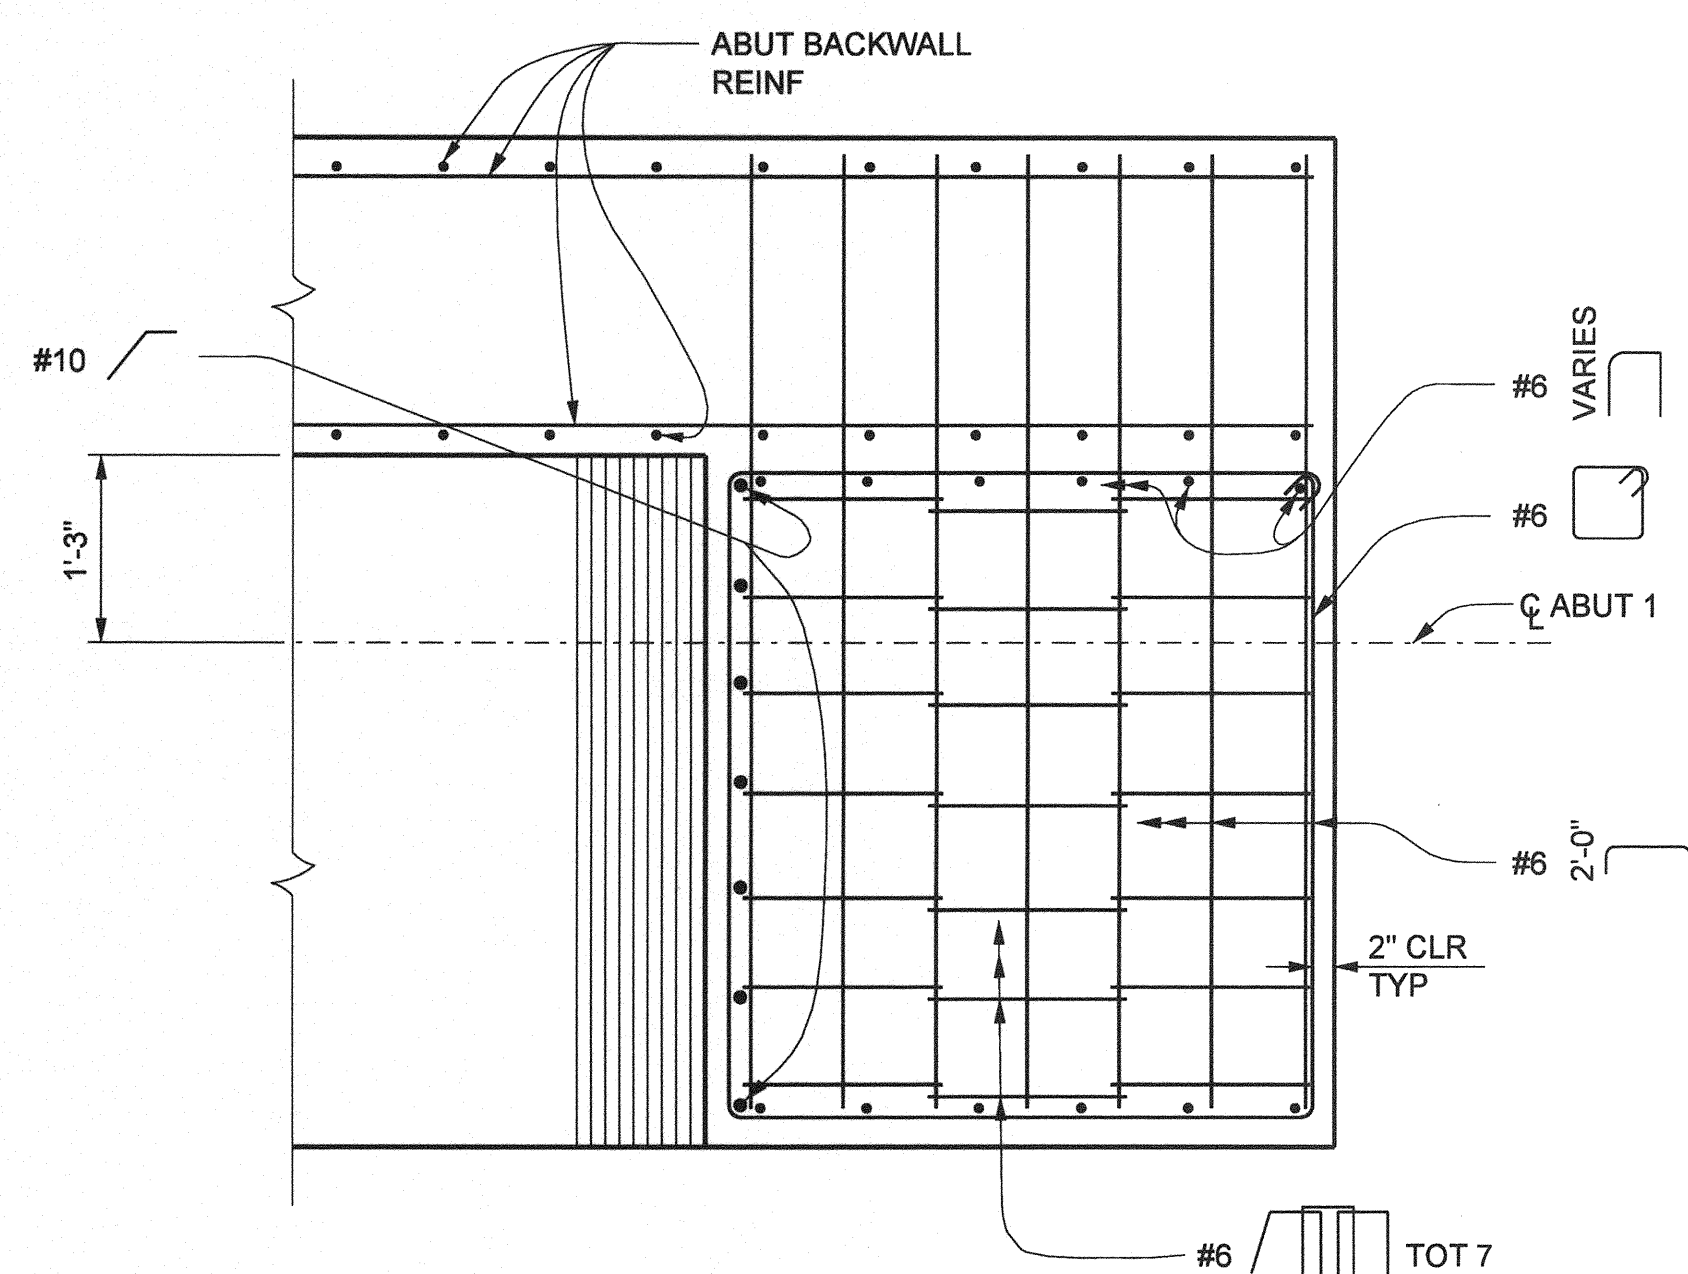


SECTION K-K

3/4" = 1'-0"


NOTE:

THE CONTRACTOR SHALL VERIFY ALL CONTROLLING
FIELD DIMENSIONS BEFORE ORDERING OR FABRICATING
ANY MATERIAL.

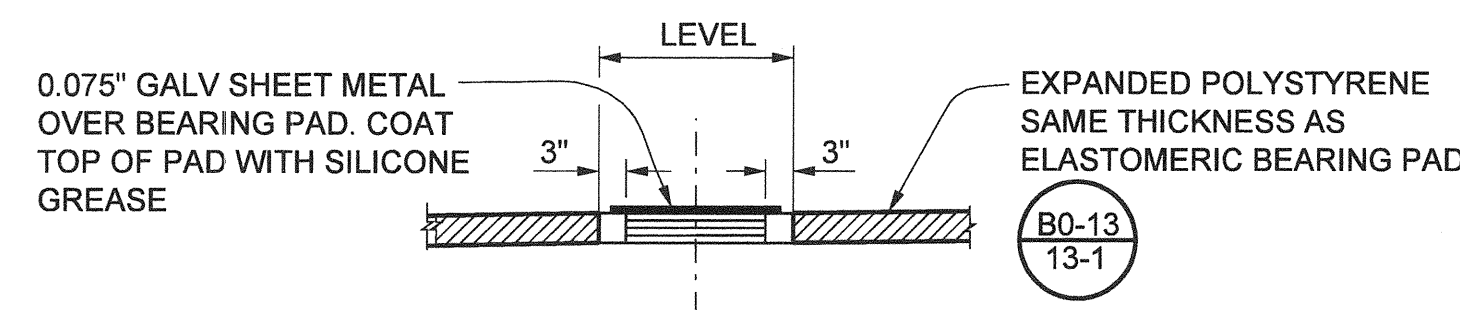

SECTION J-J


RC BOX GIRDER SHOWN
RC SLAB SIMILAR

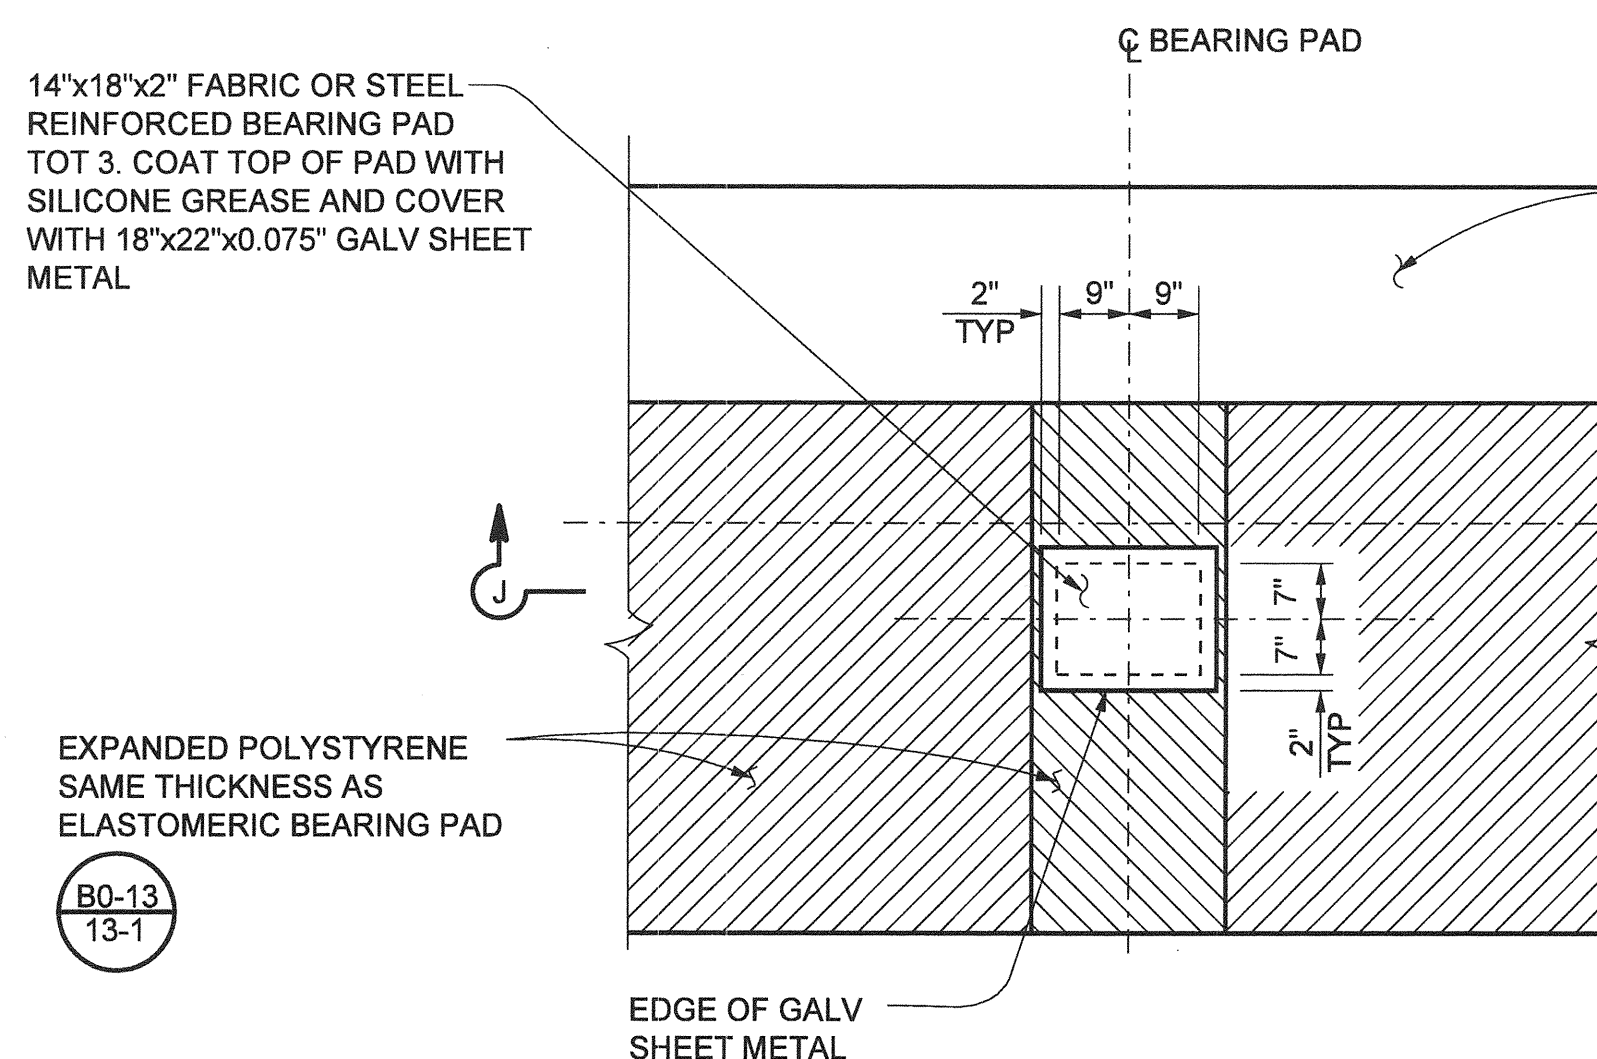

RC BOX GIRDER


ELASTOMERIC BEARING PAD DETAIL

NO SCALE

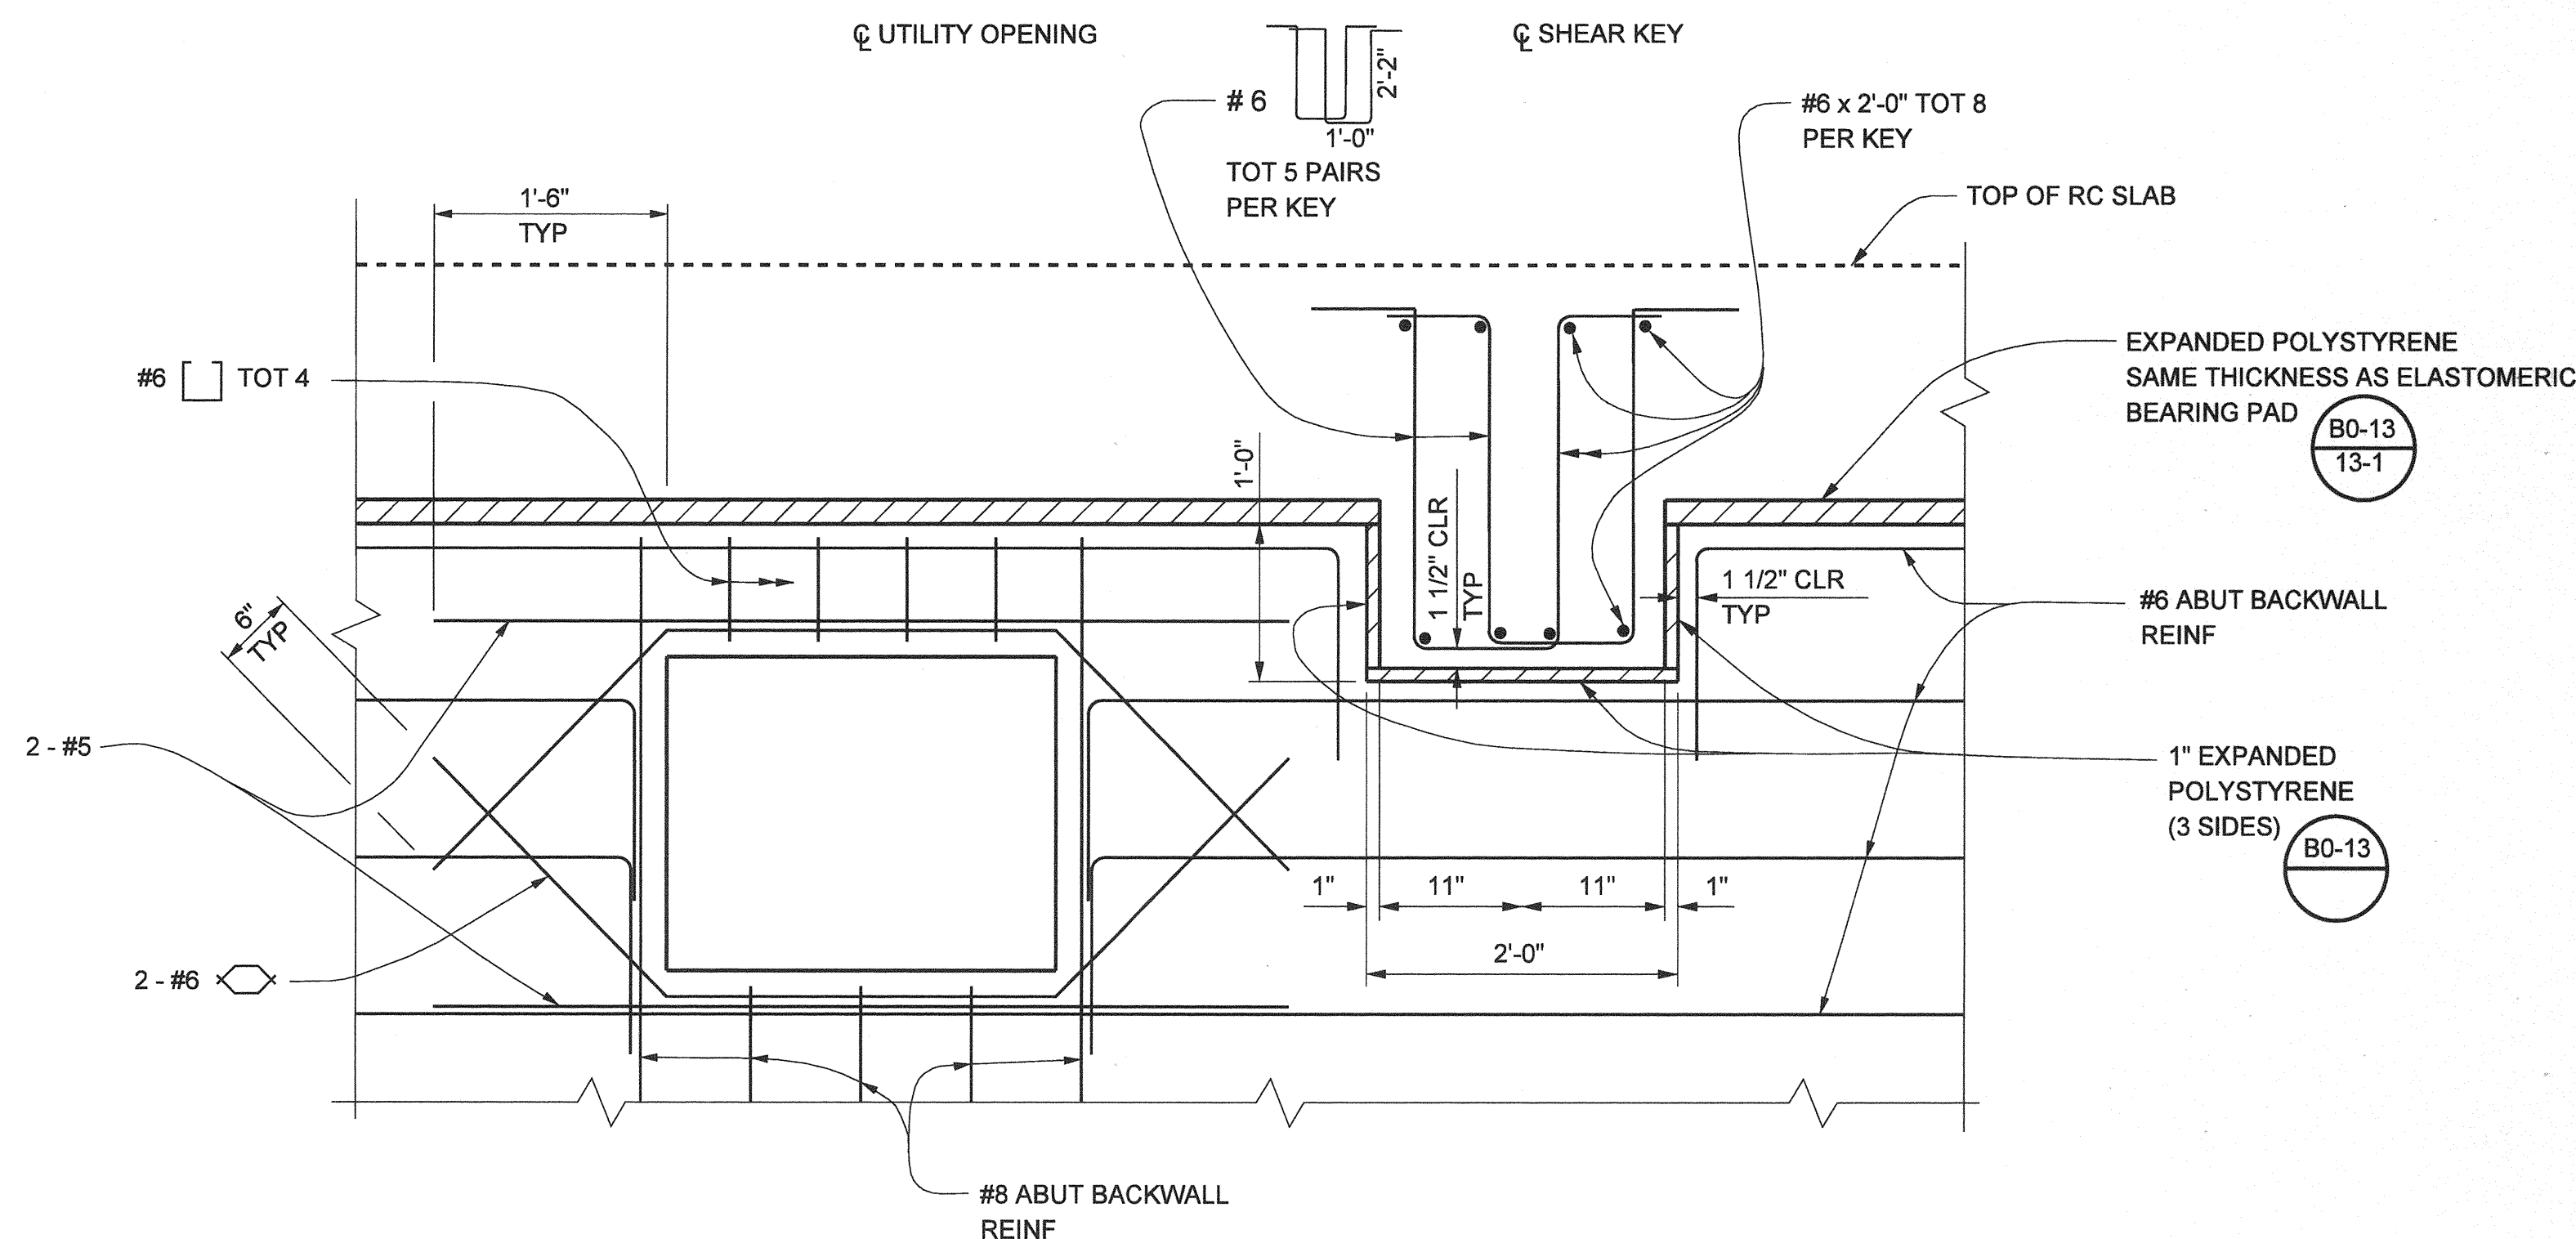

SECTION G-G

1" = 1'-0"

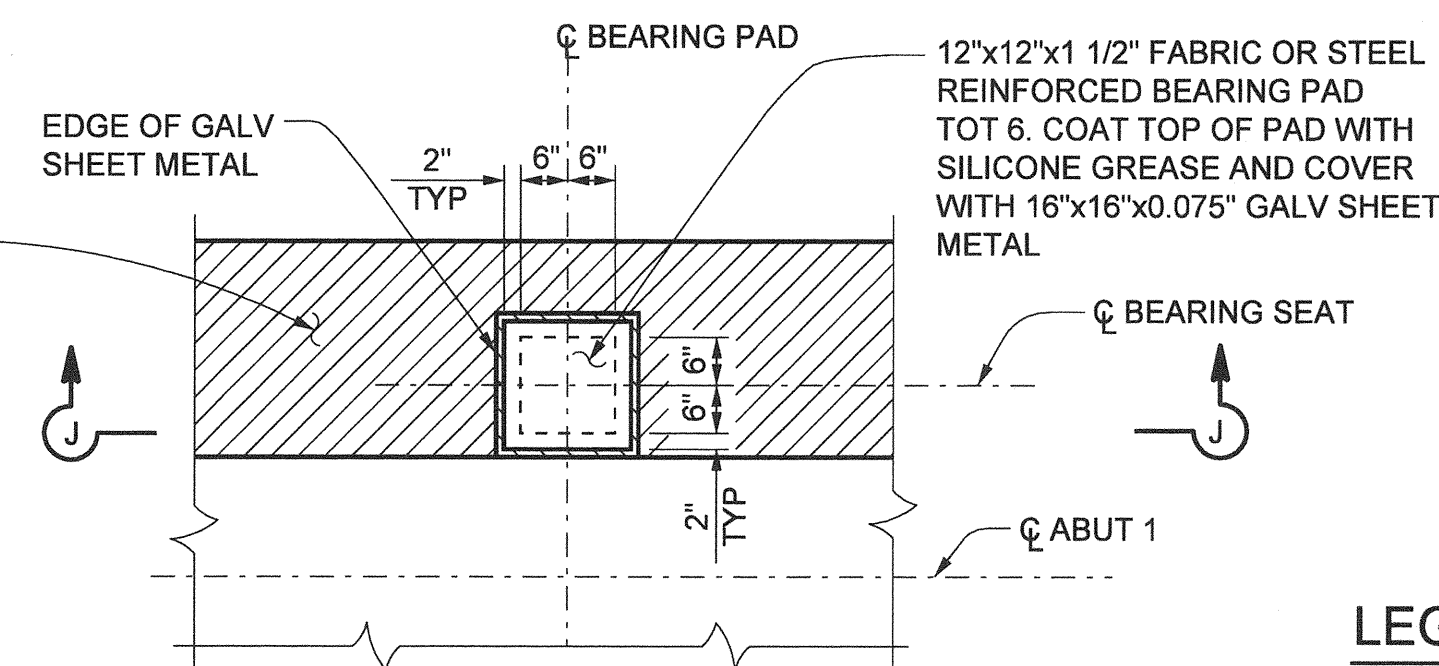

RC SLAB

BEARING PAD ON BACKWALL SHOWN
BEARING PAD ON BRACKET SIMILAR

NO AS BUILT CHANGES

AS BUILT

CORRECTION BY: MN
CONTRACT NO.: ER28121
DATE: 12/30/2009

LEGEND

- EXPANDED POLYSTYRENE ON SLOPE CONCRETE
- EXPANDED POLYSTYRENE ON LEVEL CONCRETE

1 1/2 0 1 2
3 Inches on original drawing

ORANGE COUNTY RESOURCES & DEVELOPMENT MANAGEMENT DEPT		ANTONIO PARKWAY WILDLIFE UNDERCROSSING (WIDEN)		ABUTMENT 1 DETAILS NO. 1	
DESIGNED	J. WANG	CHECKED	F. JEANG	SHEET 49 OF 72	
DRAWN	J. WANG	DATE	9/18/08	DRAWING NO.	
SCALE		AS SHOWN		DATE	
NO. C 43559		EXP. 5-30-08		RCE C 43559 (EXP. 6-30-06)	
Yung-Nien Wang		PROFESSIONAL ENGINEER		DATE 11/31/06	

PLANS PREPARED BY:
HNTB
HNTB Corporation
200 E. SANDPOINTE AVENUE, SUITE 200
SANTA ANA, CALIFORNIA 92707
TEL (714) 460-1600 FAX (714) 460-1610

Date Plotted:

File Name: J:\34092\CADD\Struct\Antoniopkwy-S-08.dgn

Border sheet last modified 08-Nov-1999