



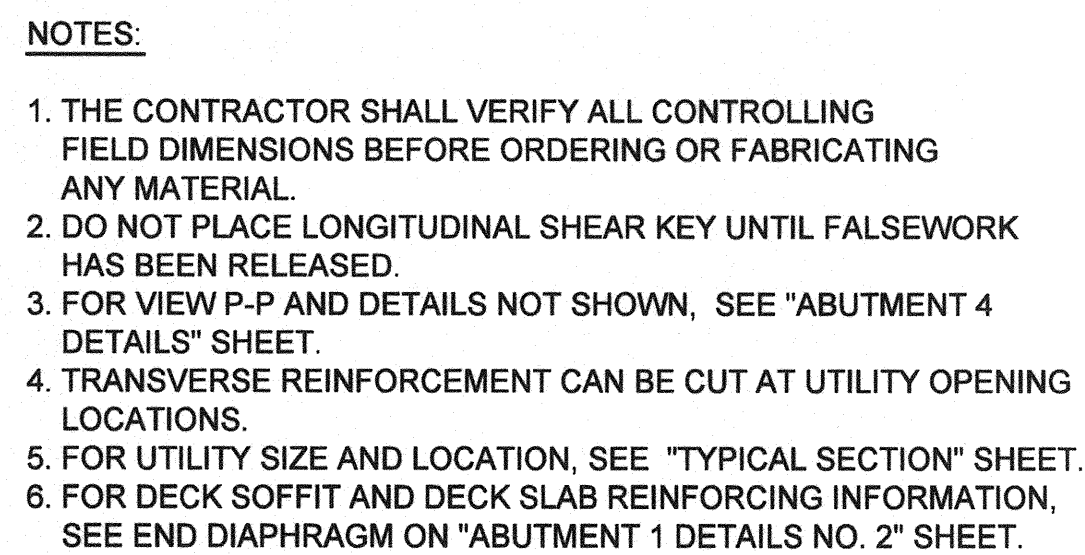

LEGEND

	BRIDGE REMOVAL (PORTION)
	CLOSURE POUR
	EXPANDED POLYSTYRENE
	REMOVE & REPLACE CONCRETE
	DENOTES EXISTING STRUCTURE
	DENOTES NEW STRUCTURE

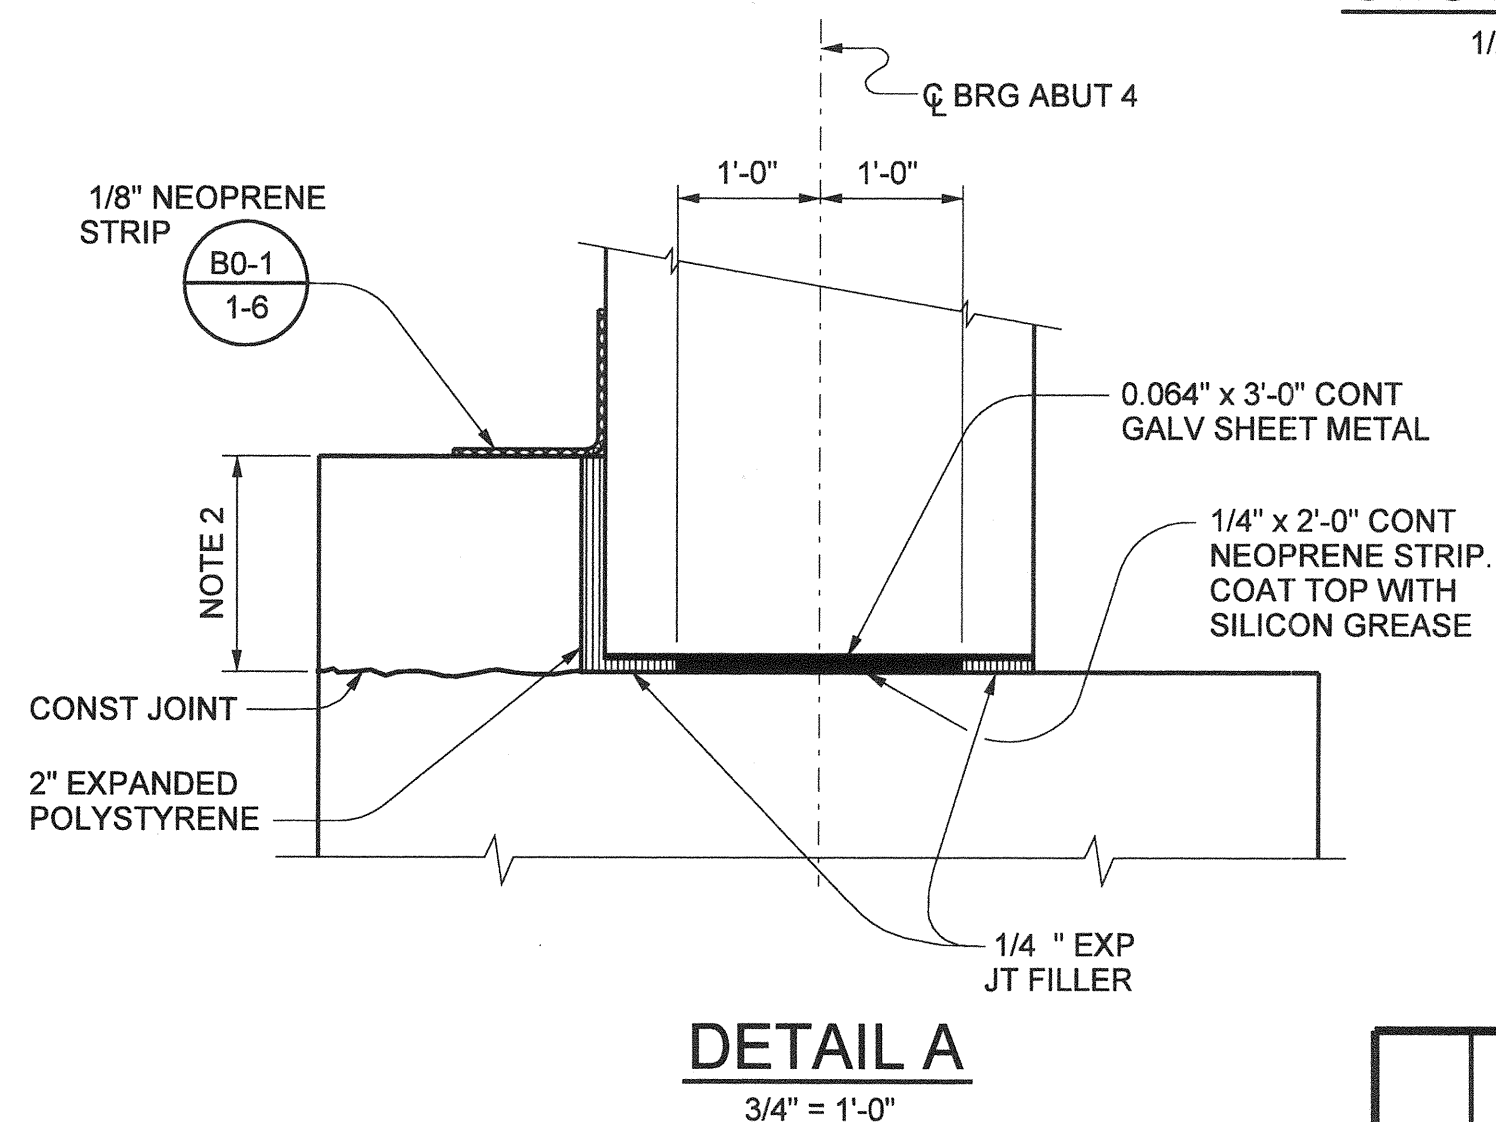



AS BUILT

CORRECTION BY: _____ MN _____

CONTRACT NO.: _____ ER28121 _____

DATE: _____ 12/30/2009 _____

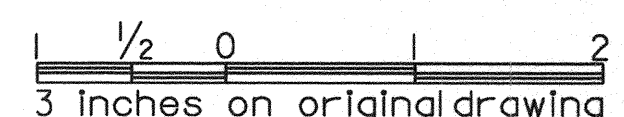

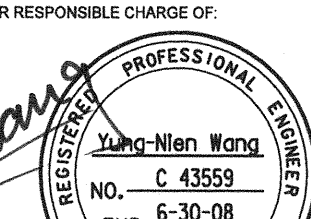ORANGE COUNTY RESOURCES & DEVELOPMENT MANAGEMENT DEPT		
ANTONY PARKWAY WILDLIFE UNDERCROSSING (WIDEN)		
REVISIONS		
PREPARED UNDER RESPONSIBLE CHARGE OF:		
 Yung-Nien Wang No. C 43559 EXP. 6-30-08 CIVIL 12/31/06		
Yung-Nien Wang RCE C 43559 (EXP. 6-30-08)		
DATE		
DESIGNED <u>J. WONG</u> 5 SHEET		
DRAWN <u>N. MOBILES</u> CHECKED <u>F. JEANG</u>		
SCALE AS SHOWN DATE 9/18/08		
DRAWING NO. 51		
 OF 72		

PLANS PREPARED BY:

HNTB

HNTB Corporation
200 E. SANDPOINTE AVENUE, SUITE 200
SANTA ANA, CALIFORNIA 92707
TEL (714) 460-1600 FAX (714) 460-1610

Date Plotted: File Name: J:\34092\CADD\Strc\sheets\antoniopkwy-S-10.dgn

3border sheet last modified 09-Nov-1999