


ABUT 4 SHEAR KEY REINFORCEMENT

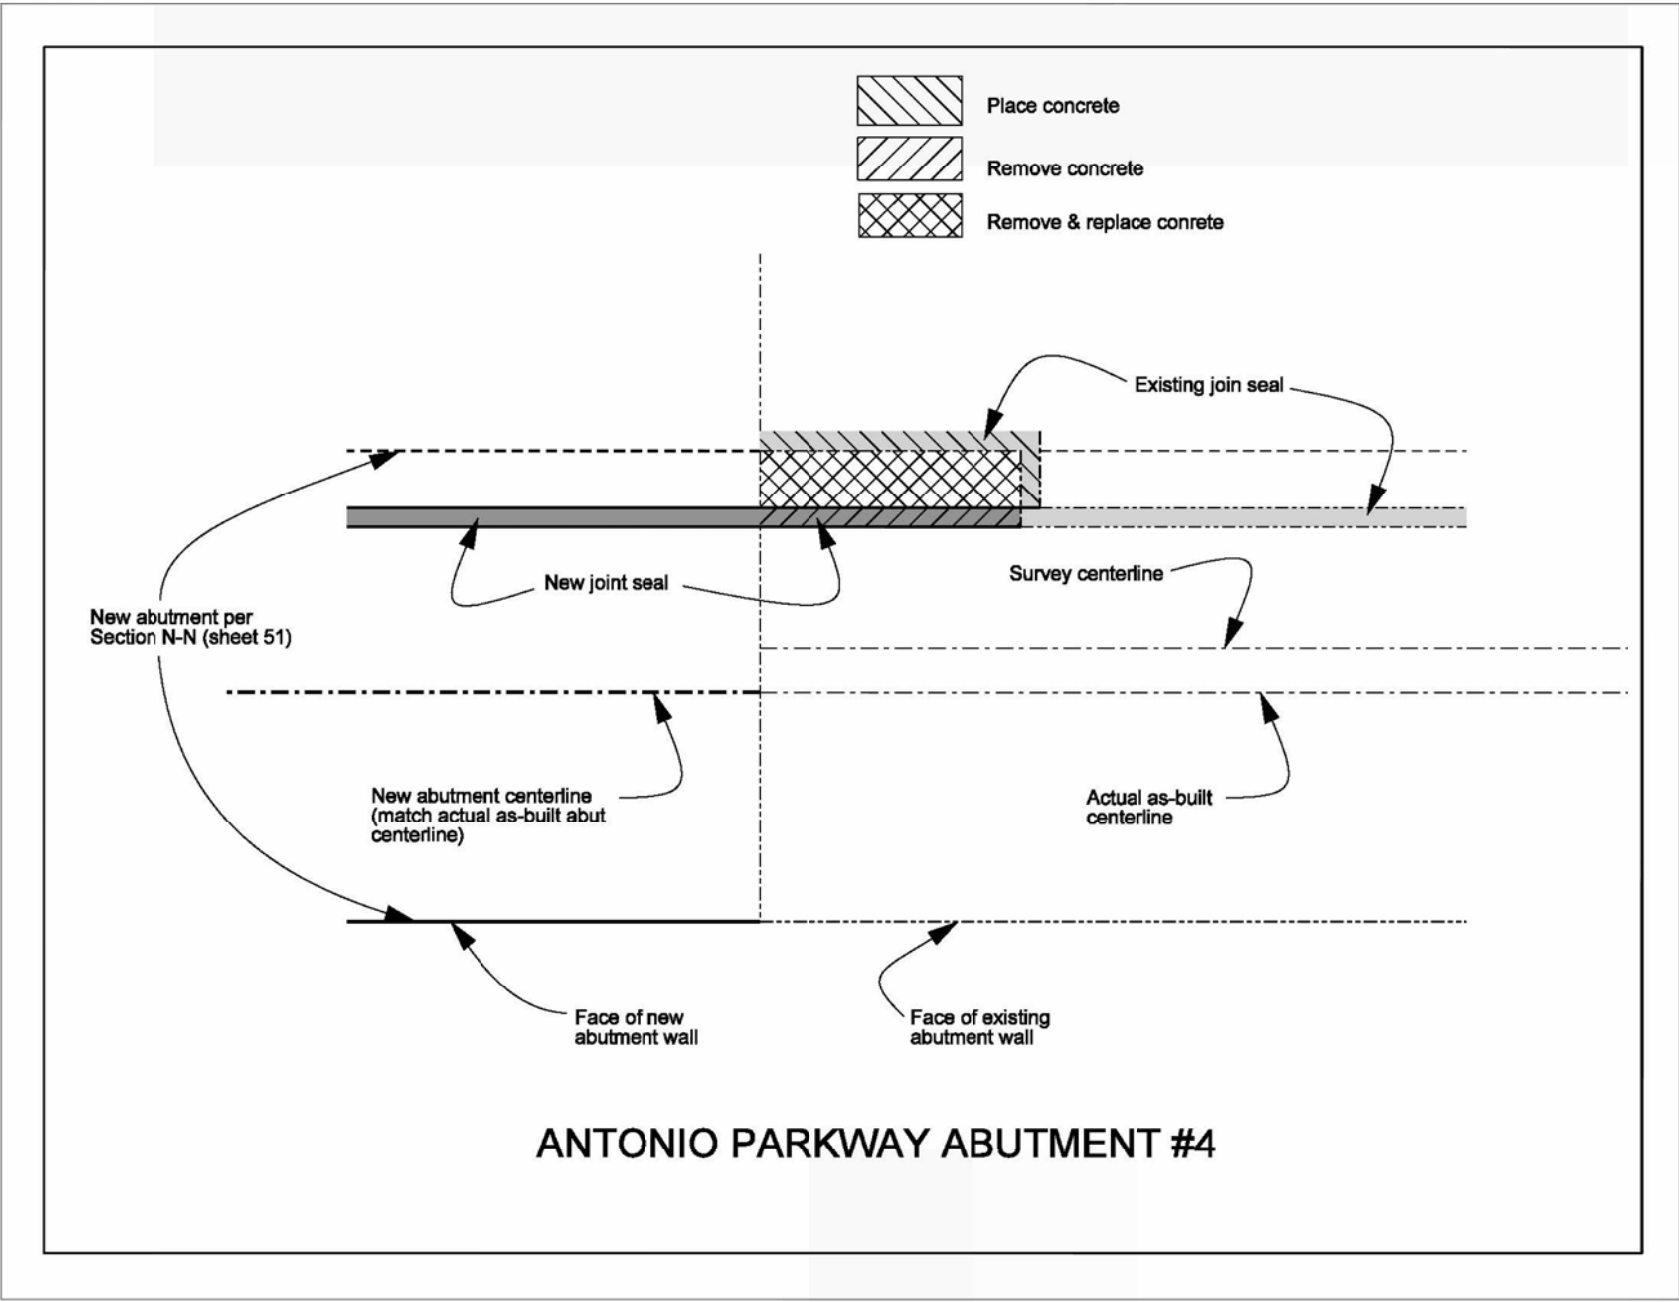

ABUTMENT 4 JOINT SEAL

AS BUILT
CORRECTION BY: MN
CONTRACT NO.: ER28121
DATE: 12/30/2009

PLAN 1" =		ORANGE COUNTY PUBLIC FACILITIES AND RESOURCES DEPARTMENT	
		ANTONIO PARKWAY WILDLIFE UNDERCROSSING (WIDEN)	
		ABUTMENT 4 LAYOUT	
MARK	DATE	DESCRIPTION	
REVISIONS			
PREPARED UNDER RESPONSIBLE CHARGE OF:			
DESIGNED	CHECKED	SHEET	
DRAWN	CHECKED	51S	
SCALE AS SHOWN	DATE	DRAWING NO.	OF 72