



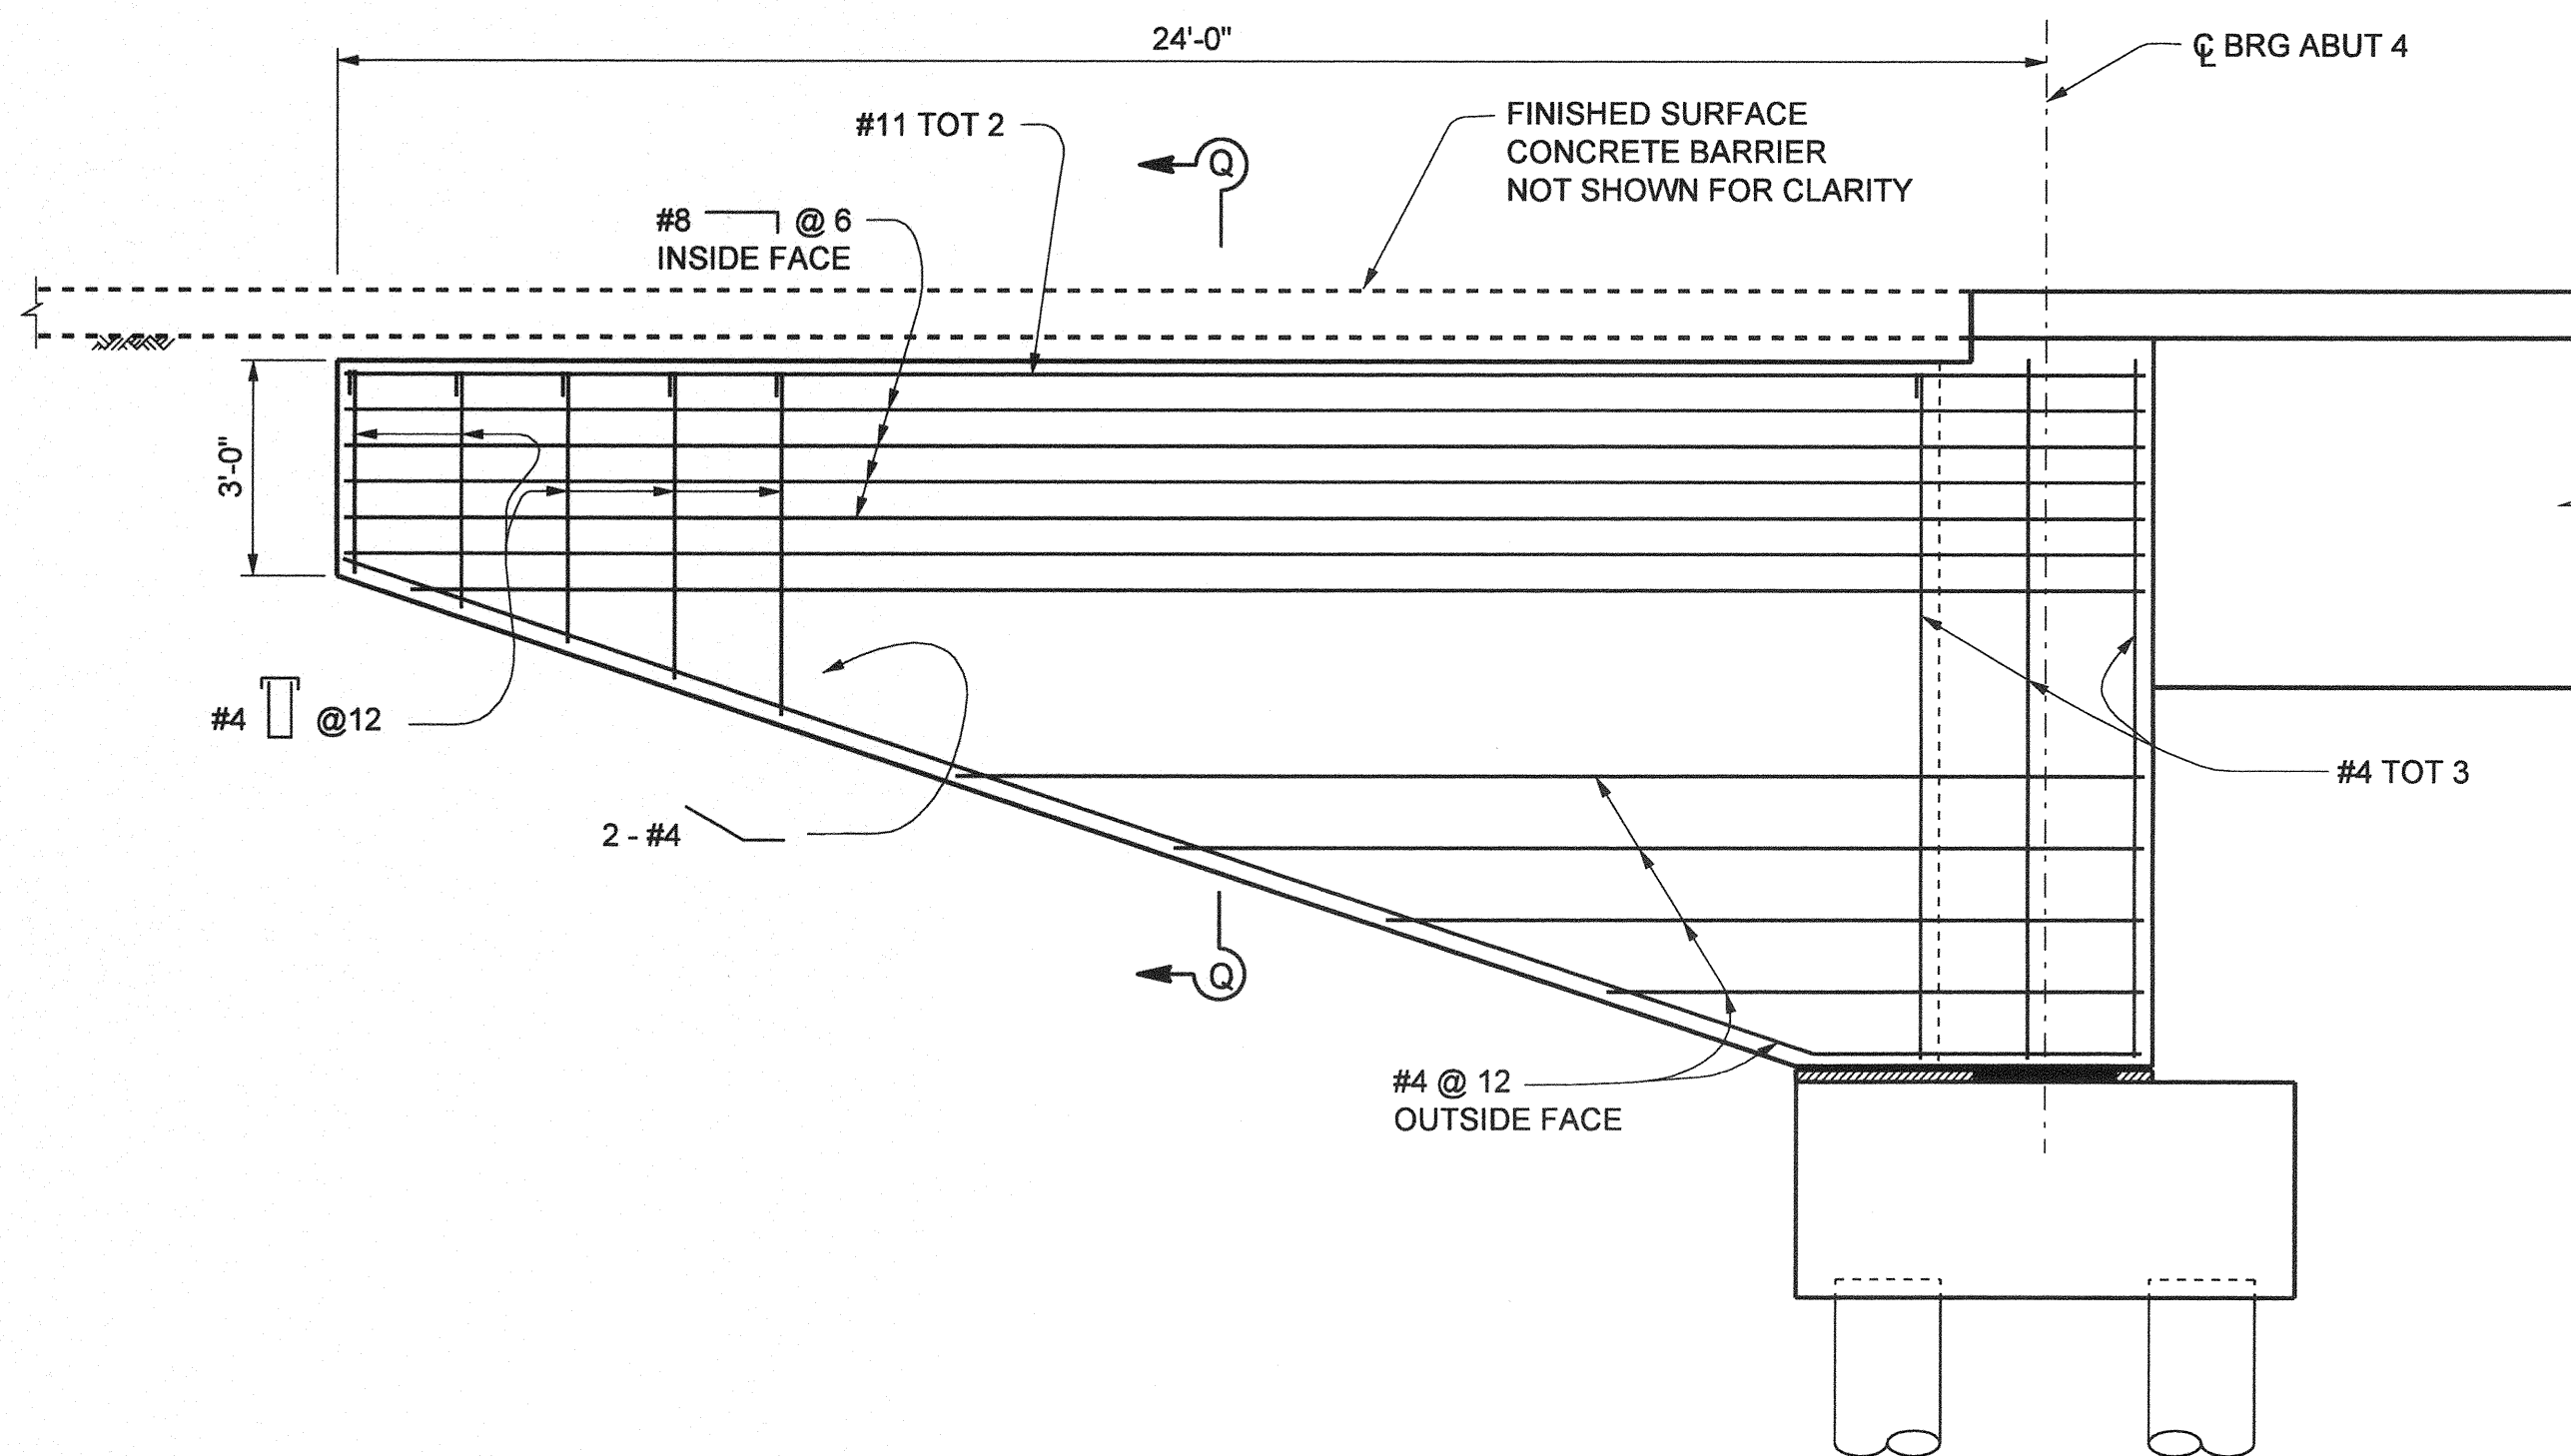

WINGWALL ELEVATION

3/8" = 1'-0"

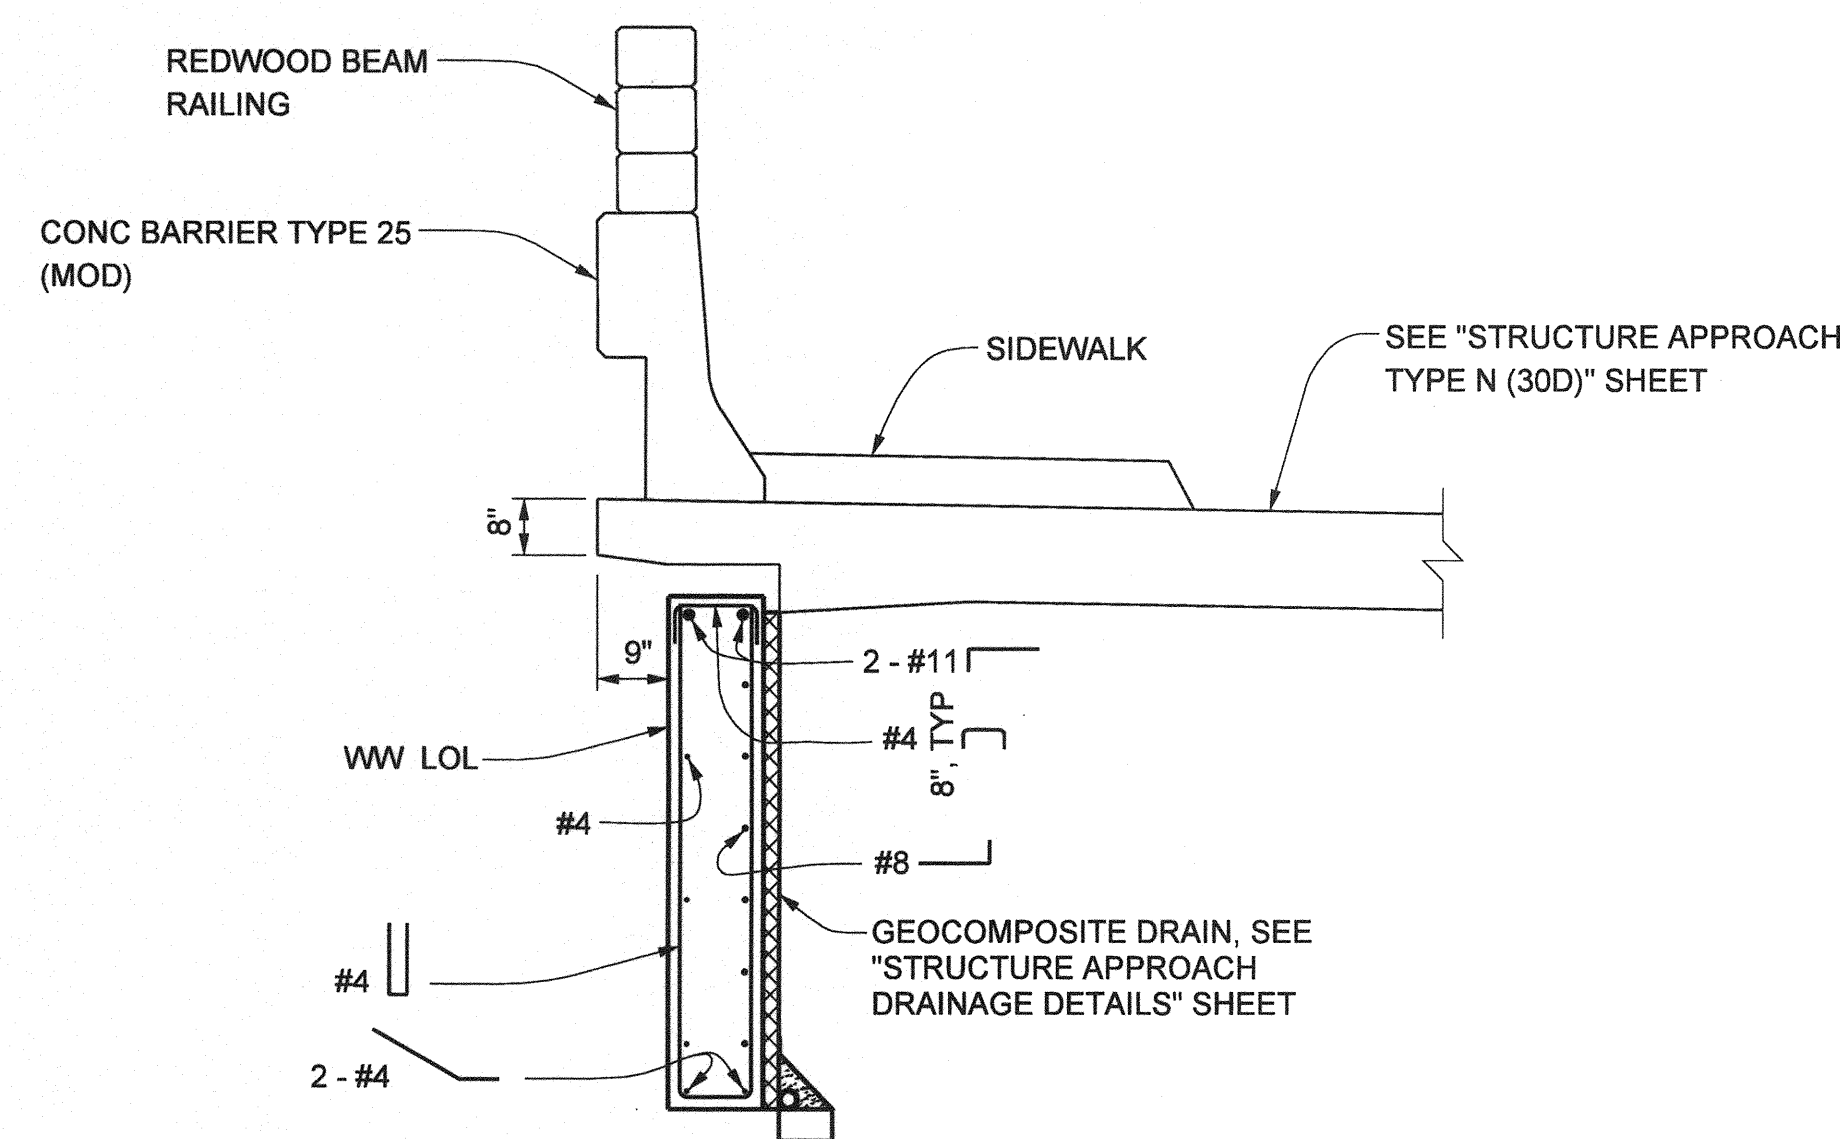

SECTION Q-Q


1/2" = 1'-0"

NOTE:

THE CONTRACTOR SHALL VERIFY ALL CONTROLLING FIELD DIMENSIONS BEFORE ORDERING OR FABRICATING ANY MATERIAL.

LEGEND

- BRIDGE REMOVAL (PORTION)
- DENOTES EXISTING STRUCTURE
- DENOTES NEW STRUCTURE

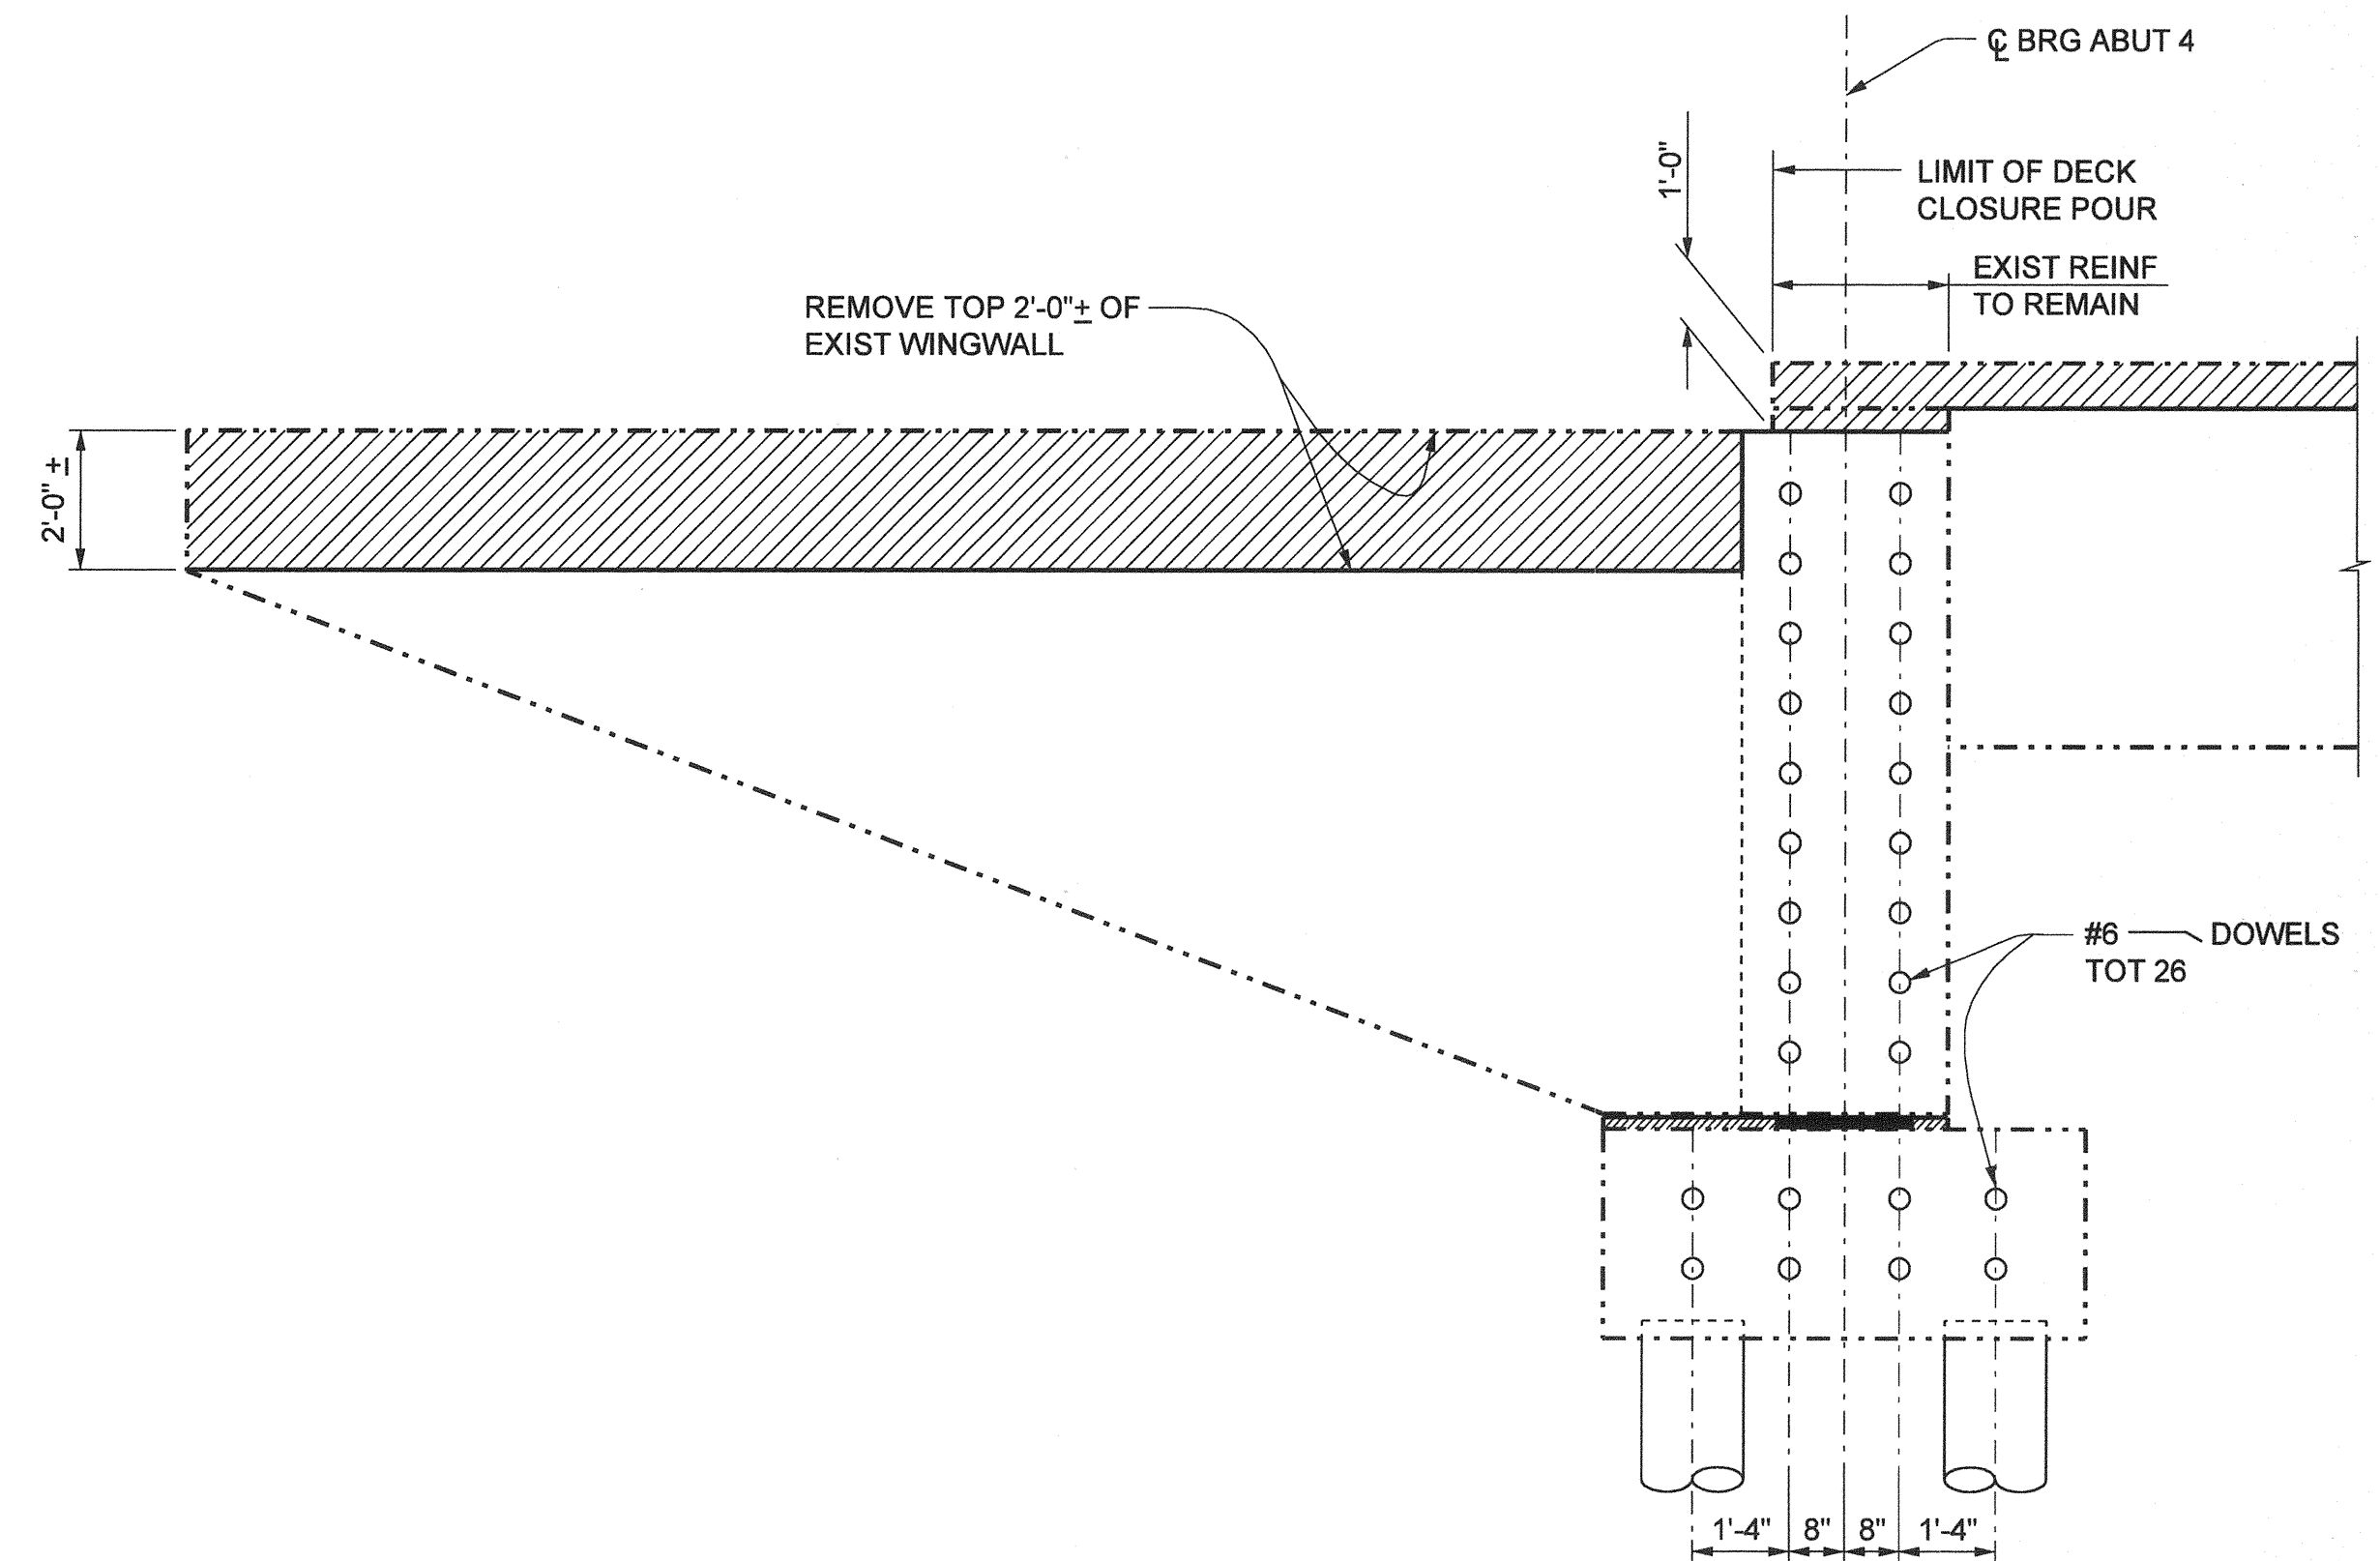

VIEW P-P

3/8" = 1'-0"

NO AS BUILT CHANGES

AS BUILT

CORRECTION BY: MN
CONTRACT NO.: ER28121
DATE: 12/30/2009

PLANS PREPARED BY: **HNTB**
HNTB Corporation
200 E. SANDPOINTE AVENUE, SUITE 200
SANTA ANA, CALIFORNIA 92707
TEL (714) 460-1600 FAX (714) 460-1610

ORANGE COUNTY RESOURCES & DEVELOPMENT MANAGEMENT DEPT		ANTONIO PARKWAY WILDLIFE UNDERCROSSING (WIDEN)		ABUTMENT 4 DETAILS	
DESIGNED <u>J. WANG</u>		CHECKED <u>F. JEANG</u>		SHEET 52 OF 72	
DRAWN <u>J.A. WANG</u>		DATE <u>9/19/08</u>		DRAWING NO.	
SCALE <u>AS SHOWN</u>		DATE <u>9/19/08</u>		DRAWING NO.	

REVISIONS

MARK	DATE	DESCRIPTION

PREPARED UNDER RESPONSIBLE CHARGE OF:

Yung-Nien Wang
Yung-Nien Wang
RCE C 43559 (EXP. 6-30-06)
CIVIL
10/31/06

Date Plotted:

File Name: J:\34092\CADD\Structs\AntonioParkway-S-11.dgn

Border sheet last modified 09-Nov-1999